



20+15

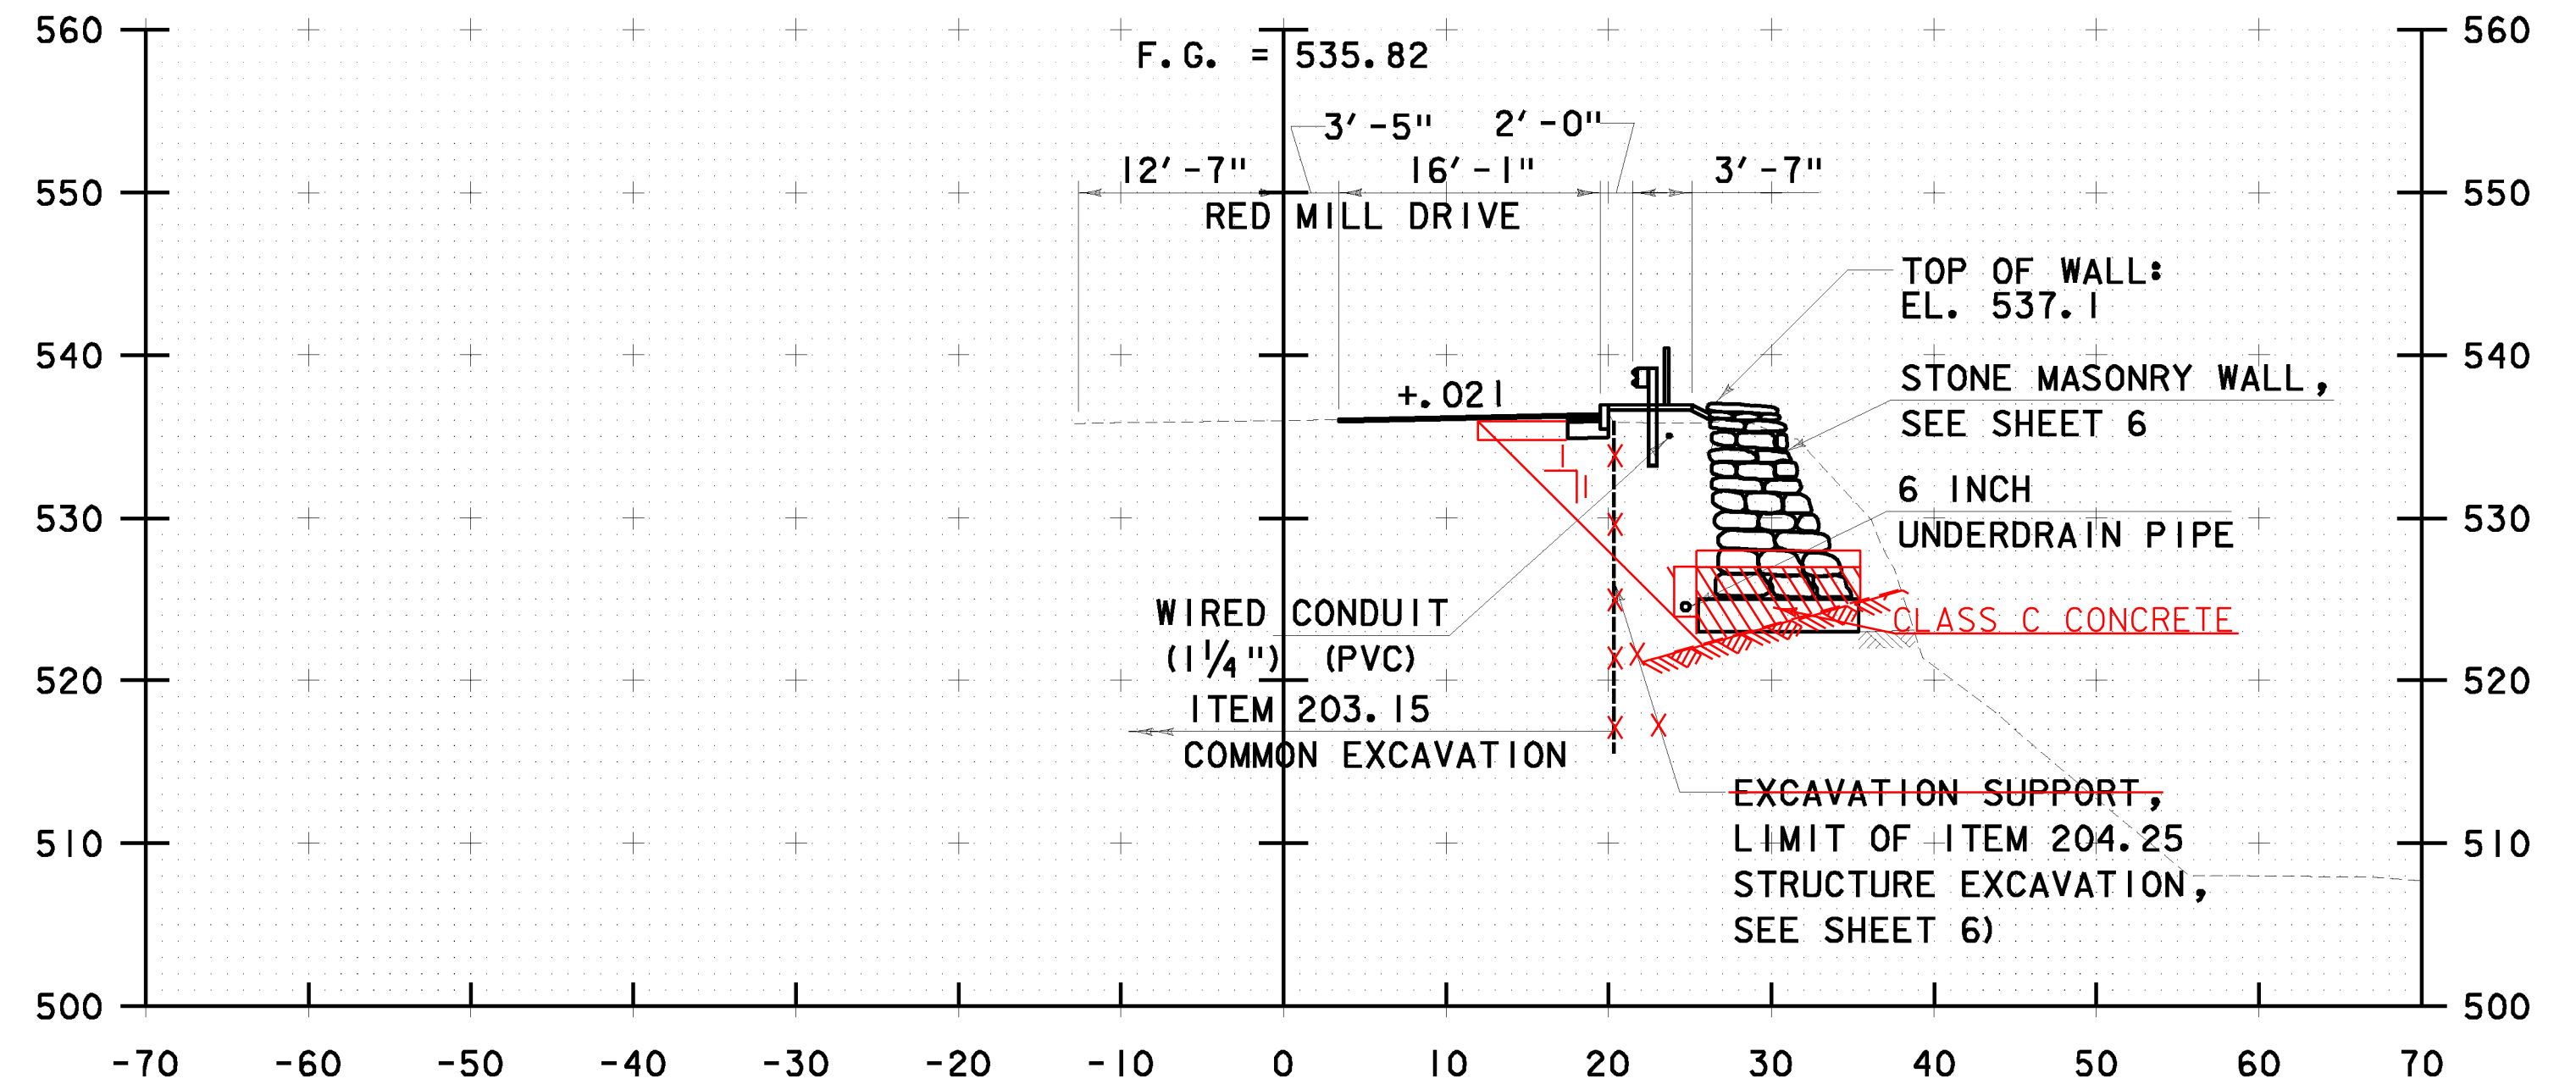


20+50

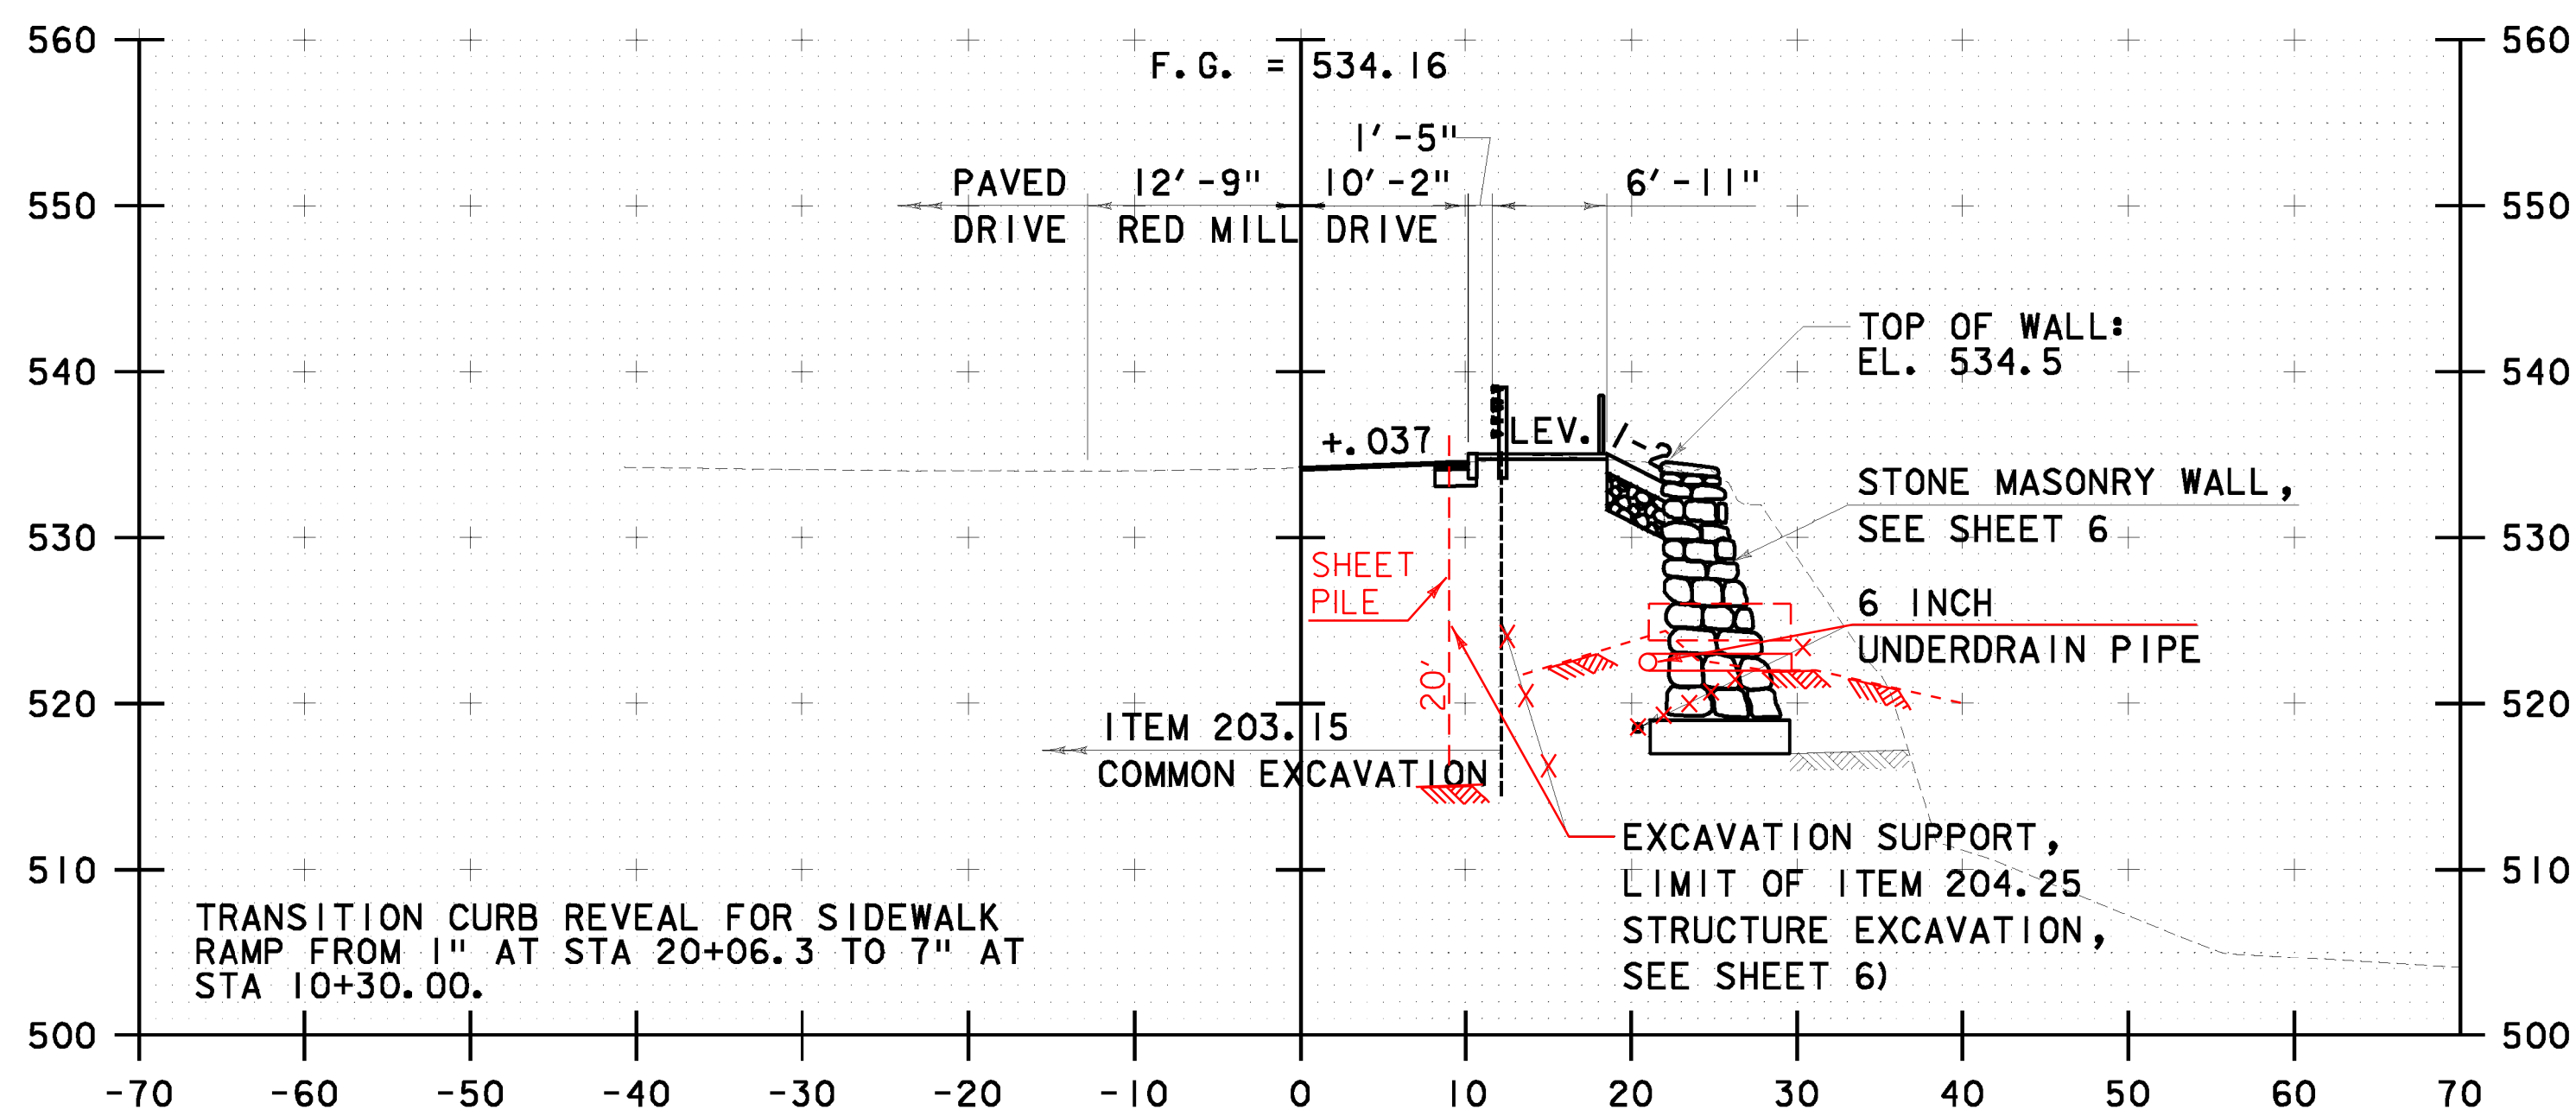

20+05

BEGIN RED MILL DRIVE STA 20+00  
BEGIN COLD PLANE AND OVERLAY STA 20+00

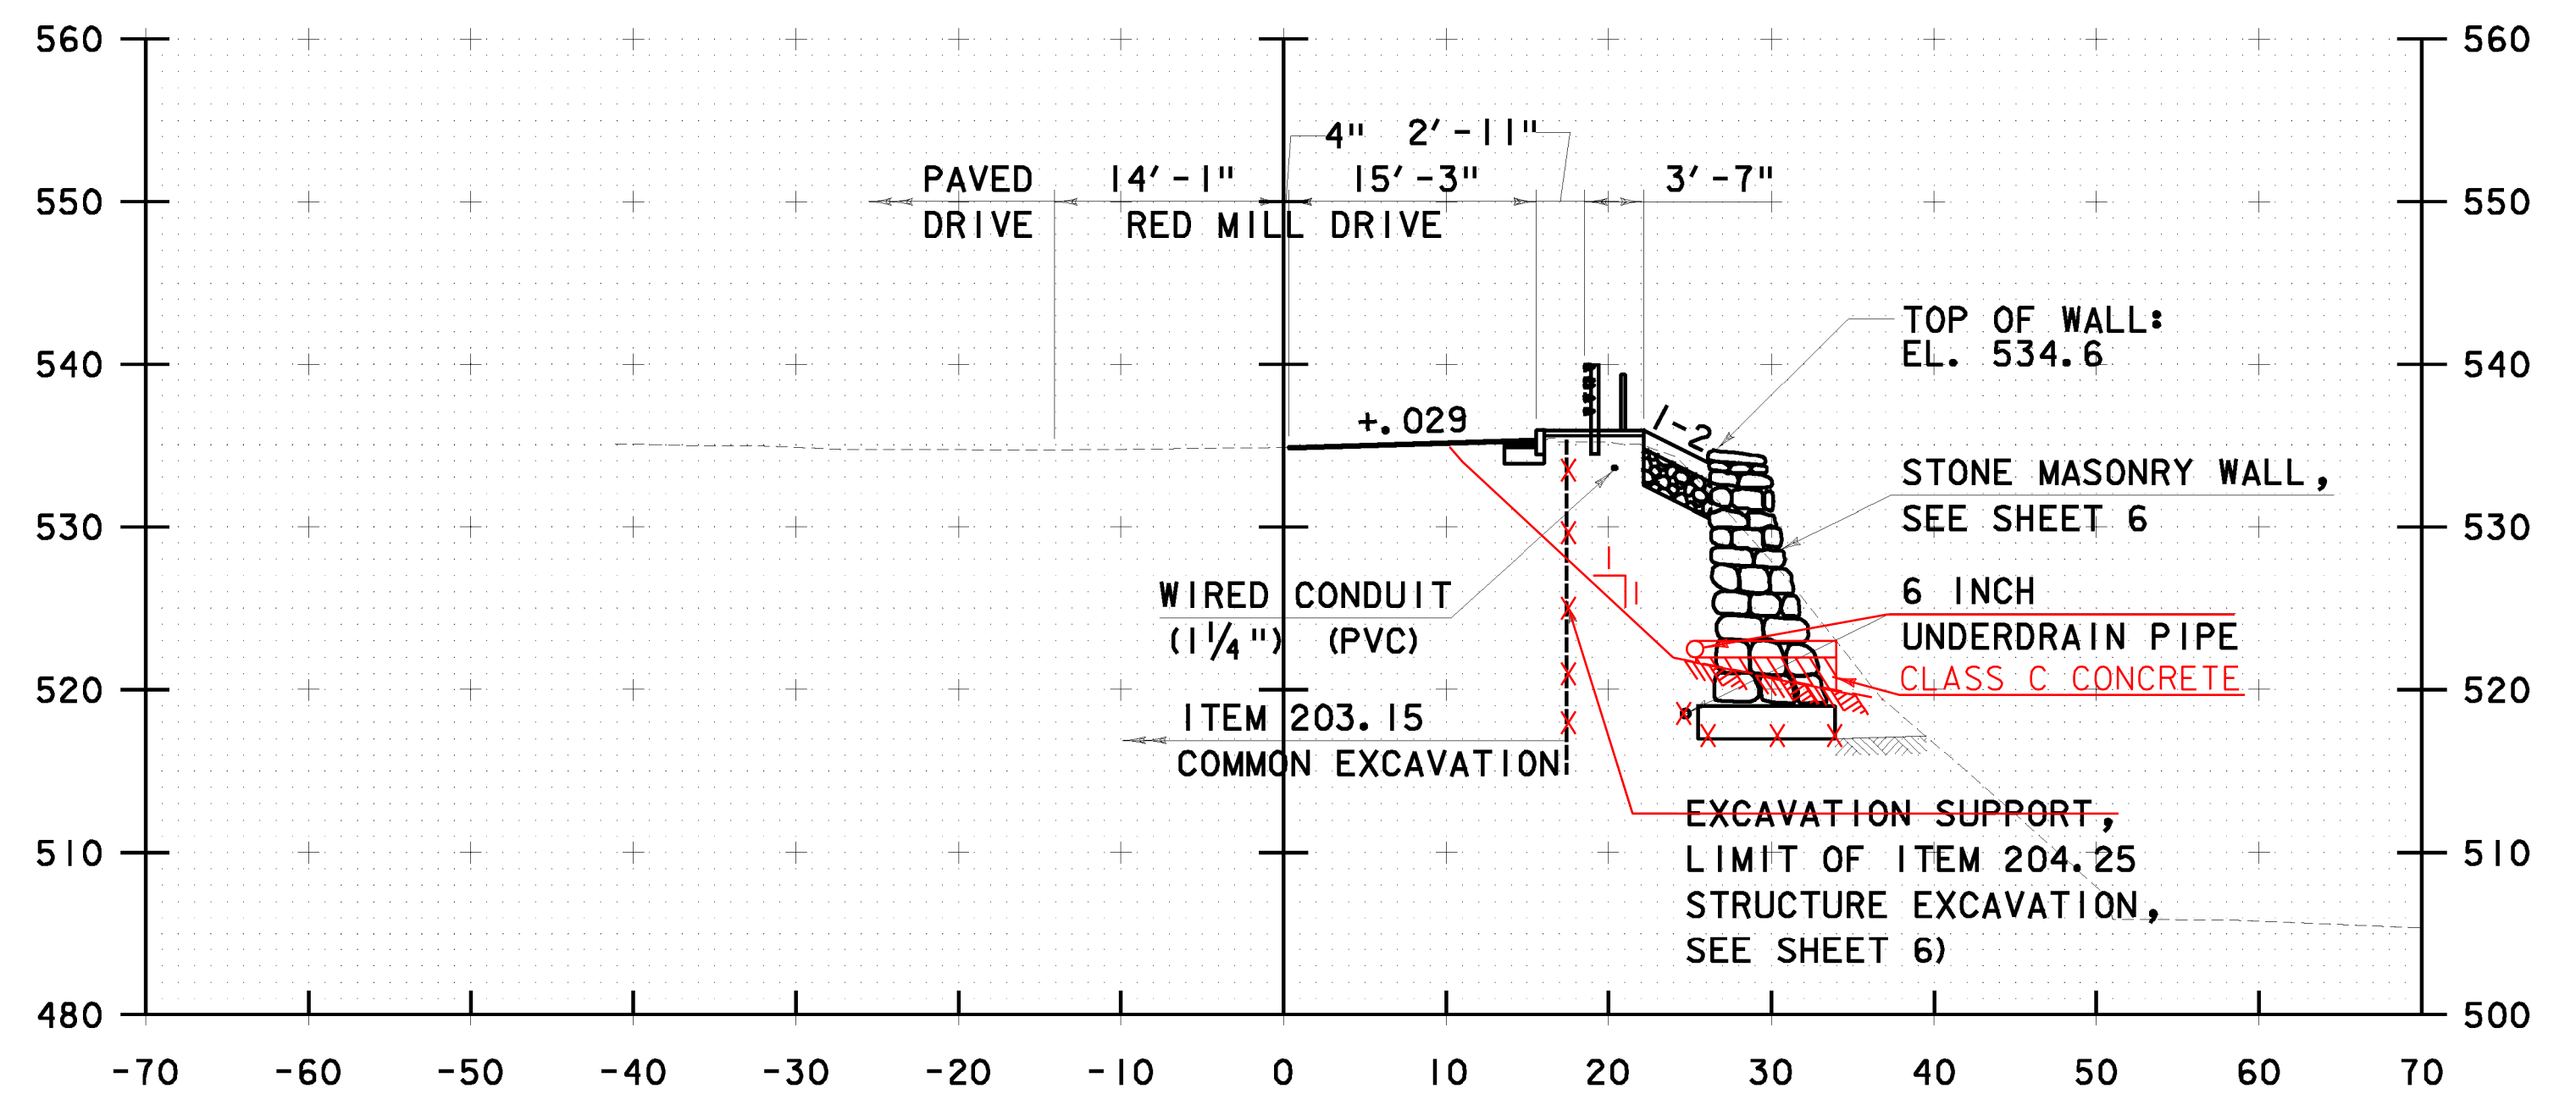

20+25

SCALE 1" = 10'-0"  
10 0 10



STA 20+05 TO STA 20+50

**RED MILL  
DRIVE CROSS  
SECTIONS #1**

PROJECT NAME: JERICHO  
PROJECT NUMBER: STP FTBR (3)

PROJECT LEADER: M.D.S.  
DESIGNED BY: C.R.H.  
DWG. NO.: RDXS-1

PLOT DATE: 4/7/2014  
DRAWN BY: C.R.H.  
CHECKED BY: D.E.G.  
SHEET 48 OF 62

FILE NAME: V:\Projects\ANY\K2\21113\CA00\MSTN\08F004\Consultants\08F004RWKSI.dgn  
DATE/TIME: 4/7/2014  
USER: d496