


20+66.50  
 END COLD PLANING AND PAVING  
 STA 20+66.50



20+60

SCALE 1" = 10'-0"  
 10 0 10

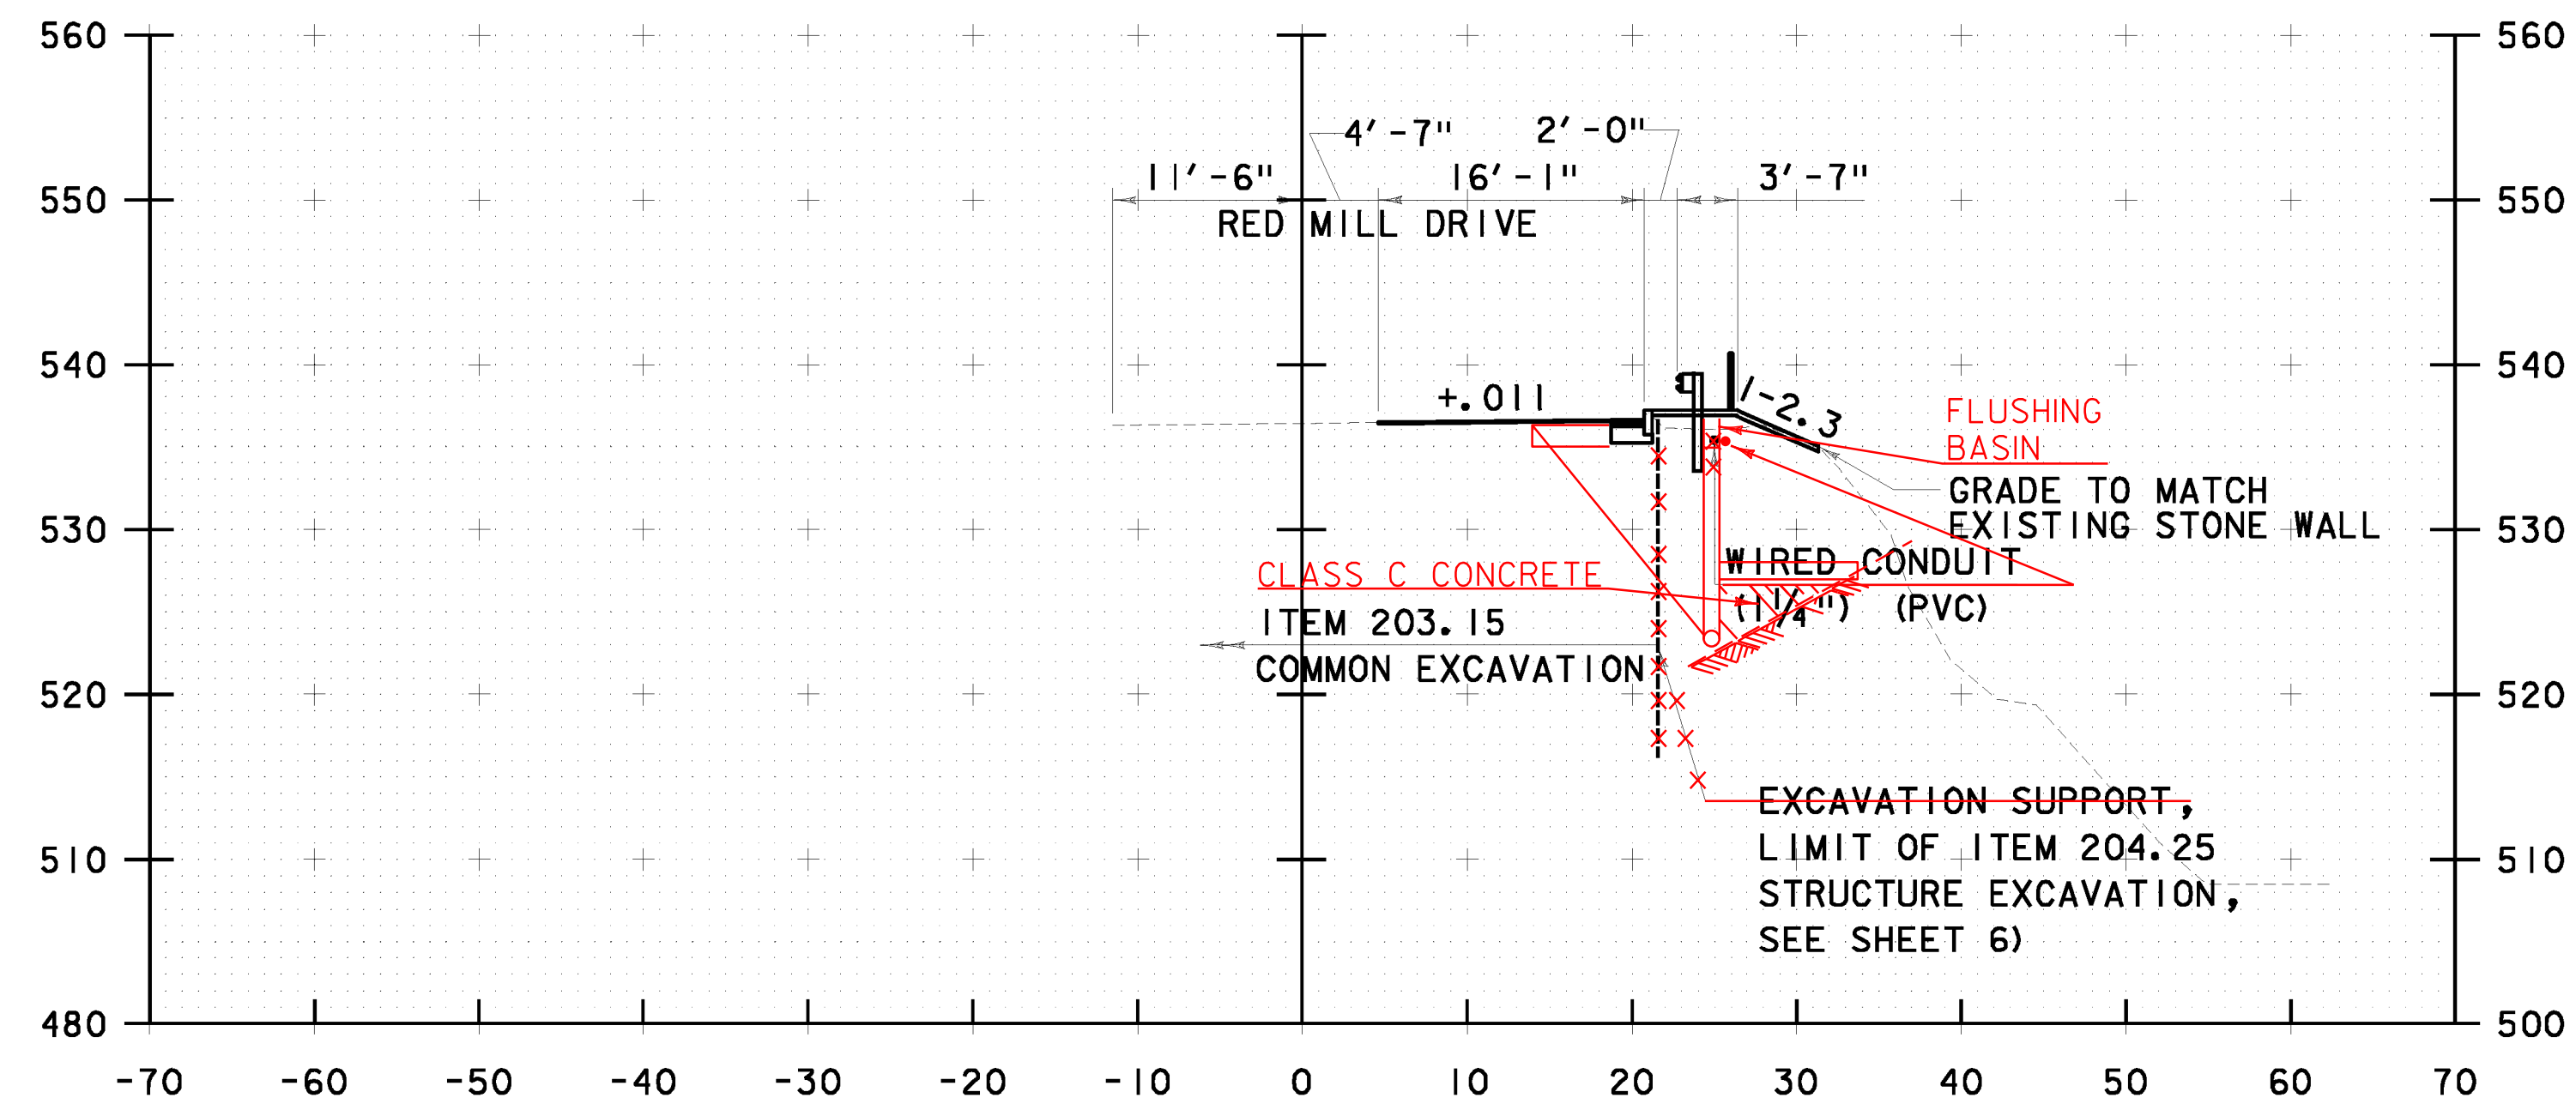

**RED MILL  
 DRIVE CROSS  
 SECTIONS #2**

PROJECT NAME: JERICO  
 PROJECT NUMBER: STP FTBR (3)

PROJECT LEADER: M.D.S.  
 DESIGNED BY: C.R.H.  
 DWG. NO.: RMXS-2

PLOT DATE: 4/7/2014  
 DRAWN BY: C.R.H.  
 CHECKED BY: D.E.G.  
 SHEET 49 OF 62

STA 20+60 TO STA 20+66.50