


0+75



0+50

SCALE 1" = 10'-0"

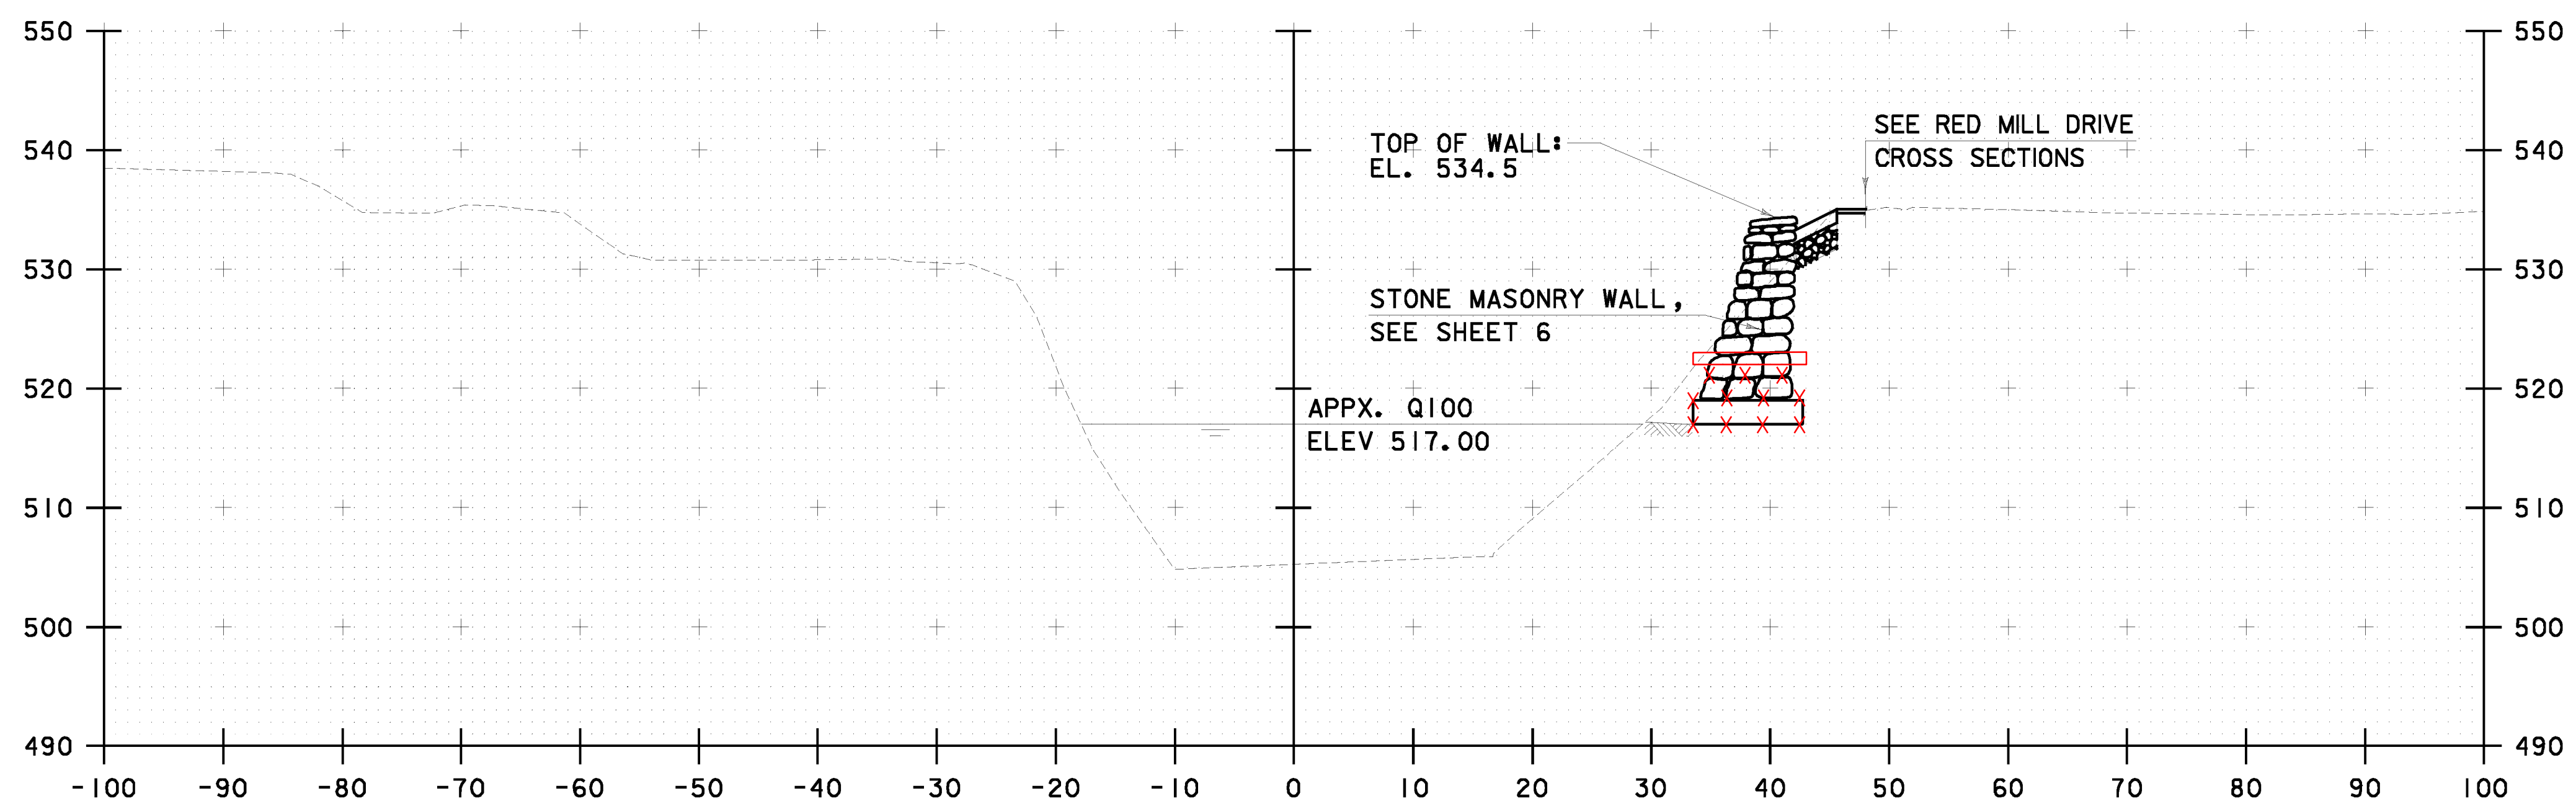

**CHANNEL
 CROSS
 SECTIONS #2**

PROJECT NAME: JERICO
 PROJECT NUMBER: STP FTBR (3)

PROJECT LEADER: M.D.S.
 DESIGNED BY: C.R.H.
 DWG. NO.: CHANXS-2

PLOT DATE: 4/7/2014
 DRAWN BY: C.R.H.
 CHECKED BY: D.E.G.
 SHEET 51 OF 62

STA 0+50 TO STA 0+75