


I+25

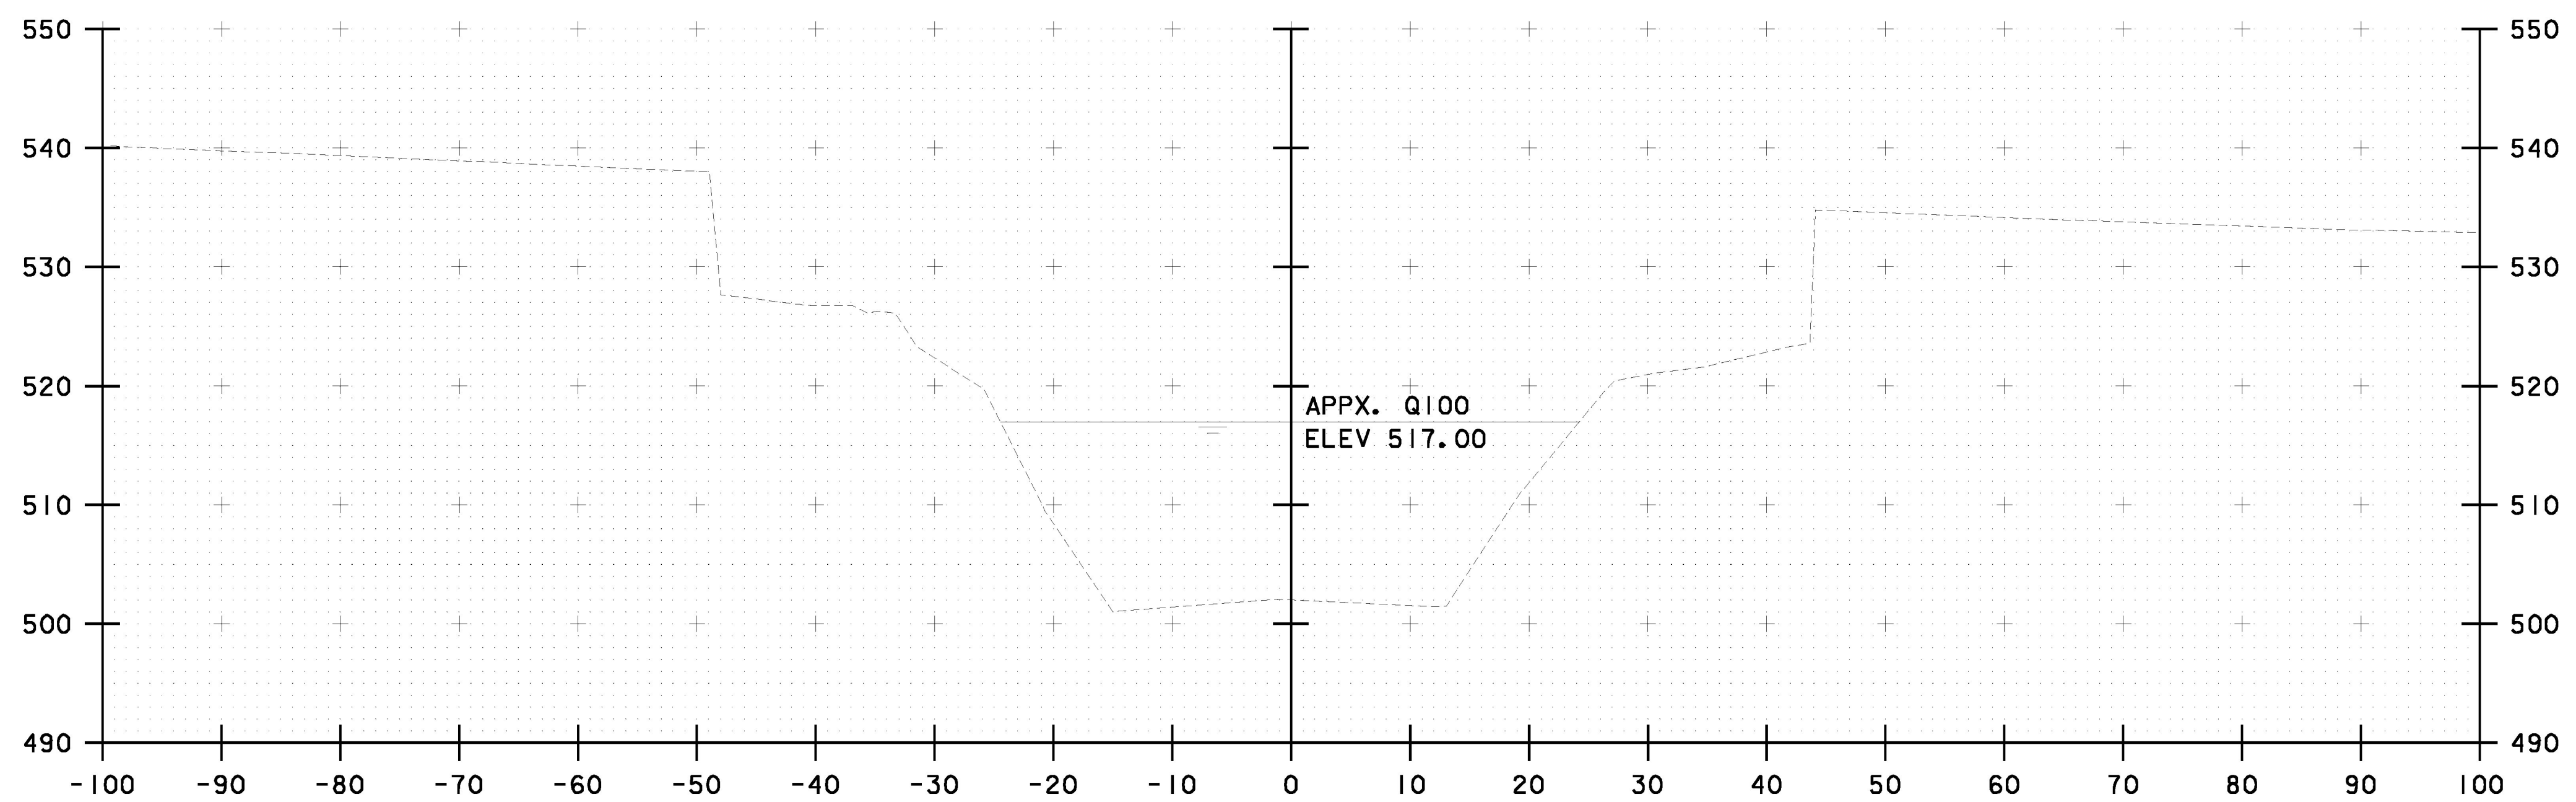

I+00

STA I+00 TO STA I+25

SCALE 1" = 10'-0"
 10 0 10



**CHANNEL
 CROSS
 SECTIONS #3**

PROJECT NAME: JERICO
 PROJECT NUMBER: STP FTBR (3)

PROJECT LEADER: M.D.S.
 DESIGNED BY: C.R.H.
 DWG. NO.: CHANXS-3

PLOT DATE: 4/7/2014
 DRAWN BY: C.R.H.
 CHECKED BY: D.E.G.
 SHEET 52 OF 62