

END RED MILL DRIVE
POE STA 21+25.00

END COLD PLANING AND PAVING
STA 20+66.50, RT


BEGIN PROJECT
STA 10+15.30

BEGIN APPROACH
PEDESTRIAN BRIDGE/SIDEWALK
POT STA 10+07.00
= BEGIN RED MILL DRIVE
POB STA 20+00.00
 $\Delta = 90^{\circ}00'00''$

LIMITS OF SOIL
DISTURBANCE

LEGEND

(XXX)	SOIL MAP UNIT TYPE (SEE SHEET 54 FOR DETAILS)
---	SOIL MAP UNIT BOUNDARY
---	0.00 FLOODPLAIN BOUNDARY
---	RIPARIAN BUFFER
[Cross-hatched box]	AREA OF SEED, MULCH, & TOPSOIL
[Dotted box]	AREA OF SEED, & EROSION MATTING
[Diagonal hatched box]	AREA OF STONE FILL, TYPE II
---XXX---	PROPOSED MAJOR CONTOUR (5' INTERVAL)
---	PROPOSED MINOR CONTOUR (1' INTERVAL)
---XXX---	EXISTING MAJOR CONTOUR (5' INTERVAL)
---	EXISTING MINOR CONTOUR (1' INTERVAL)

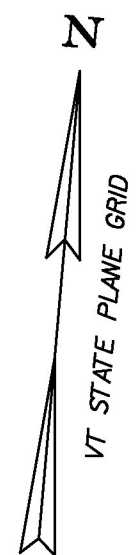

VT 15 (JERICHO ROAD) TO ESSEX

LIMITS OF SOIL
DISTURBANCE

END PROJECT
STA 11+82.00

END BRIDGE
STA 11+06.00

BEGIN BRIDGE
STA 10+34.00

PROPOSED ROW

VT 15 (JERICHO ROAD)
TO UNDERHILL
END APPROACH
STA 11+73.00

SCALE 1" = 10'-0"
10 0 10



**EROSION CONTROL
FINAL
CONDITION
PLAN**

PROJECT NAME: JERICHO
PROJECT NUMBER: STP FTBR (3)

PROJECT LEADER: M.D.S.
DESIGNED BY: C.R.H.
DWG. NO.: EROFIN-1

PLOT DATE: 4/8/2014
DRAWN BY: C.R.H.
CHECKED BY: D.E.G.
SHEET 58 OF 62

FILE NAME = V:\Projects\ANY\K2\21113\CADD\WSTN\08F00A\Cadd\ents\208F004.dwg
DATE/TIME = 4/8/2014
USER = 4079