




NEW BRIDGE TYPICAL ~ ALTERNATE C
SCALE: 3/8" = 1'-0"

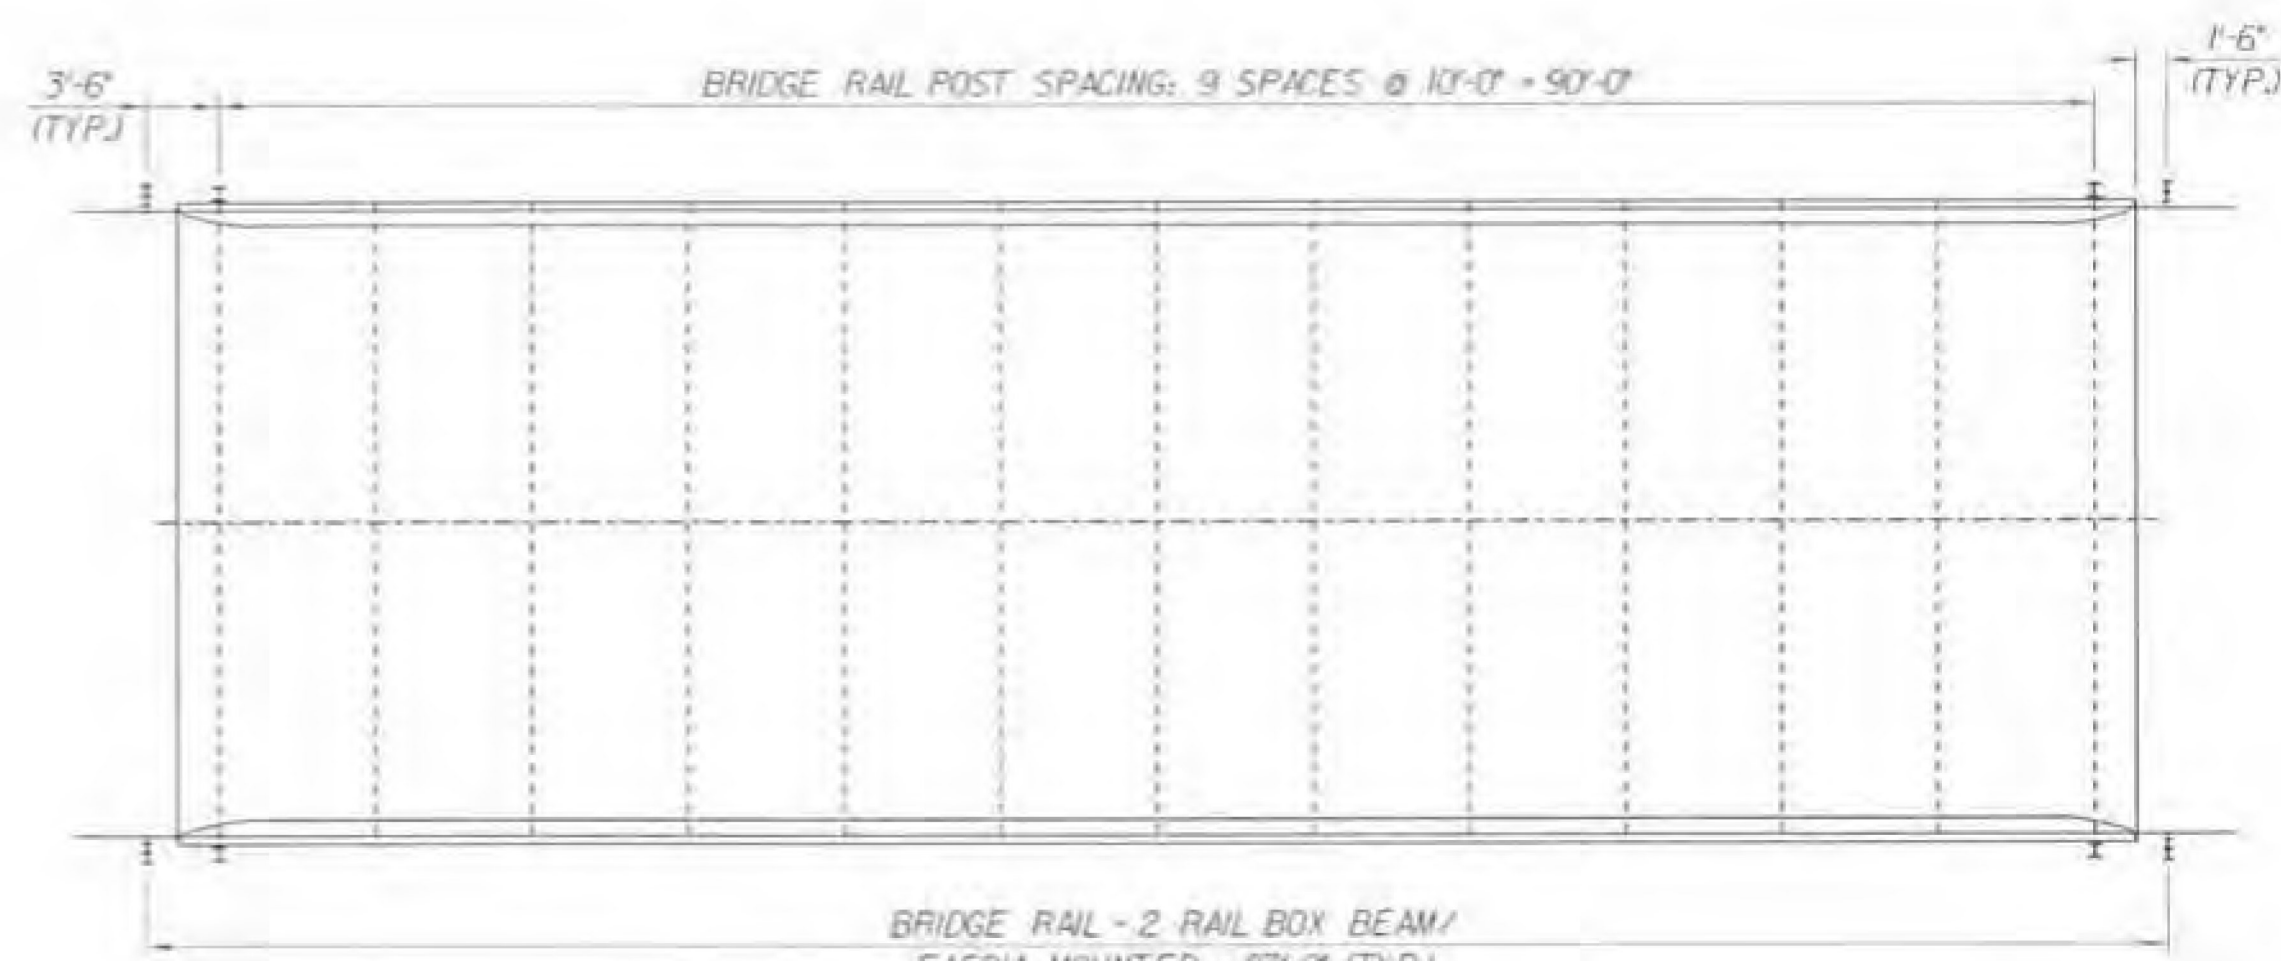

BRIDGE RAIL LAYOUT
SCALE: 1/8" = 1'-0"

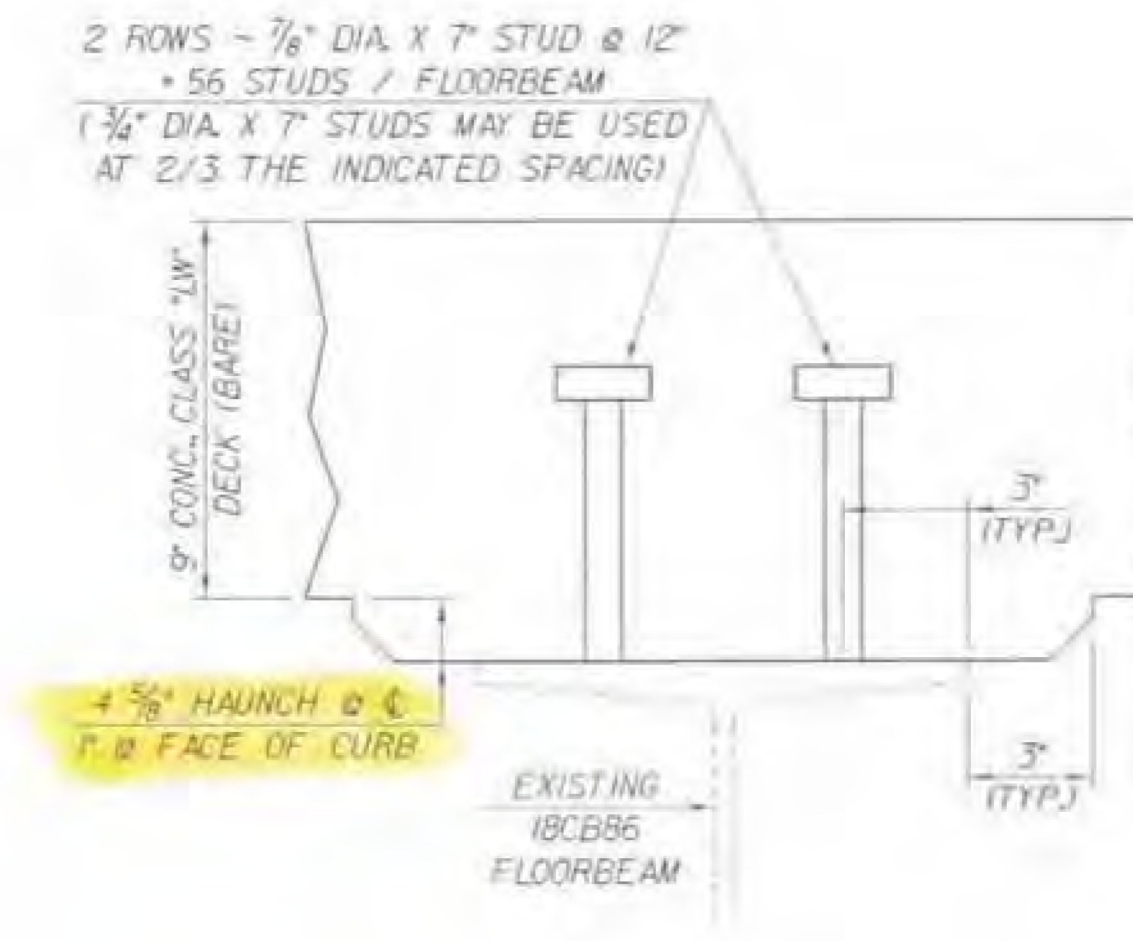

SHEAR CONNECTOR DETAIL
SCALE: 3" = 1'-0"

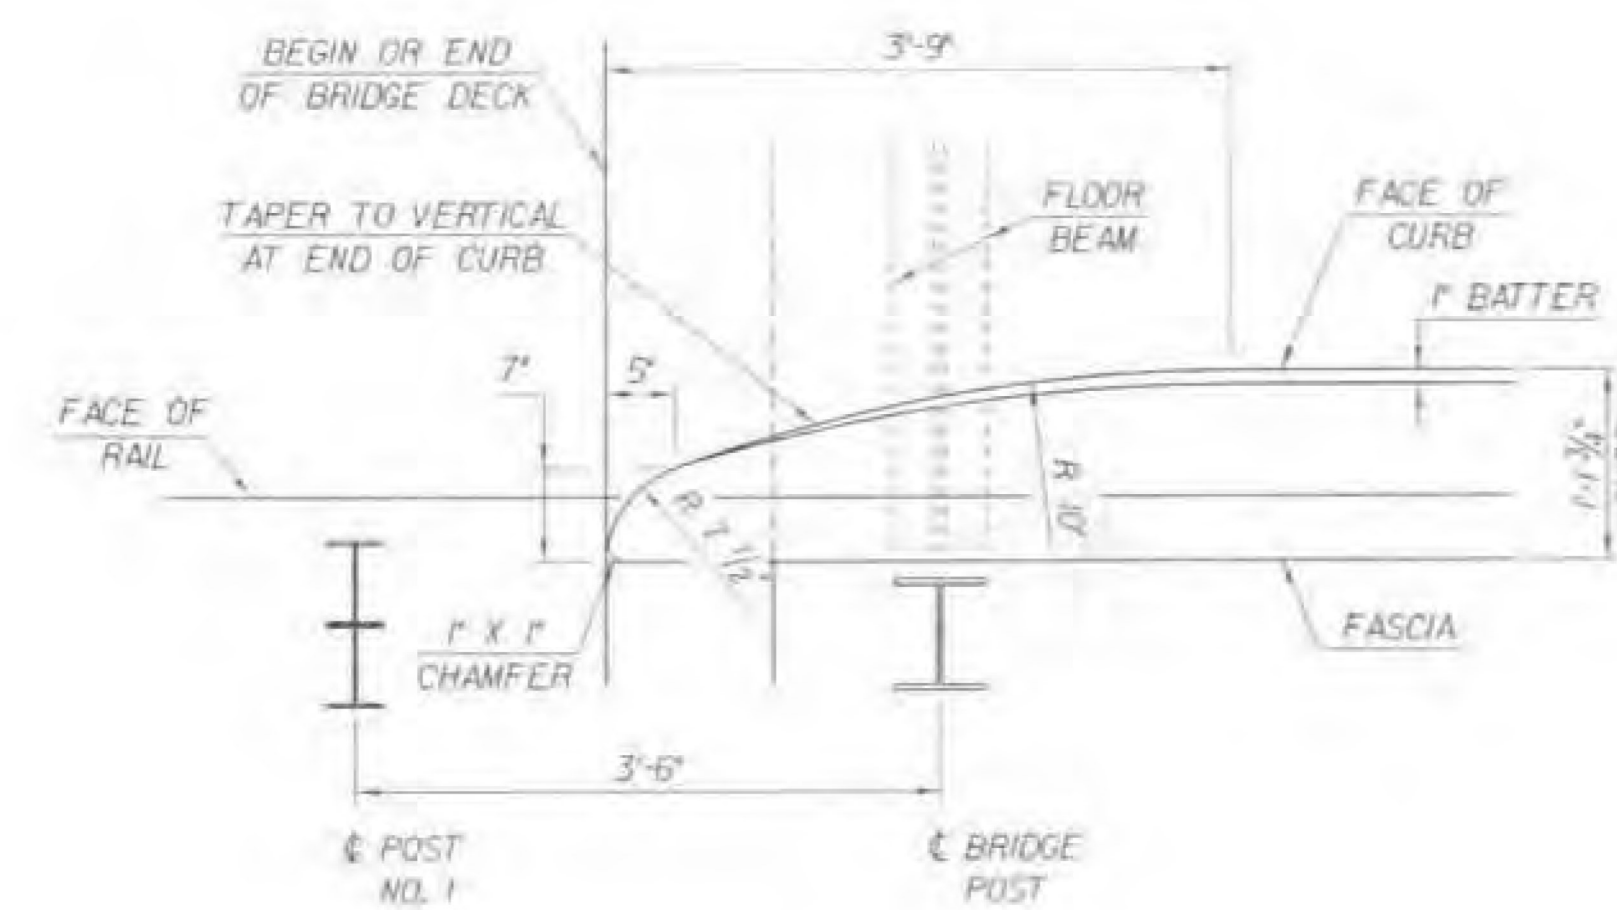

CURB TAPER DETAIL
SCALE: 1" = 1'-0"

BUILT AS DESIGNED

**STATE OF VERMONT
AGENCY OF TRANSPORTATION**

Town Of	JERICHO	Bridge No.	7
Highway No.	VT. 15	Log Sta.	20 + 44
		Surv. Sta.	5 + 98.30
VT. 15 OVER THE BROWNS RIVER			
NEW BRIDGE TYPICAL ALTERNATE C			
Designed By	D. HOYNE	Drawn By	G. ROY
Checked By	D. HOYNE	Bridge Design Supervisor	J.H. WEAVER
	Date 4/95	Date	4/95
PROJECT	JERICHO	PROJECT NO.	STP DECK (35)
LGC Info: /str3/94036/sr36c01		sr36c01	
Bridge Sheet No.		Sheet	23 of 36