




10-10
1-17
11-7
10-0
5-0

5+63
5

167.36
156.52
11.84
17.76

167.36
156.52
10.84

167.36
156.52
10.84

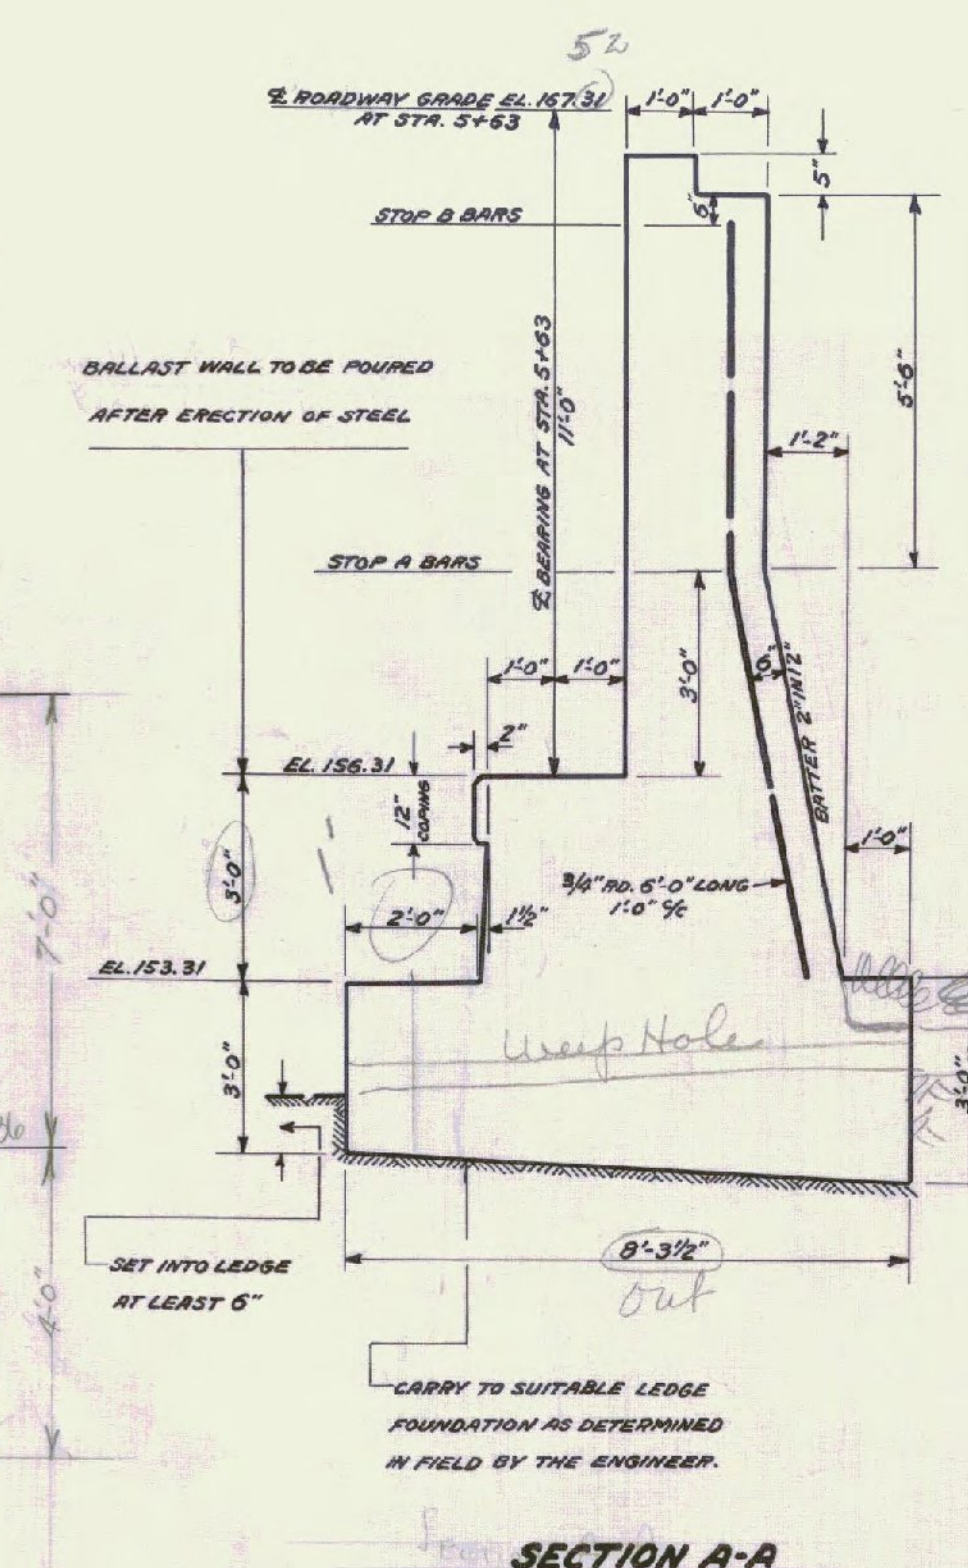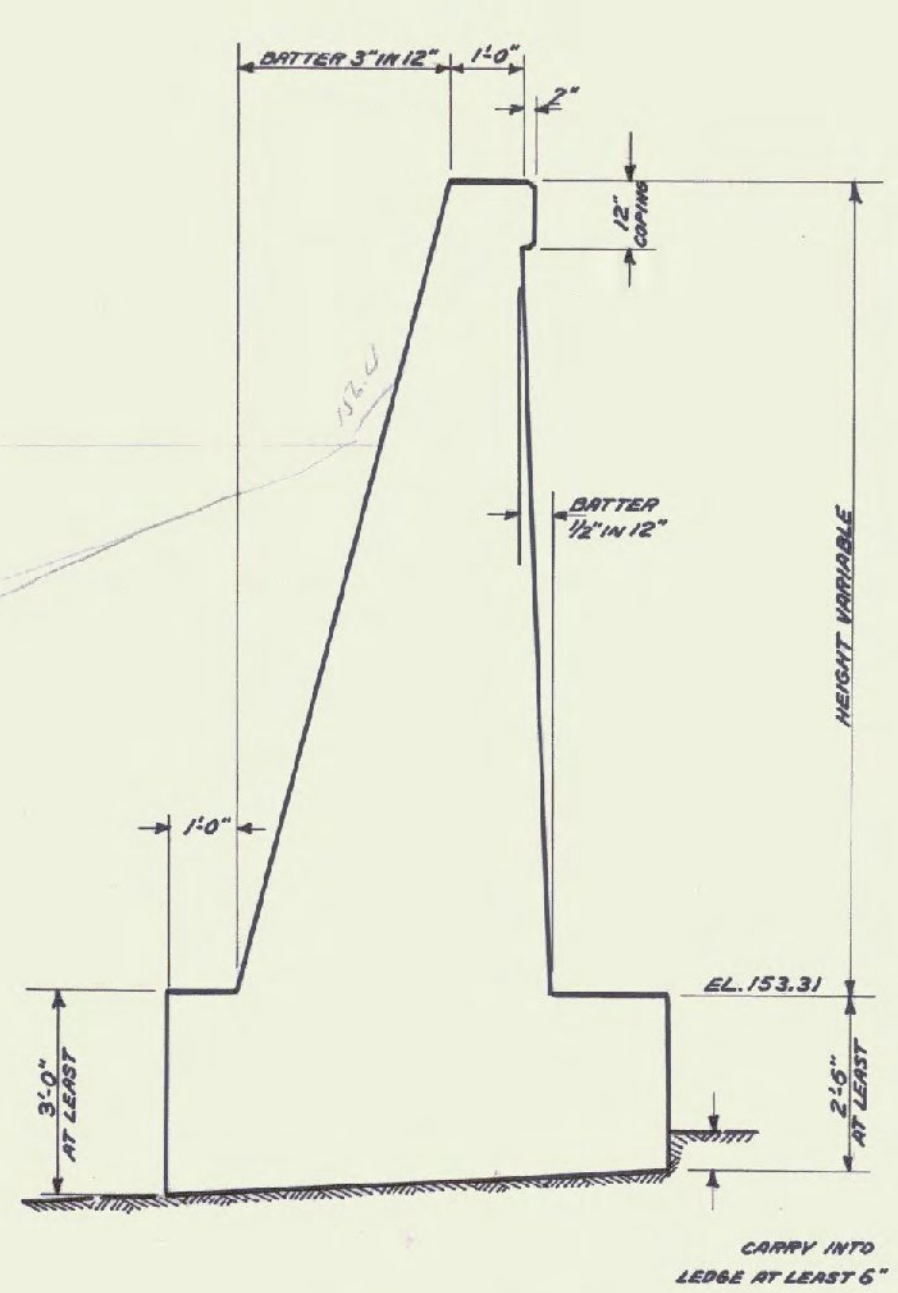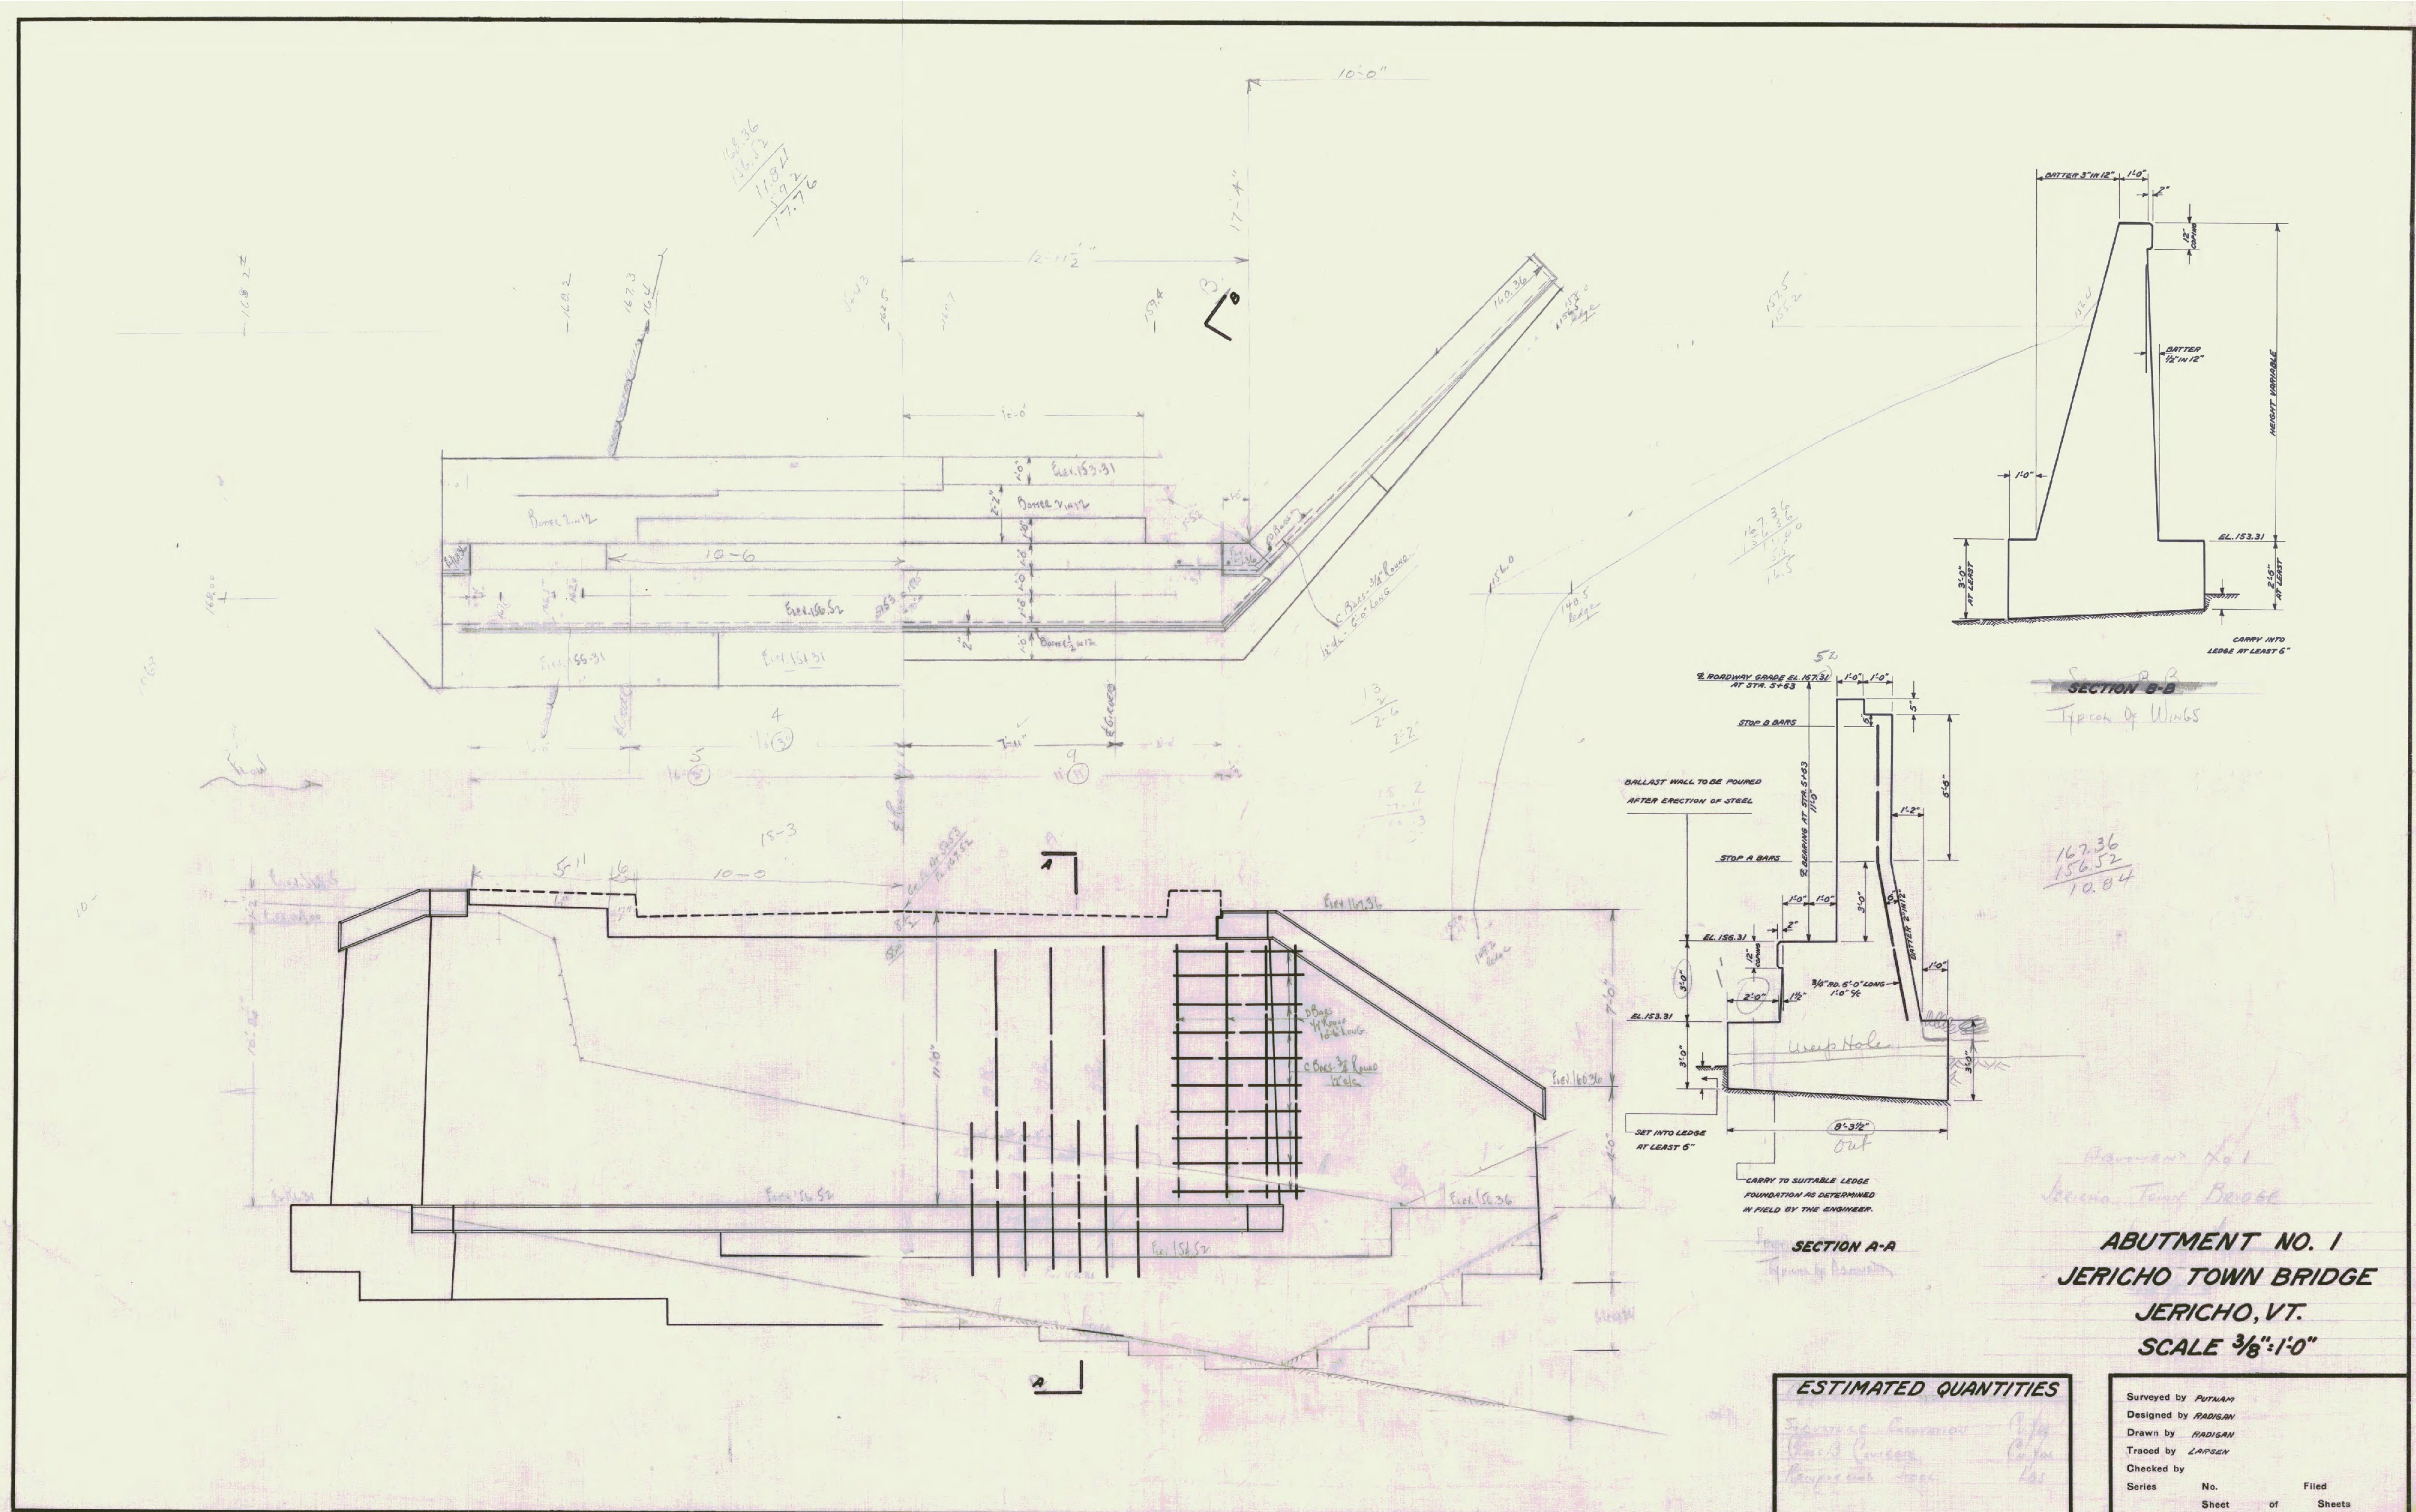

SECTION B-B
Typical of Wings

SECTION A-A
Typical of Abutment

Barren's Lot
Jericho Town Bridge

ABUTMENT NO. 1
JERICHO TOWN BRIDGE
JERICHO, VT.
SCALE 3/8"=1'-0"

ESTIMATED QUANTITIES	
Concrete	11.84
Reinforcing Steel	17.76
Ballast	10.84
Gravel	10.84
Other	

Surveyed by	PUTNAM	
Designed by	RADIGAN	
Drawn by	RADIGAN	
Traced by	LAFSEN	
Checked by		
Series	No.	Filed
	Sheet	of Sheets