


REFERENCES:-
 S.B. No 2, Details 5-204, 5-220, 5-221.
 S.B. No. 1, Details 510 (Modified)
 TOTAL LENGTH PLATE 28'-2" SIDEWALK
 DETAIL OMITTED.
 ALL GRAVITY SECTIONS AND FOOTINGS TO BE CLASS B CONCRETE. BALLAST WALL TO BE CLASS C CONCRETE.

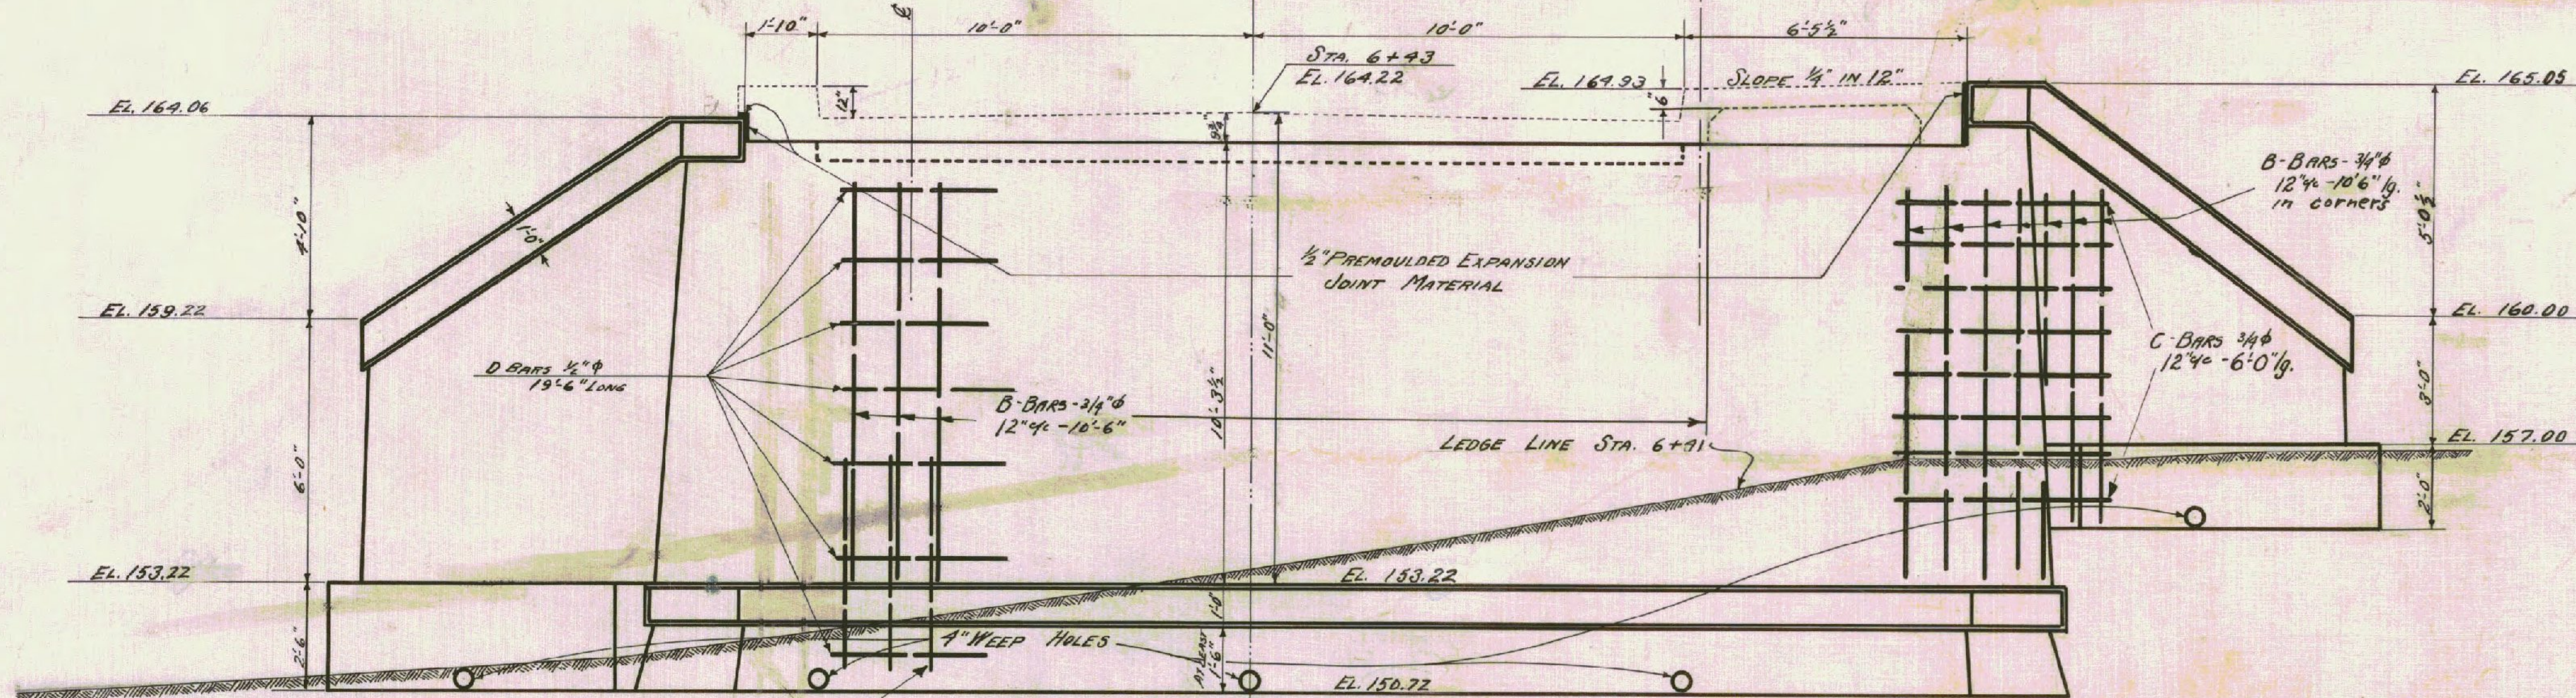

NOTE:-
 ENGINEER MAY RAISE OR LOWER ELEVATION OF FOOTINGS TO FIT LEDGE CONDITIONS FOUND IN FIELD.

**ABUTMENT NO. 2
 JERICHO TOWN BRIDGE
 JERICHO, VT.
 SCALE: 3/8"=1'-0"**

ESTIMATED QUANTITIES	
Structure Excavation	53 Cu. Yds.
Concrete Class "B" (1:2 1/2:5)	43 Cu. Yds.
Concrete Class "C" (1:2:4)	16 Cu. Yds.
Reinforcing Steel	1000 Lbs.

Surveyed by	PURMAN 3-6-29
Designed by	M.N.D. 4-13-29
Drawn by	M.N.D. 4-23-29
Traced by	W.G.B. 4-15-29
Checked by	P.M.S. 5-3-29
Series	F No. 98B
Filed	
Sheet 9 of 15 Sheets	