


Wanted
 10 Lateral Pls Mark TP1 } C.O. 168A.
 10 " " " BPI
 4 " " " TP2

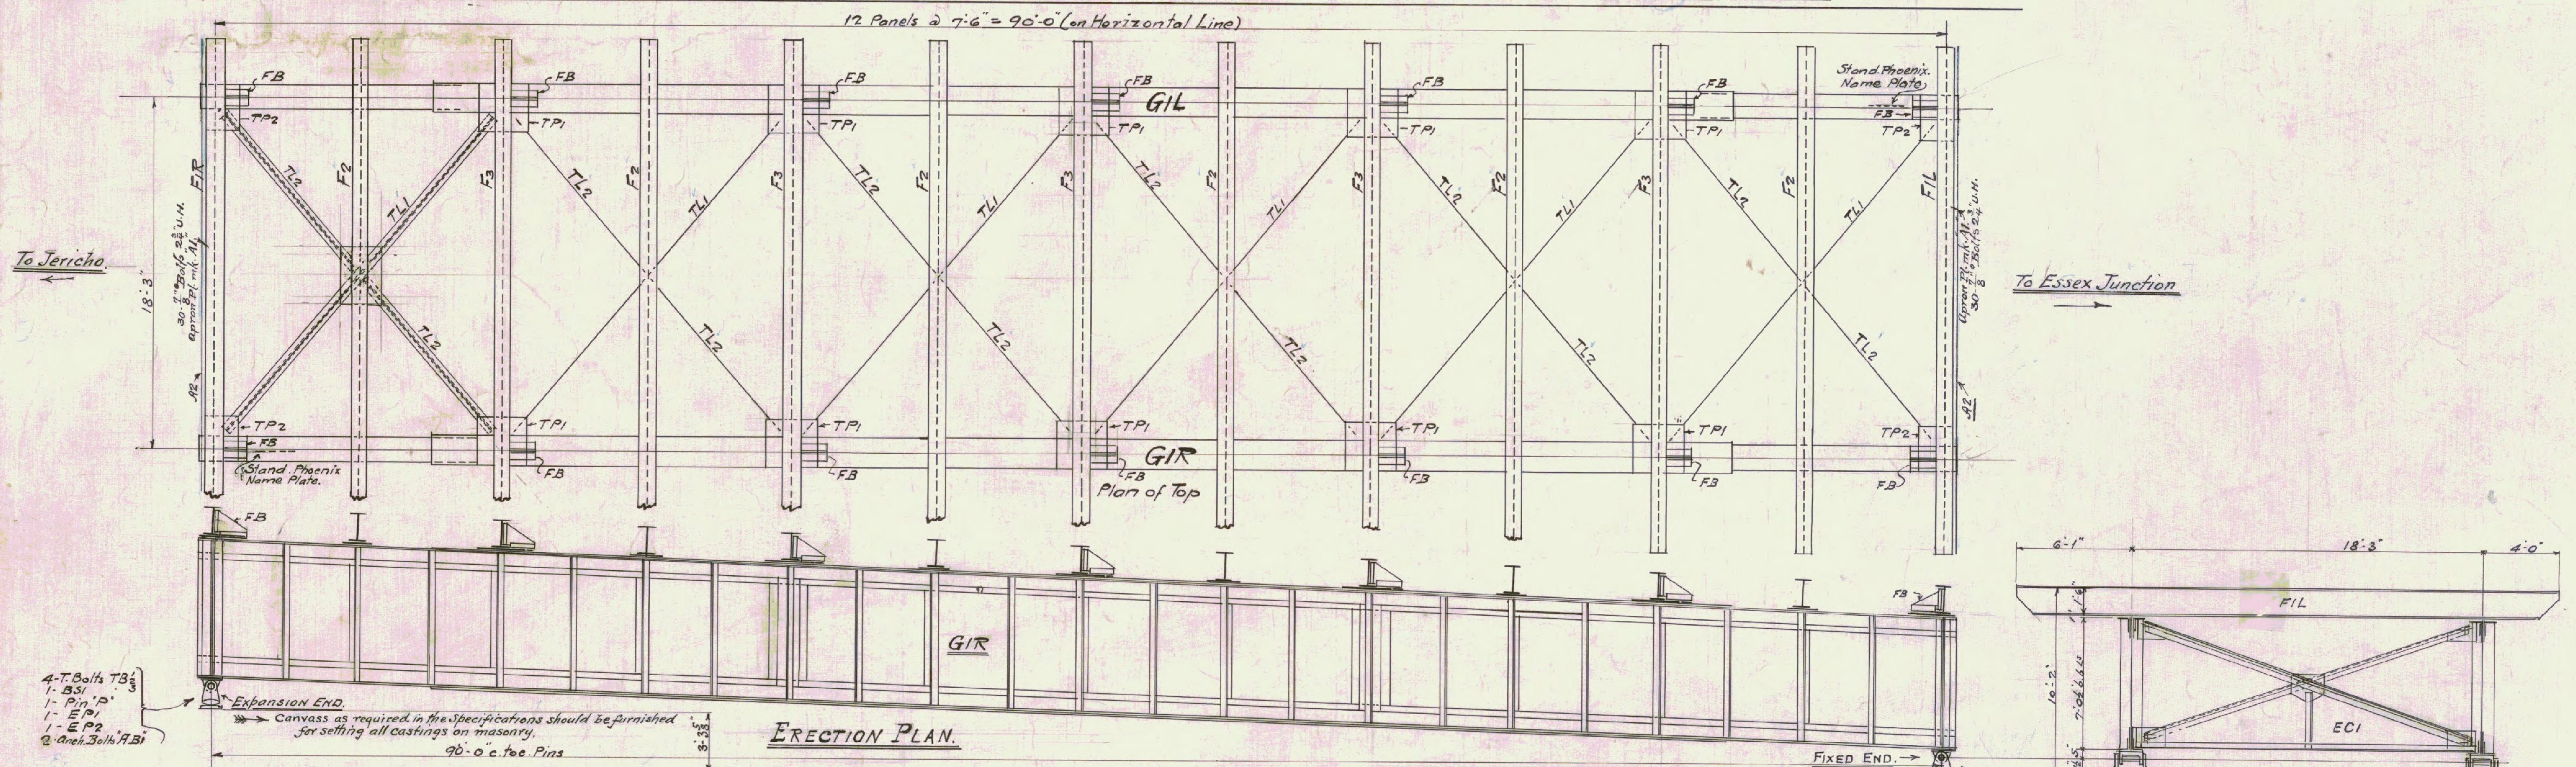

List of Drawings
 Draw No 1 Girders
 " " 2 Bearings, Floorbeams & Bracing
 " " 3 Gusset Plates & Erection Diagram

GENERAL NOTES
 SPECIFICATIONS: A. S. T. M. SERIAL DESIGNATION
 MATERIAL: O. H. STRUCTURAL STEEL
 RIVETS: 7-8" RIVET STEEL
 RIVET AND OPEN HOLES PUNCHED FULL SIZE 15-
 SHOP PAINT: ONE COAT RED LEAD & OIL
 ALL EDGE DISTANCES NOT GIVEN: 1/2" LAS
 Revised as per letter ref. 6/9