

Round Light Pole Base (Order Form)

Customer: BLOW & COTE INC

Job Name: VAOT STP FTBR(3) ^{JERICHO}


Job #: 019-15

LPB#: #1

Date: 2/6/15

Notes: * VT AOT PROJECT
* REINFORCING PER ATTACHED
* STANDARD E-180 B


Bolt Pattern

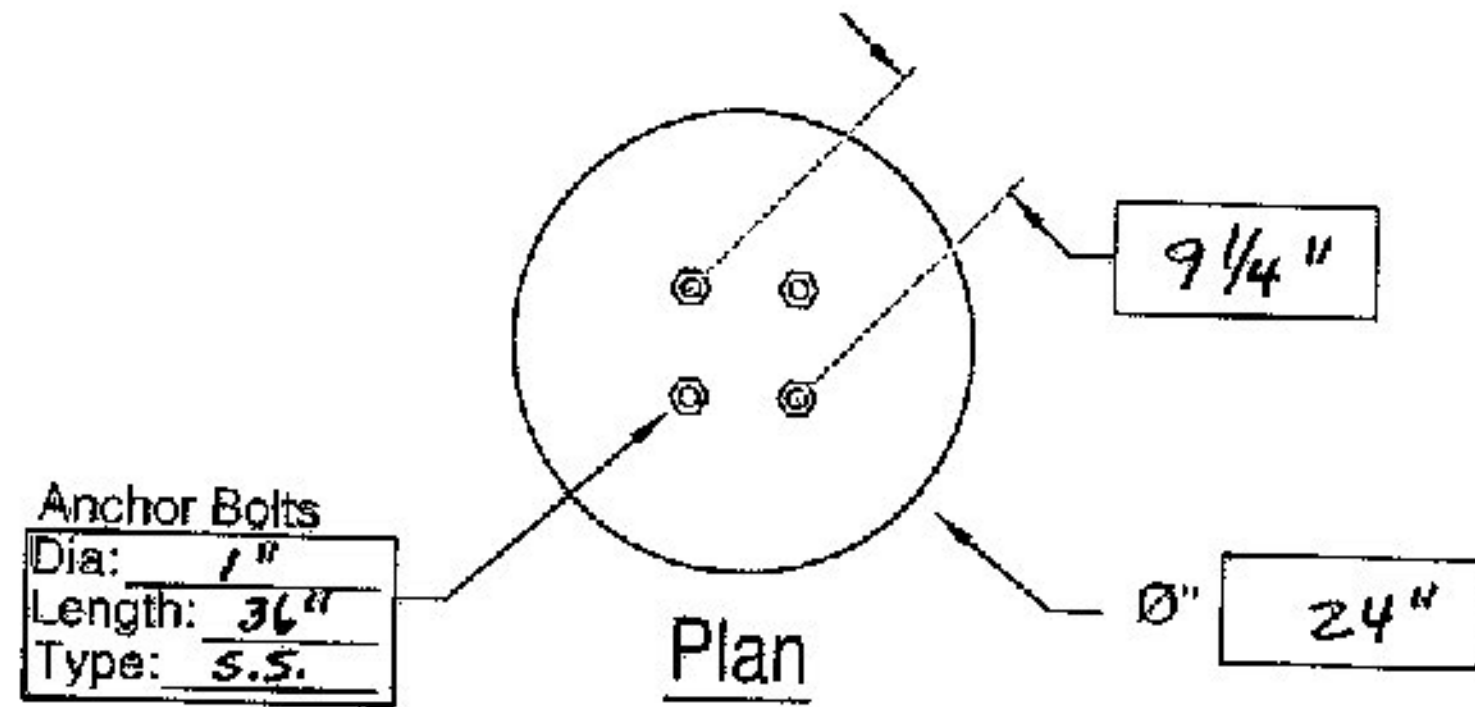

Conduit Pattern (Plan View)

- NO EXCEPTION TAKEN
- MAKE CORRECTIONS NOTED
- REJECTED
- REVISE AND RESUBMIT
- SUBMIT SPECIFIED ITEM

CHECKING IS ONLY FOR THE GENERAL CONFORMANCE WITH THE DESIGN CONCEPT OF THE PROJECT AND GENERAL COMPLIANCE WITH THE INFORMATION GIVEN IN THE CONTRACT DOCUMENTS. ANY ACTION SHOWN IS SUBJECT TO THE REQUIREMENTS OF THE PLANS AND SPECIFICATIONS. CONTRACTOR IS RESPONSIBLE FOR DIMENSIONS WHICH SHALL BE CONFIRMED AND CORRELATED AT THE JOB SITE; FABRICATION PROCESSES AND TECHNIQUES OF CONSTRUCTION; COORDINATION OF HIS WORK WITH THAT OF ALL OTHER TRADES AND THE SATISFACTORY PERFORMANCE OF THE WORK.

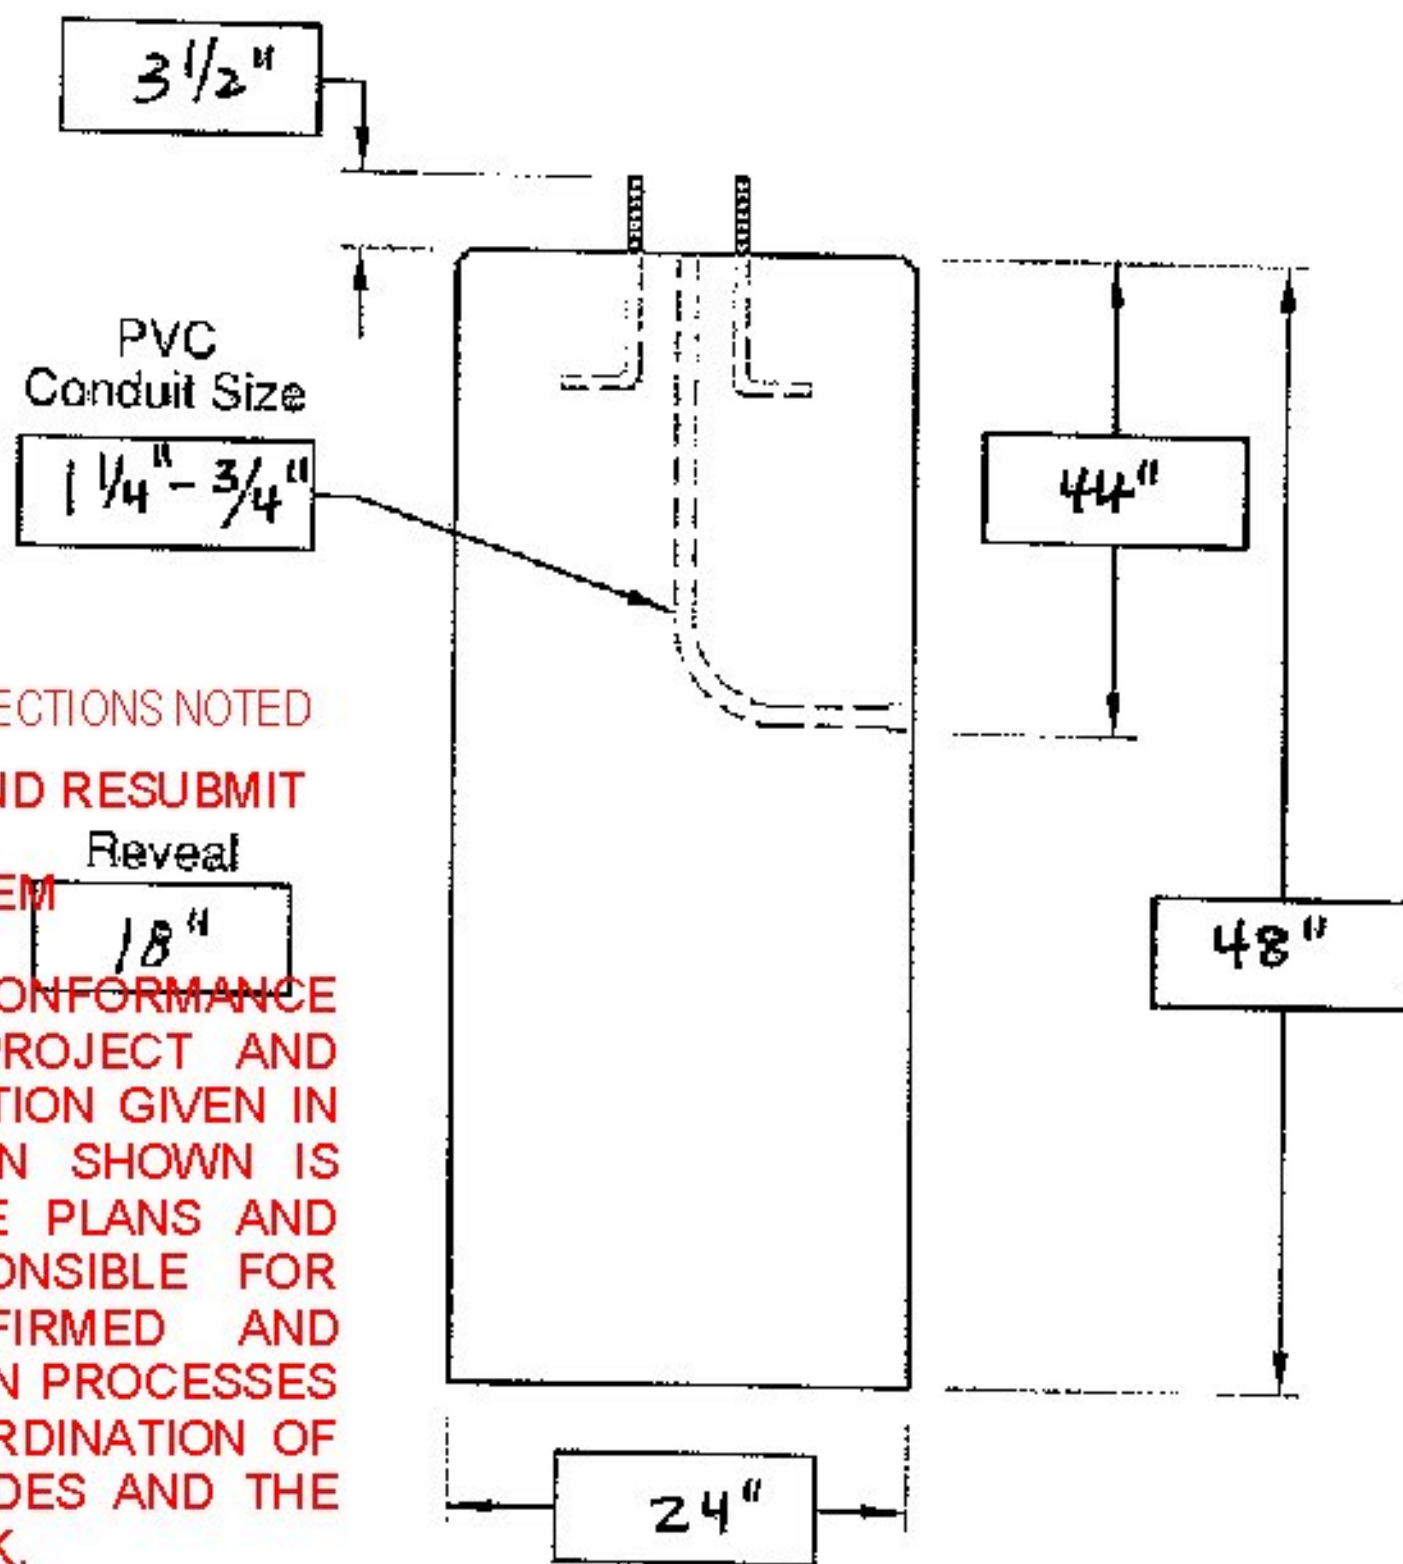

Section

CHA

DATE 3/19/2015 BY N. Bennett

IMPORTANT INFORMATION

Please be advised that all boxes must be completed in order for us to proceed with production of the Light Pole Base



PRECAST CONCRETE PRODUCTS
 73 PRECAST ROAD MILTON, VT 05468 • 802.893.2401
 TOLL FREE 1.888.259.2401 FAX 802.893.1542