


SHIPPING LIST						
MARK:	QTY:	DESCRIPTION:	LENGTH:	REMARK:	WGT:	TOTAL:
3D1	6	C15X33.9	4'-1 1/2"		138	831
4S1	1	W30x99	71'-5 11/16"	CVN, FCM	7,271	7,271
5S2	1	W30x99	71'-5 11/16"	CVN, FCM	7,271	7,271
	8				TOTAL:	15,373

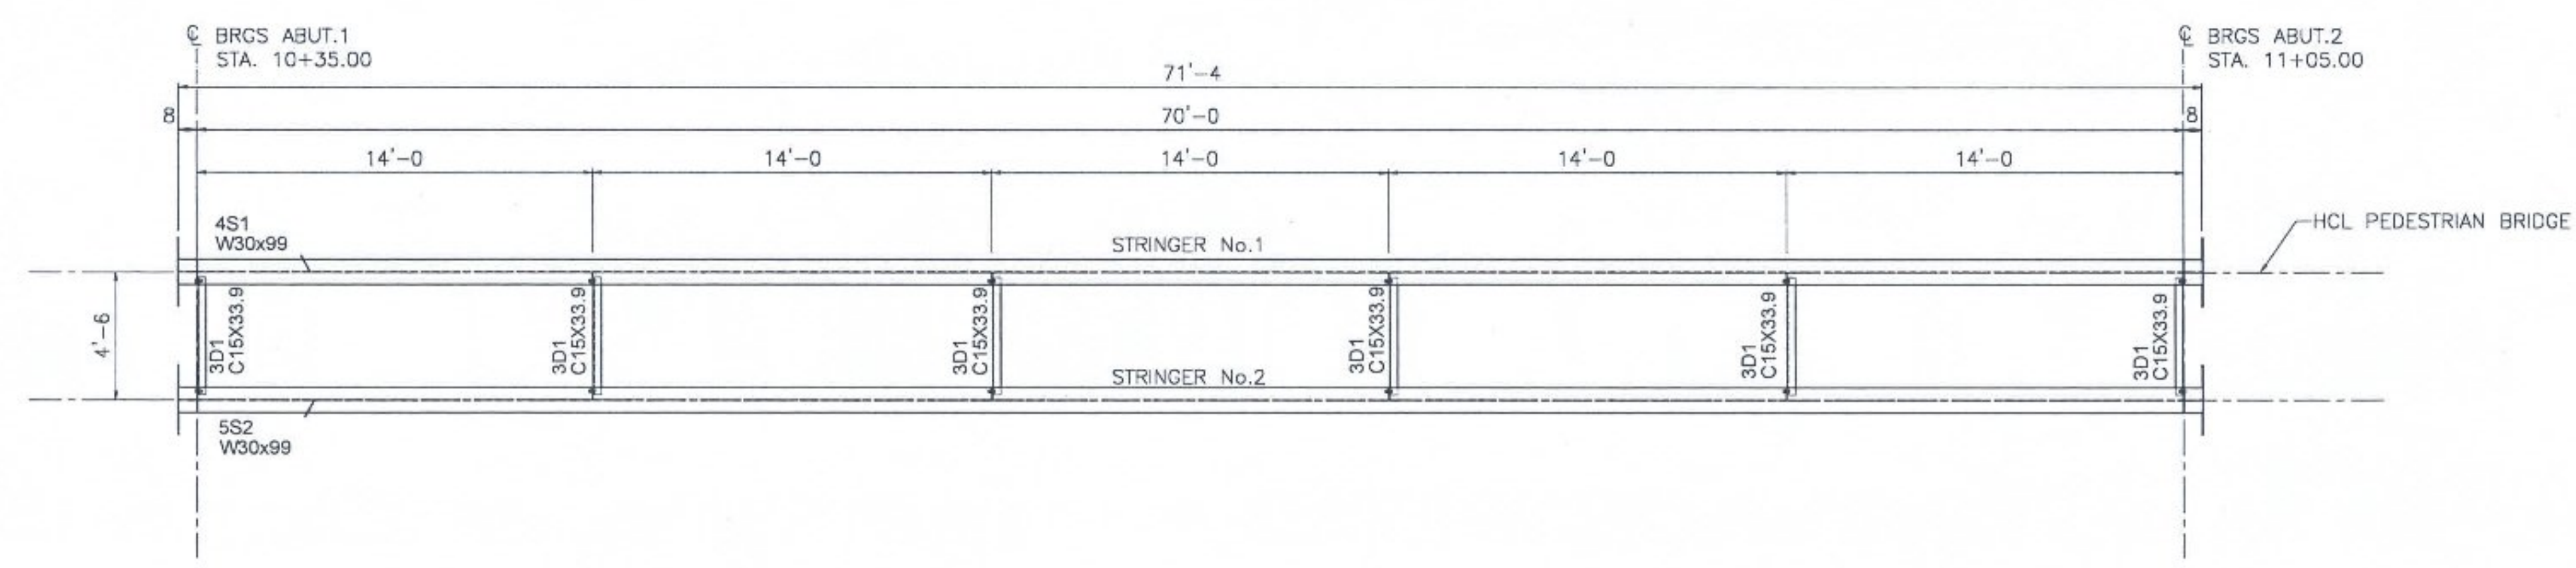

JERICHO-STP FTBR (3)
FRAMING PLAN

T.O.S. CALCULATION TABLE (FEET)						
ABUTMENT	STRINGER No.	T.O. CONCRETE SEAT	T.O. ELASTOMERIC PAD	T.O. SOLE PLATE AT C BRG	BEAM DEPTH	T.O.S.
ABUT. 1	1	531.45	531.655000	531.8040	2.475	534.2790
ABUT. 1	2	531.36	531.565000	531.7140	2.475	534.1890
ABUT. 2	1	534.01	534.218000	534.3640	2.475	536.8390
ABUT. 2	2	533.92	534.128000	534.2740	2.475	536.7490

TOP OF BEAM

- NO EXCEPTION TAKEN
- REJECTED
- MAKE CORRECTIONS NOTED
- REVISE AND RESUBMIT
- SUBMIT SPECIFIED ITEM

CHECKING IS ONLY FOR GENERAL CONFORMANCE WITH THE DESIGN CONCEPT OF THE PROJECT AND GENERAL COMPLIANCE WITH THE INFORMATION GIVEN IN THE CONTRACT DOCUMENTS. ANY ACTION SHOWN IS SUBJECT TO THE REQUIREMENTS OF THE PLANS AND SPECIFICATIONS. CONTRACTOR IS RESPONSIBLE FOR DIMENSIONS WHICH SHALL BE CONFIRMED AND CORRELATED AT THE JOB SITE; FABRICATION PROCESSES AND TECHNIQUES OF CONSTRUCTION; COORDINATION OF HIS WORK WITH THAT OF ALL OTHER TRADES AND THE SATISFACTORY PERFORMANCE OF THE WORK.

DATE 08/07/2014 BY CHA/IT

REV: 0	DATE: 7/22/2014	ISSUED FOR APPROVAL	
MATERIAL: A572-60 M270-CR50W U.N.O.		SURFACE PREP. AND PAINT: N/A	SHOP BOLTS: 7/8" U.N.O.
DESCRIPTION: FRAMING PLAN			
CASCO BAY STEEL STRUCTURES, INC. 1 WALLACE AVE. SOUTH PORTLAND, ME 04106 PHONE (207) 780-8722 FAX (207) 780-8726			
STRUCTURE: VERMONT ROUTE 15 OVER BROWNS RIVER	DRAWN: AD	DATE: 07/22/14	By
LOCATION: TOWN OF JERICHO, VT	CHECKED: AD	DATE: 07/22/14	
PROJECT NO. STP FTBR (3)	JOB NO. 576	DWG NO. E2	
CUSTOMER: Blow & Cote, INC.	REV. 0		