



STATE OF VERMONT  
AGENCY OF TRANSPORTATION

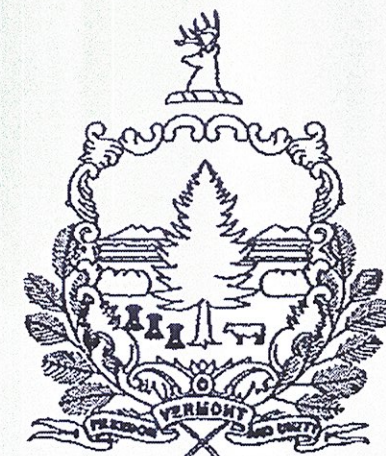


PROPOSED IMPROVEMENT  
BRIDGE PROJECT

TOWN OF DORSET  
COUNTY OF BENNINGTON  
VERMONT RAILWAY (VTR) BRIDGE NO. 79

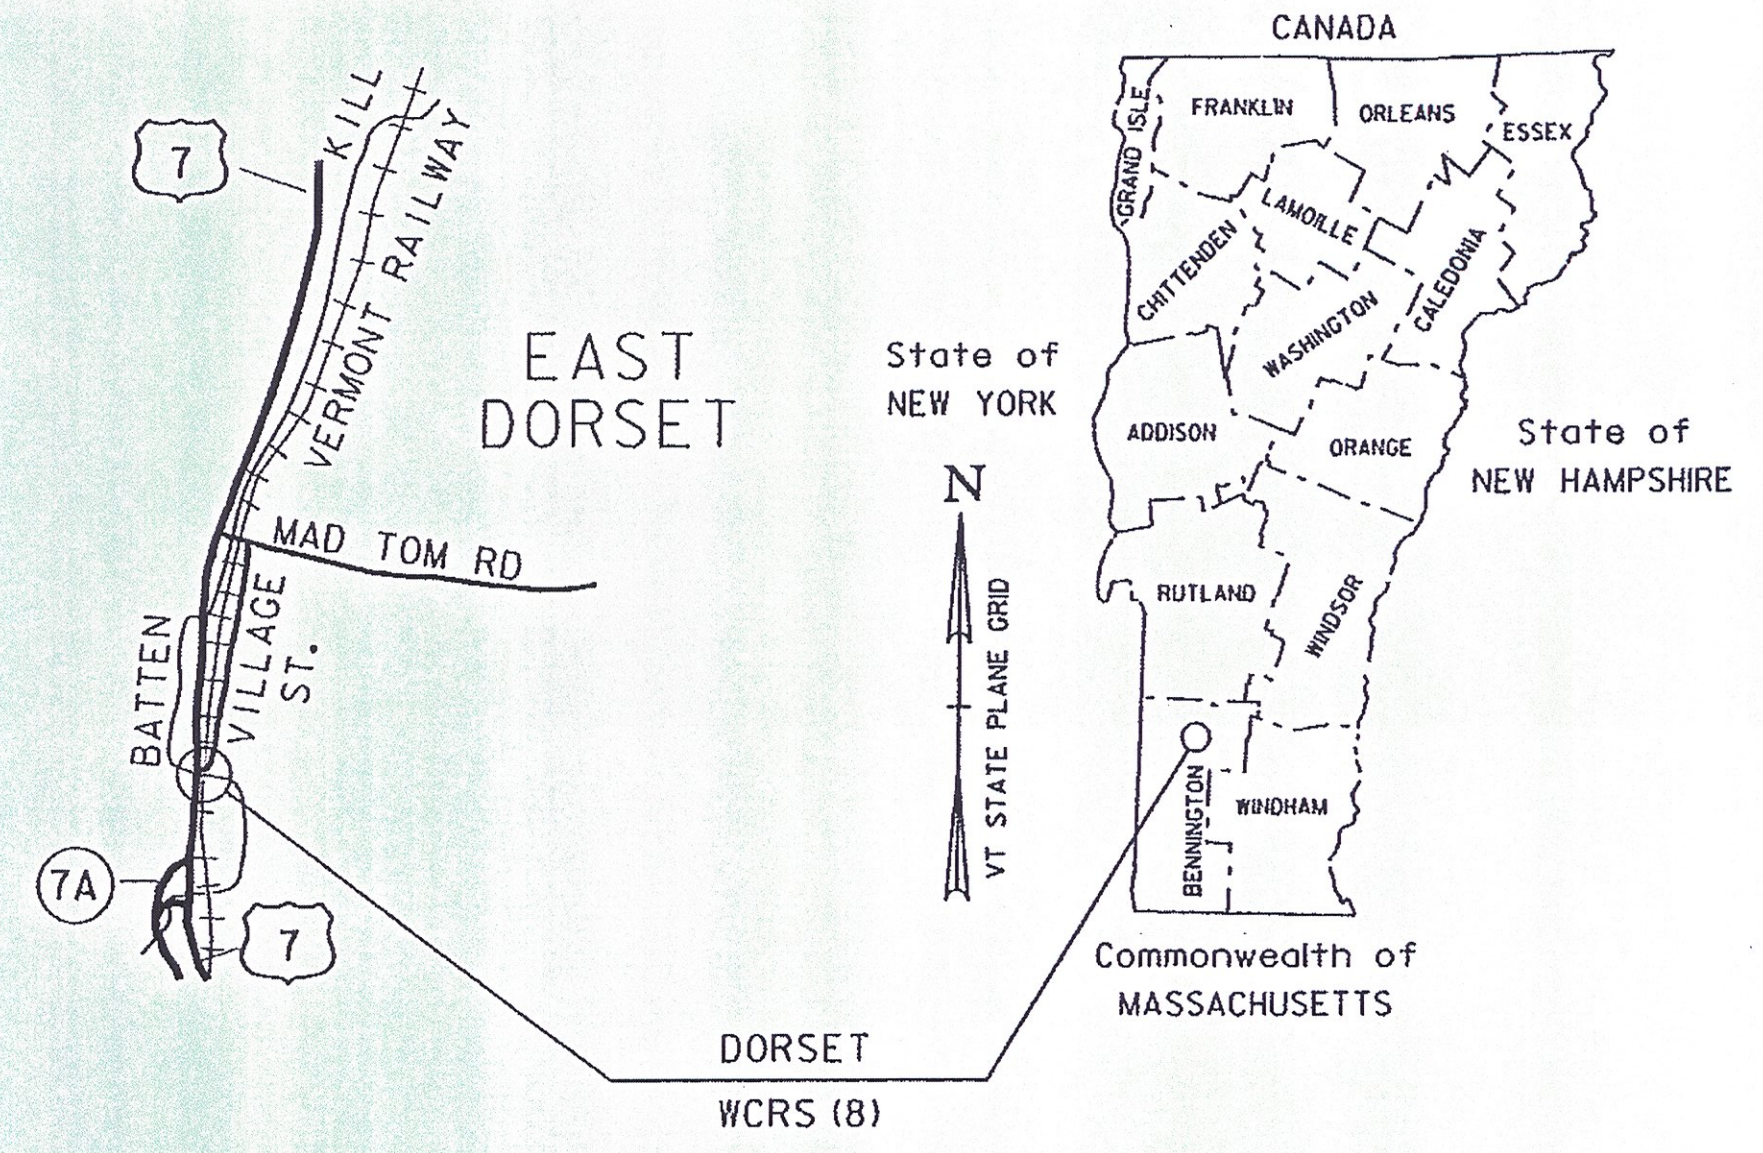

RECORD PLANS	
CONTRACTOR:	CCS CONSTRUCTORS LLC - MORRISVILLE, VT
RESIDENT ENGINEER:	JUDY GILMORE
CONSTRUCTION BEGAN:	SEPTEMBER 22, 2014
CONSTRUCTION COMPLETE:	OCTOBER 1, 2014
RECORD PLANS BY:	JUDY GILMORE & C. PIERCE
I HEREBY CERTIFY THAT ALL THE CONSTRUCTION REQUIRED BY THIS SET OF DRAWINGS HAS BEEN ACCOMPLISHED AS INDICATED HEREIN.	
BY	<i>Judy Gilmore</i> RESIDENT ENGINEER
DATE	7 May 2016
NOTE: Any further information concerning final quantities, amounts or other details relative to this project may be found at Central Files in the electronic archives.	


PROJECT LOCATION: VTR BRIDGE NO. 79 OVER THE BATTEN KILL AT MILE POST 28.17 IN DORSET.  
 PROJECT DESCRIPTION: REMOVAL AND REPLACEMENT OF EXISTING CONCRETE STRUCTURE WITH STEEL OPEN DECK SUPERSTRUCTURE, PRECAST CONCRETE ABUTMENTS ON PILES, CONCRETE APPROACH SLABS, ASSOCIATED TRACK WORK AND CHANNEL ARMORING.  
 LENGTH OF STRUCTURE: 34.00 FEET  
 LENGTH OF RAILROAD: 52.16 FEET  
 LENGTH OF PROJECT: 86.16 FEET

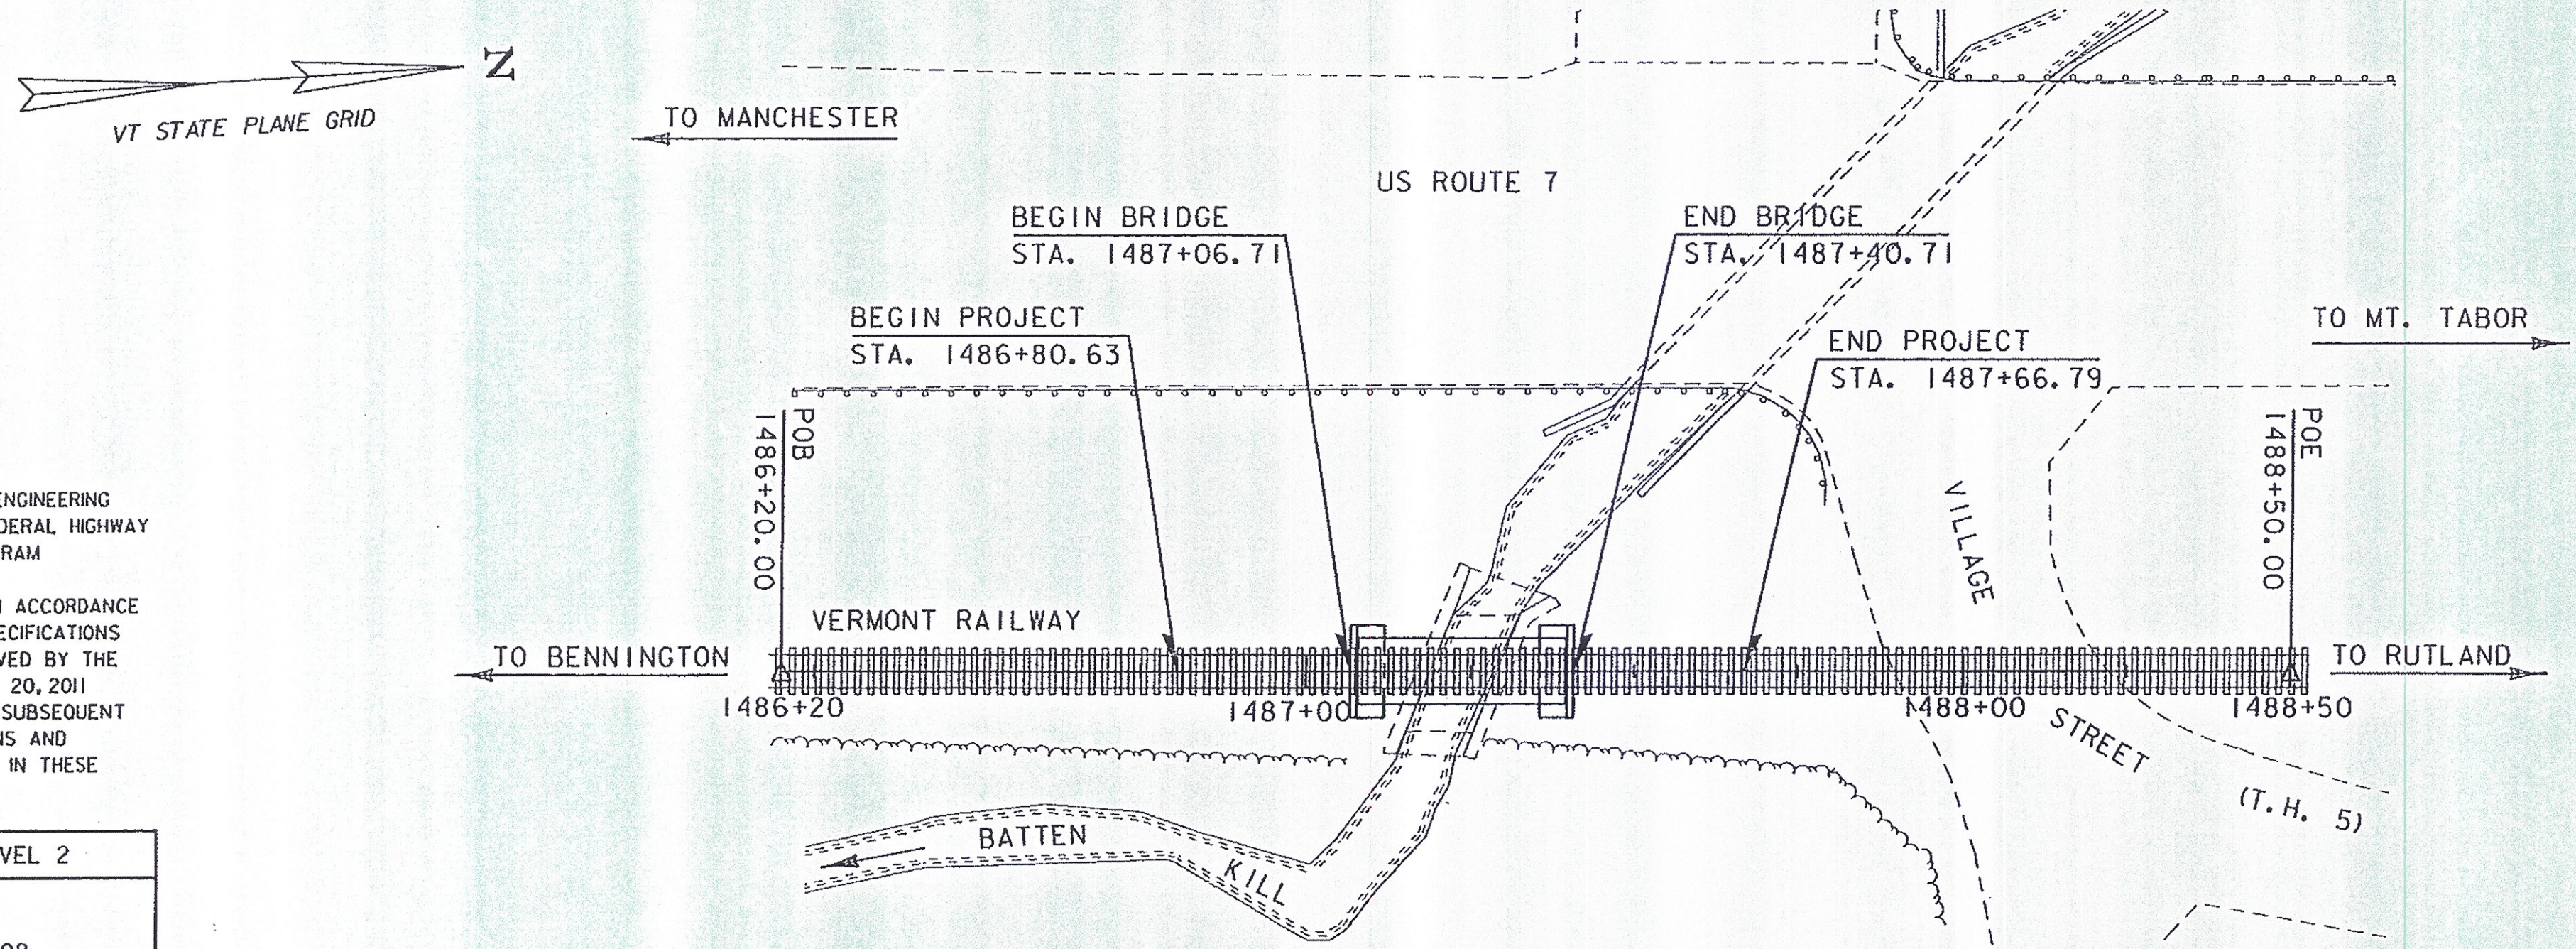

THESE PLANS ARE SUBJECT TO SUCH ENGINEERING CHANGES AS MAY BE REQUIRED BY THE FEDERAL HIGHWAY ADMINISTRATION OR THE DIRECTOR OF PROGRAM DEVELOPMENT.  
 CONSTRUCTION IS TO BE CARRIED ON IN ACCORDANCE WITH THESE PLANS AND THE STANDARD SPECIFICATIONS FOR CONSTRUCTION DATED 2011, AS APPROVED BY THE FEDERAL HIGHWAY ADMINISTRATION ON JULY 20, 2011 FOR USE ON THIS PROJECT, INCLUDING ALL SUBSEQUENT REVISIONS AND SUCH REVISED SPECIFICATIONS AND SPECIAL PROVISIONS AS ARE INCORPORATED IN THESE PLANS.

QUALITY ASSURANCE PROGRAM : LEVEL 2
SURVEYED BY : VHB
SURVEYED DATE : DECEMBER, 2008
DATUM
VERTICAL: NAVD 1988
HORIZONTAL: NAD 83

SCALE 1" = 20'-0"  
20 0 20

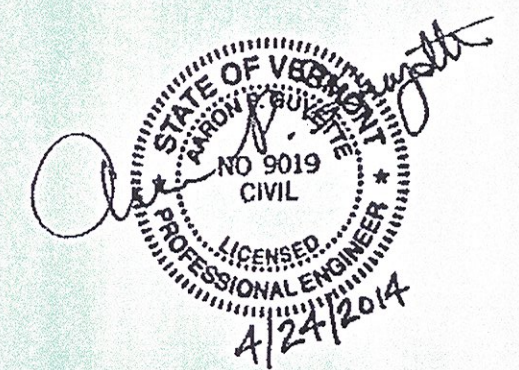

DEPARTMENT OF TRANSPORTATION FEDERAL HIGHWAY ADMINISTRATION	APPROVED <i>Joshua L. Schultz</i> DATE 5/5/14
DIRECTOR OF POLICY PLANNING AND INTERMODAL DEVELOPMENT	APPROVED <i>Joshua L. Schultz</i> DATE 4/24/14
PROJECT MANAGER : JOSHUA L. SCHULTZ, P.E.	
PROJECT NAME : DORSET	
PROJECT NUMBER : WCRS (8)	
SHEET 1 OF 33 SHEETS	

