

GPS CONTROL POINTS



HVCTRL: #100

B99032

NORTH = 267971.25  
 EAST = 1504311.33  
 ELEV. = 780.90

GENERAL LOCATION: DORSET VT, IN EAST DORSET. TO REACH FROM THE INTERSECTION OF US ROUTE 7 AND HISTORIC VT ROUTE 7A IN EAST DORSET, GO NORTH ALONG US ROUTE 7 FOR 0.15 MI (0.24 KM) TO THE SOUTH END OF THE US ROUTE 7 BRIDGE OVER THE BATTEN KILL AND THE SITE OF THE MARK IS ON THE RIGHT, SET IN THE TOP OF THE ABUTMENT AT THE SOUTHEAST CORNER OF THE BRIDGE. IT IS JUST SOUTH OF THE INTERSECTION OF VILLAGE STREET AND THE STATE OF VERMONT EAST DORSET MAINTENANCE GARAGE. IT IS 1.6 FT (0.5 M) EAST OF AND ABOUT 0.3 FT (0.1 M) LOWER THAN THE EAST EDGE OF PAVEMENT OF US ROUTE 7, 0.3 FT (0.1 M) SOUTHWEST OF THE NORTHEAST FACE OF THE ABUTMENT, 50.9 FT (15.5 M) SOUTH OF THE CENTERLINE OF VILLAGE STREET, AND 38.7 FT (11.8 M) WEST OF THE RAIL OF THE RAILROAD TRACKS.

TRAVERSE TIES

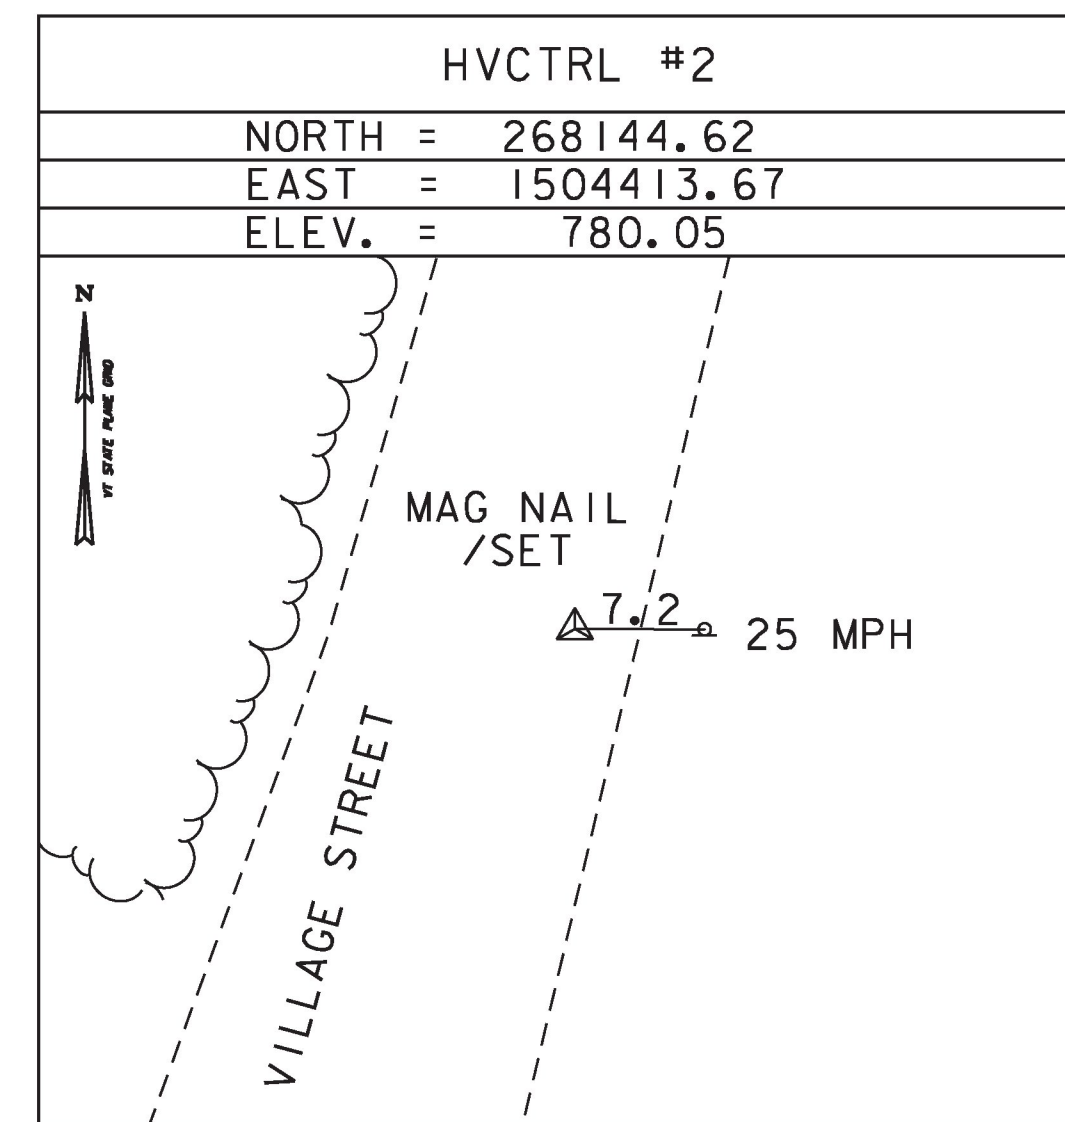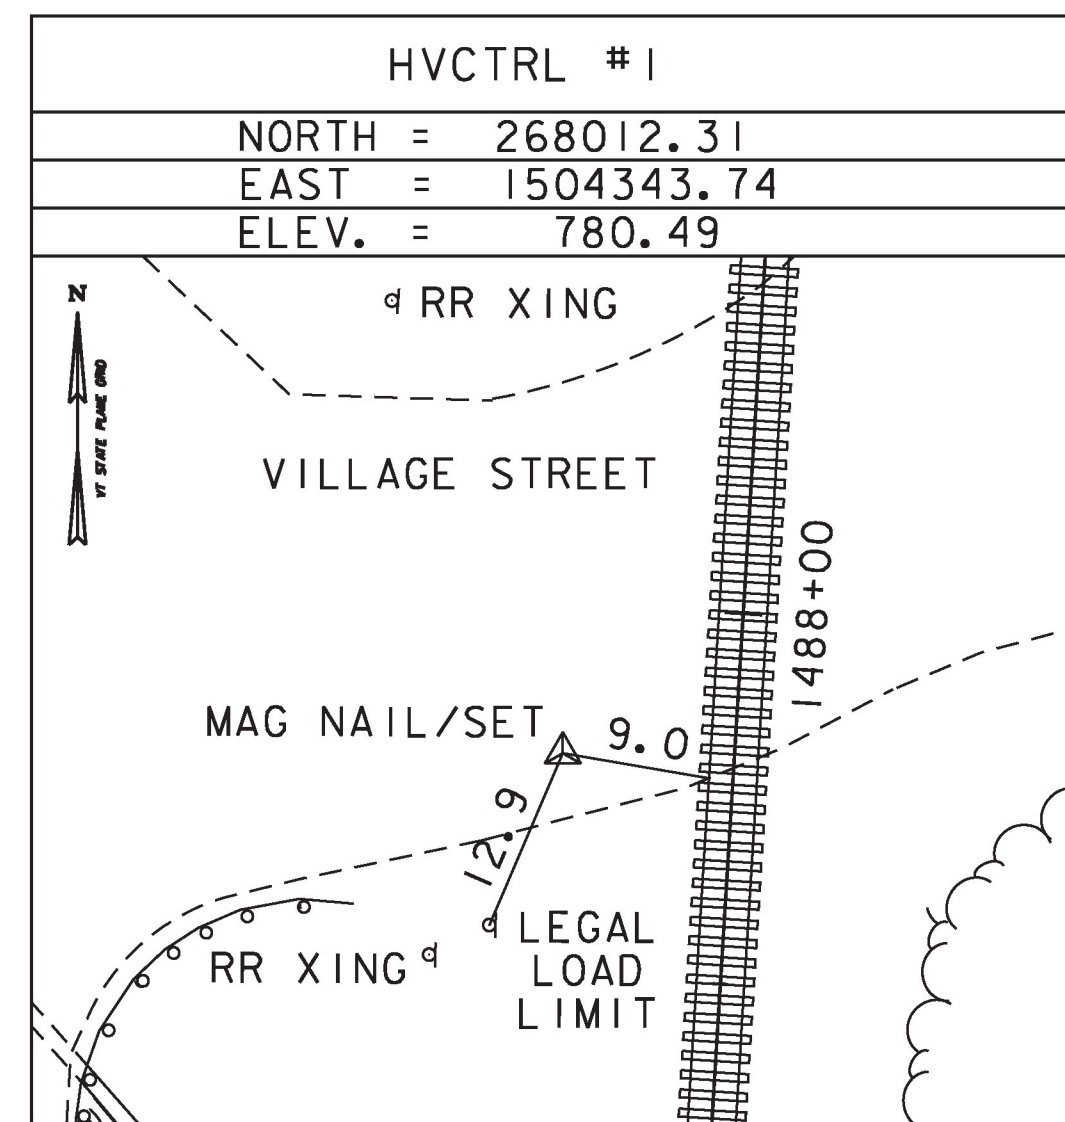

\* Main Traverse Completed 12/30/08 by T. Gaudet

DATUM	
VERTICAL	NAVD 88
HORIZONTAL	NAD 83



PROJECT NAME: DORSET	PLOT DATE: 5/2/2014
PROJECT NUMBER: WCRS(8)	DRAWN BY: J.W. GOLEK
FILE NAME: z08g224t1.dgn	CHECKED BY: B.M. KLINEFELTER
PROJECT LEADER: A.P. GUYETTE	SHEET 8 OF 33
DESIGNED BY: T. J. GAUDET	
TIE SHEET	