



PLAN  
SCALE: 3/4" = 1'-0"

NOTE: ABUTMENT NO. 1 ELEVATIONS SHOWN, ABUTMENT NO. 2 ELEVATIONS SHOWN IN PARENTHESES.

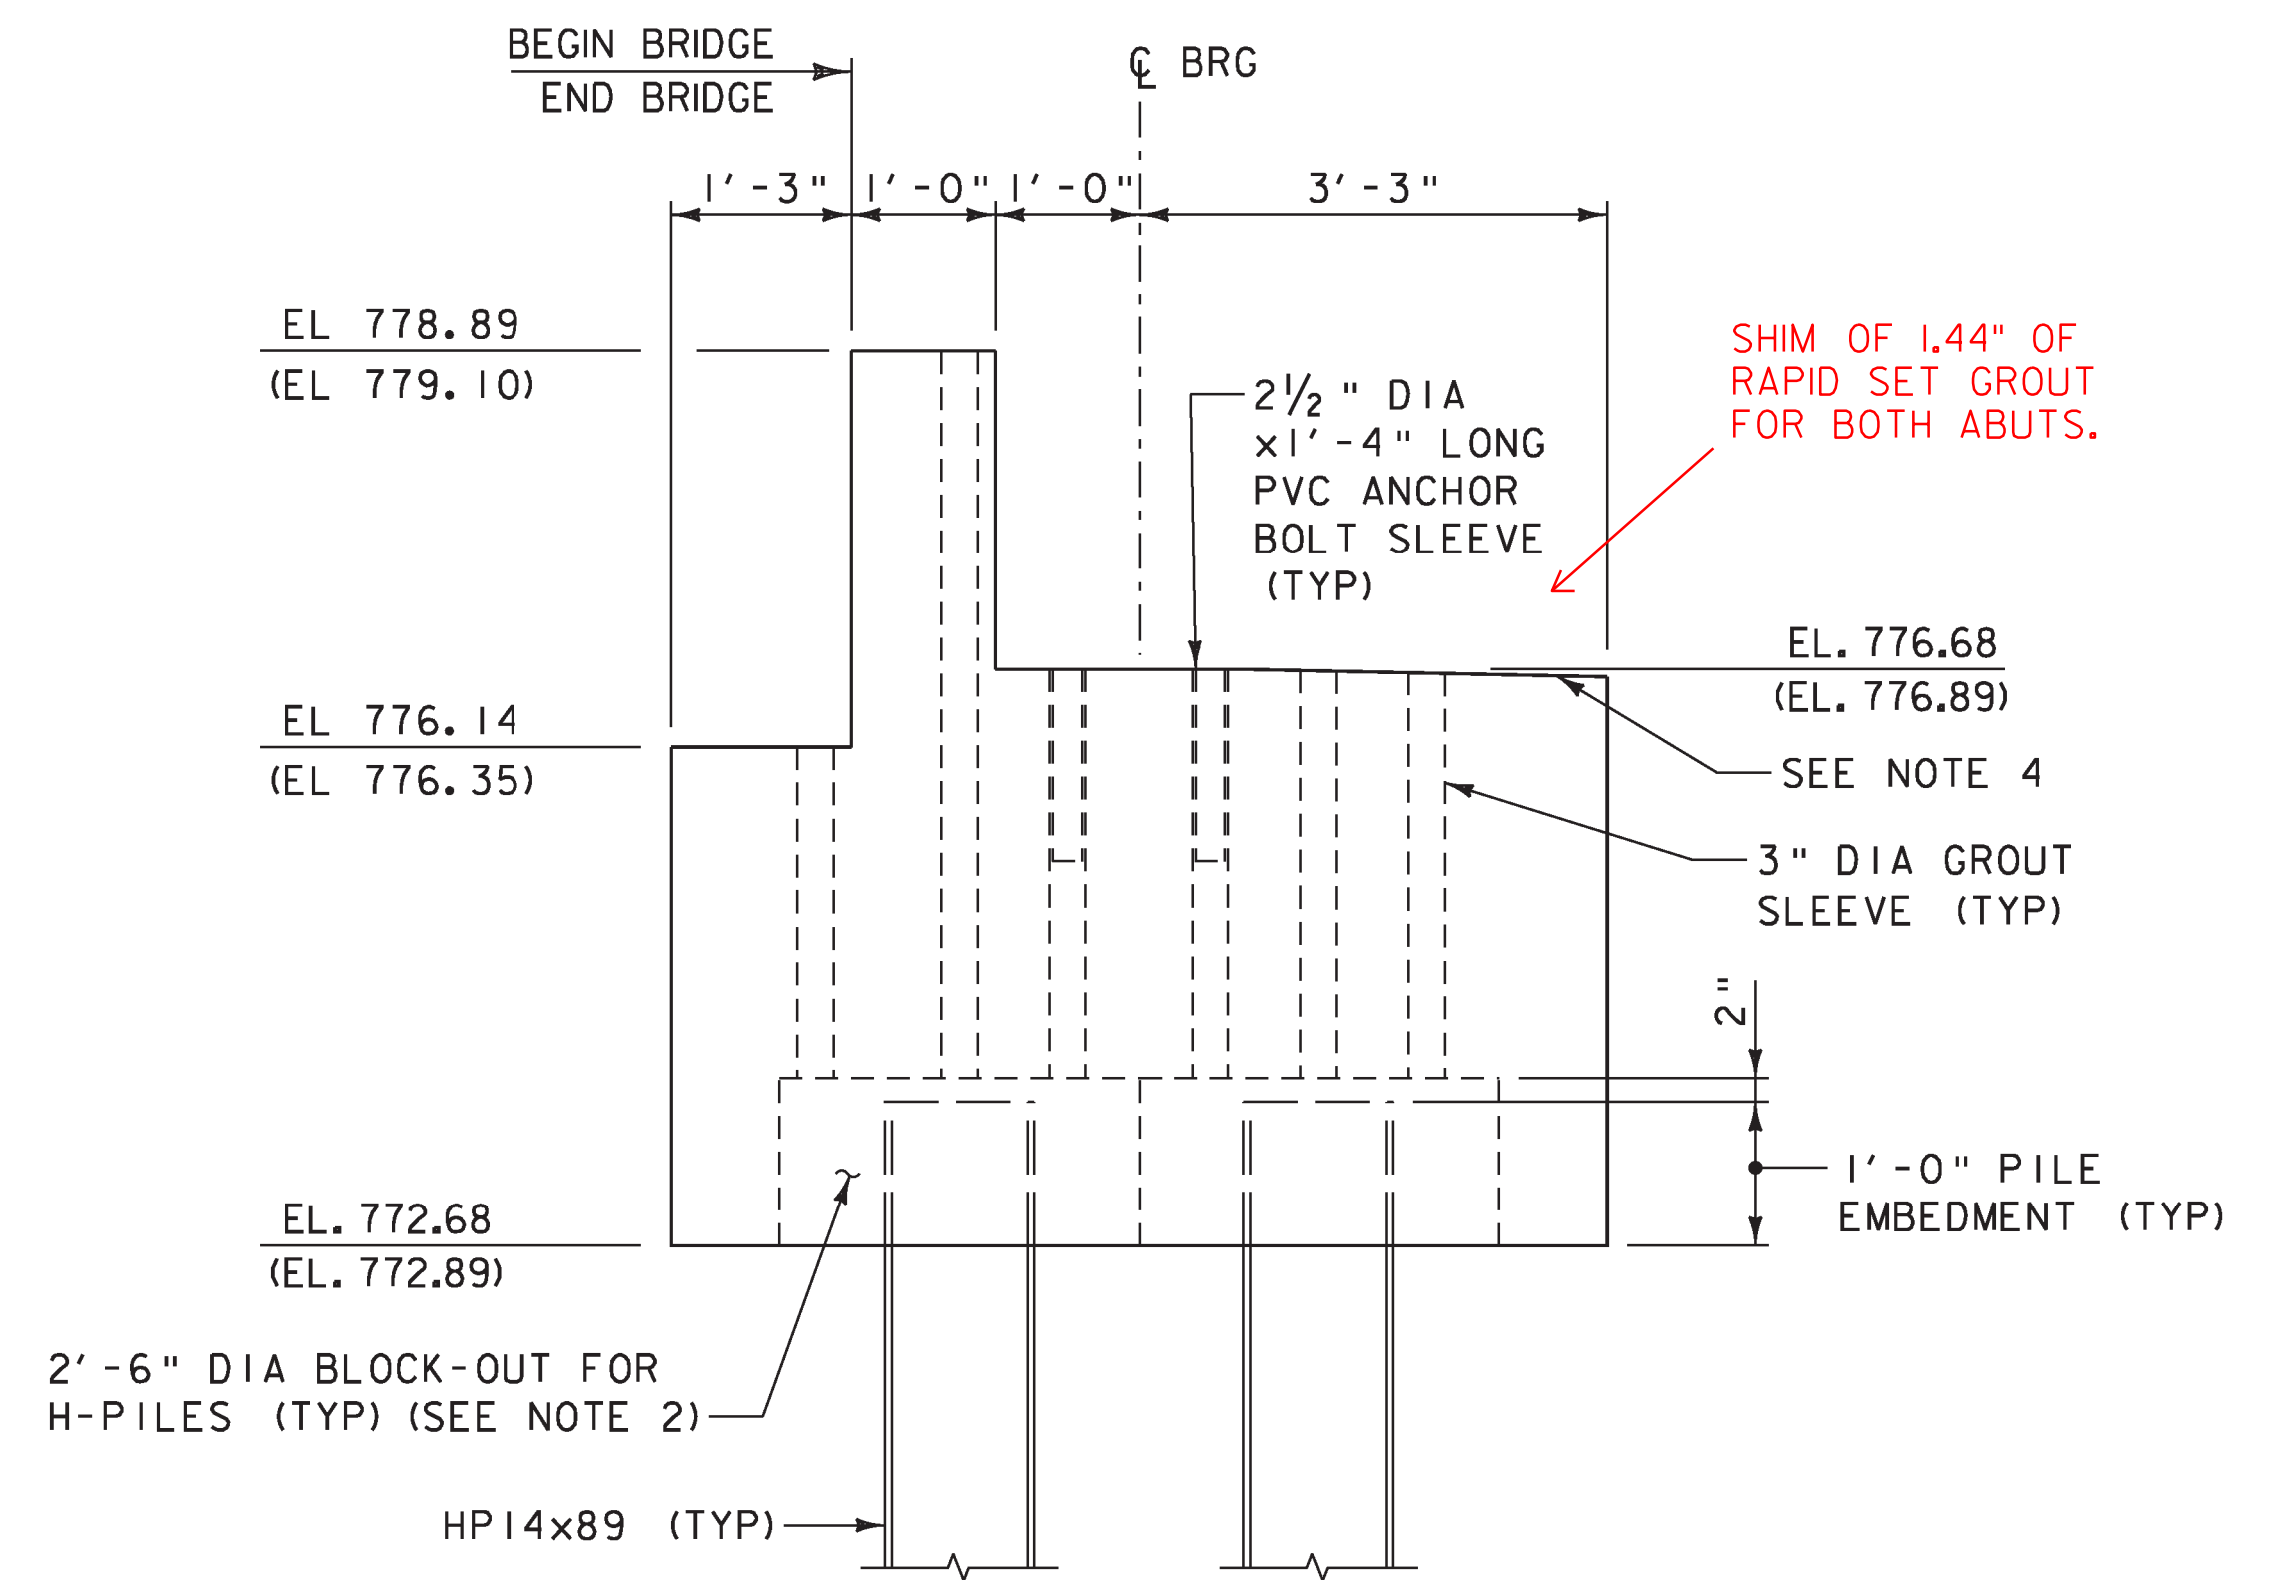

SECTION  
SCALE: 3/4" = 1'-0"

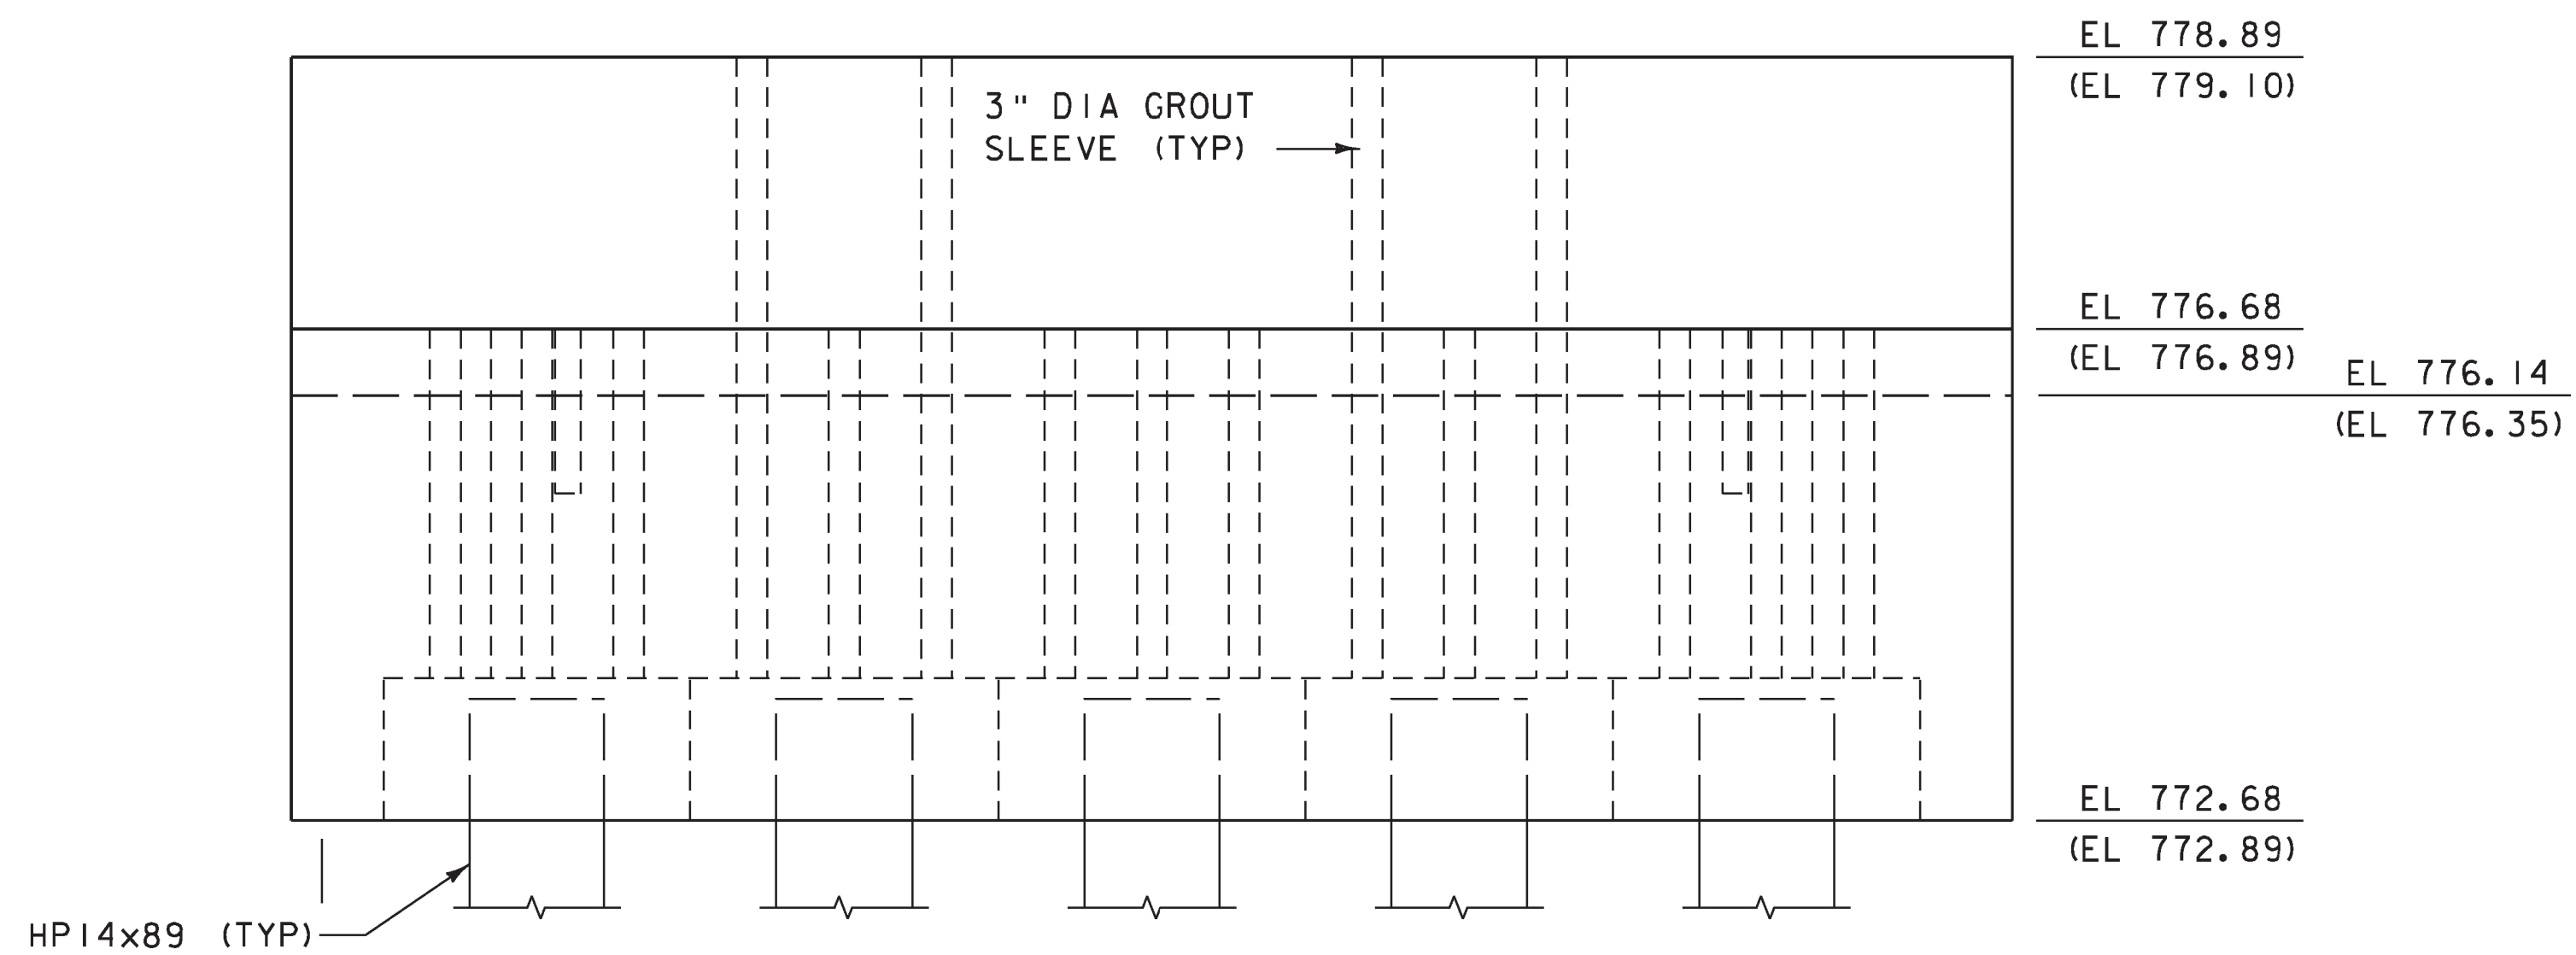

ELEVATION  
SCALE: 3/4" = 1'-0"

CONCRETE NOTES:

- SEE SHEET 23 FOR REINFORCING DETAILS.
- PILE BLOCK-OUTS TO BE FILLED WITH ITEM 900.608, SPECIAL PROVISION (HIGH PERFORMANCE CONCRETE, RAPID SET). SEE PRECAST CONCRETE NOTES ON SHEET 4 FOR ADDITIONAL GROUT INSTALLATION REQUIREMENTS.
- REPOSITION GROUT SLEEVES AS REQUIRED TO AVOID CONFLICT WITH REINFORCING STEEL OR FORM WORK.
- SURFACE OF BRIDGE SEATS UNDER BEARINGS SHALL BE LEVEL. AREAS IN FRONT OF BEARINGS SHALL BE SLOPED 1/4" PER FOOT TOWARD MIDSPAN.

PROJECT NAME: DORSET  
PROJECT NUMBER: WCRS(8)

FILE NAME: z08g224subabl.dgn  
PROJECT LEADER: A.P. GUYETTE  
DESIGNED BY: G.S. GOODRICH  
ABUTMENT DETAILS (MASONRY)

PLOT DATE: 5/2/2014  
DRAWN BY: B.J. MASSE  
CHECKED BY: L.S. GARDNER  
SHEET 22 OF 33