



1487+25
 BEGIN BRIDGE
 STA. 1487+06.71

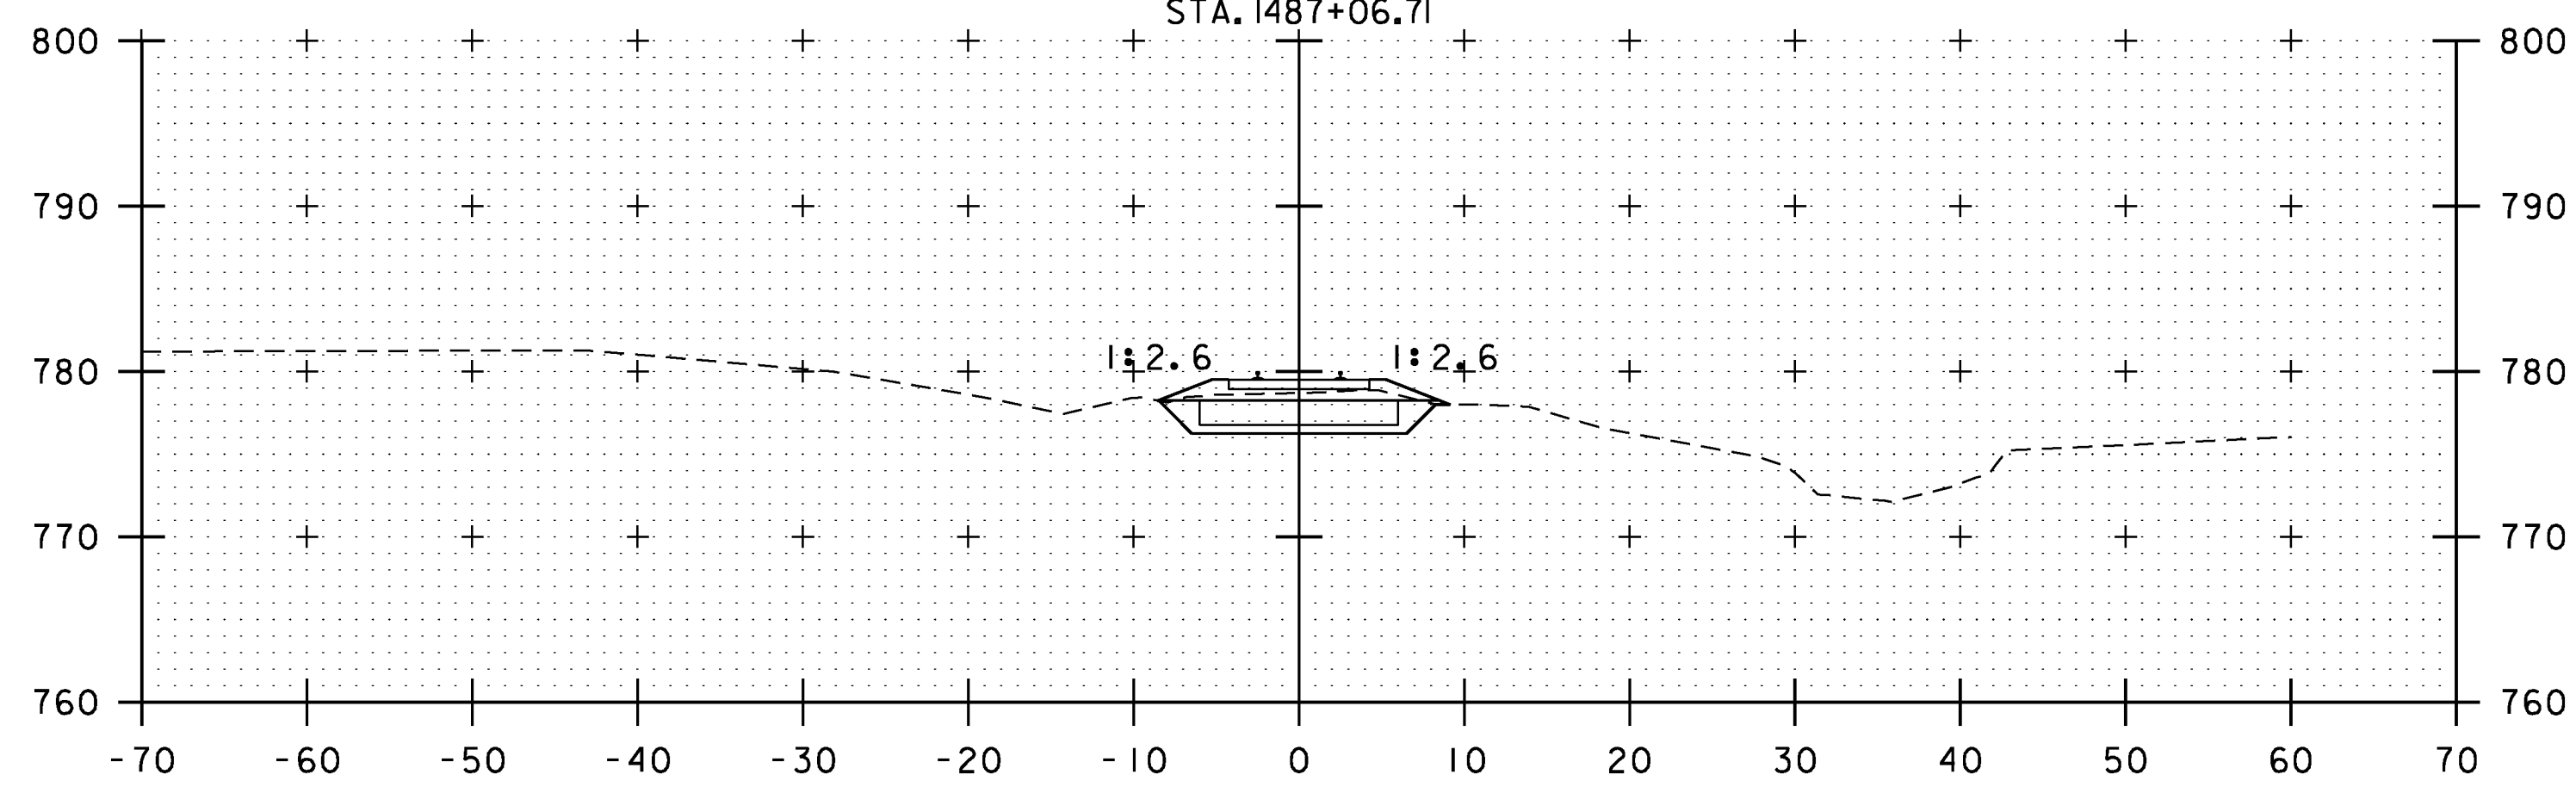


1487+00

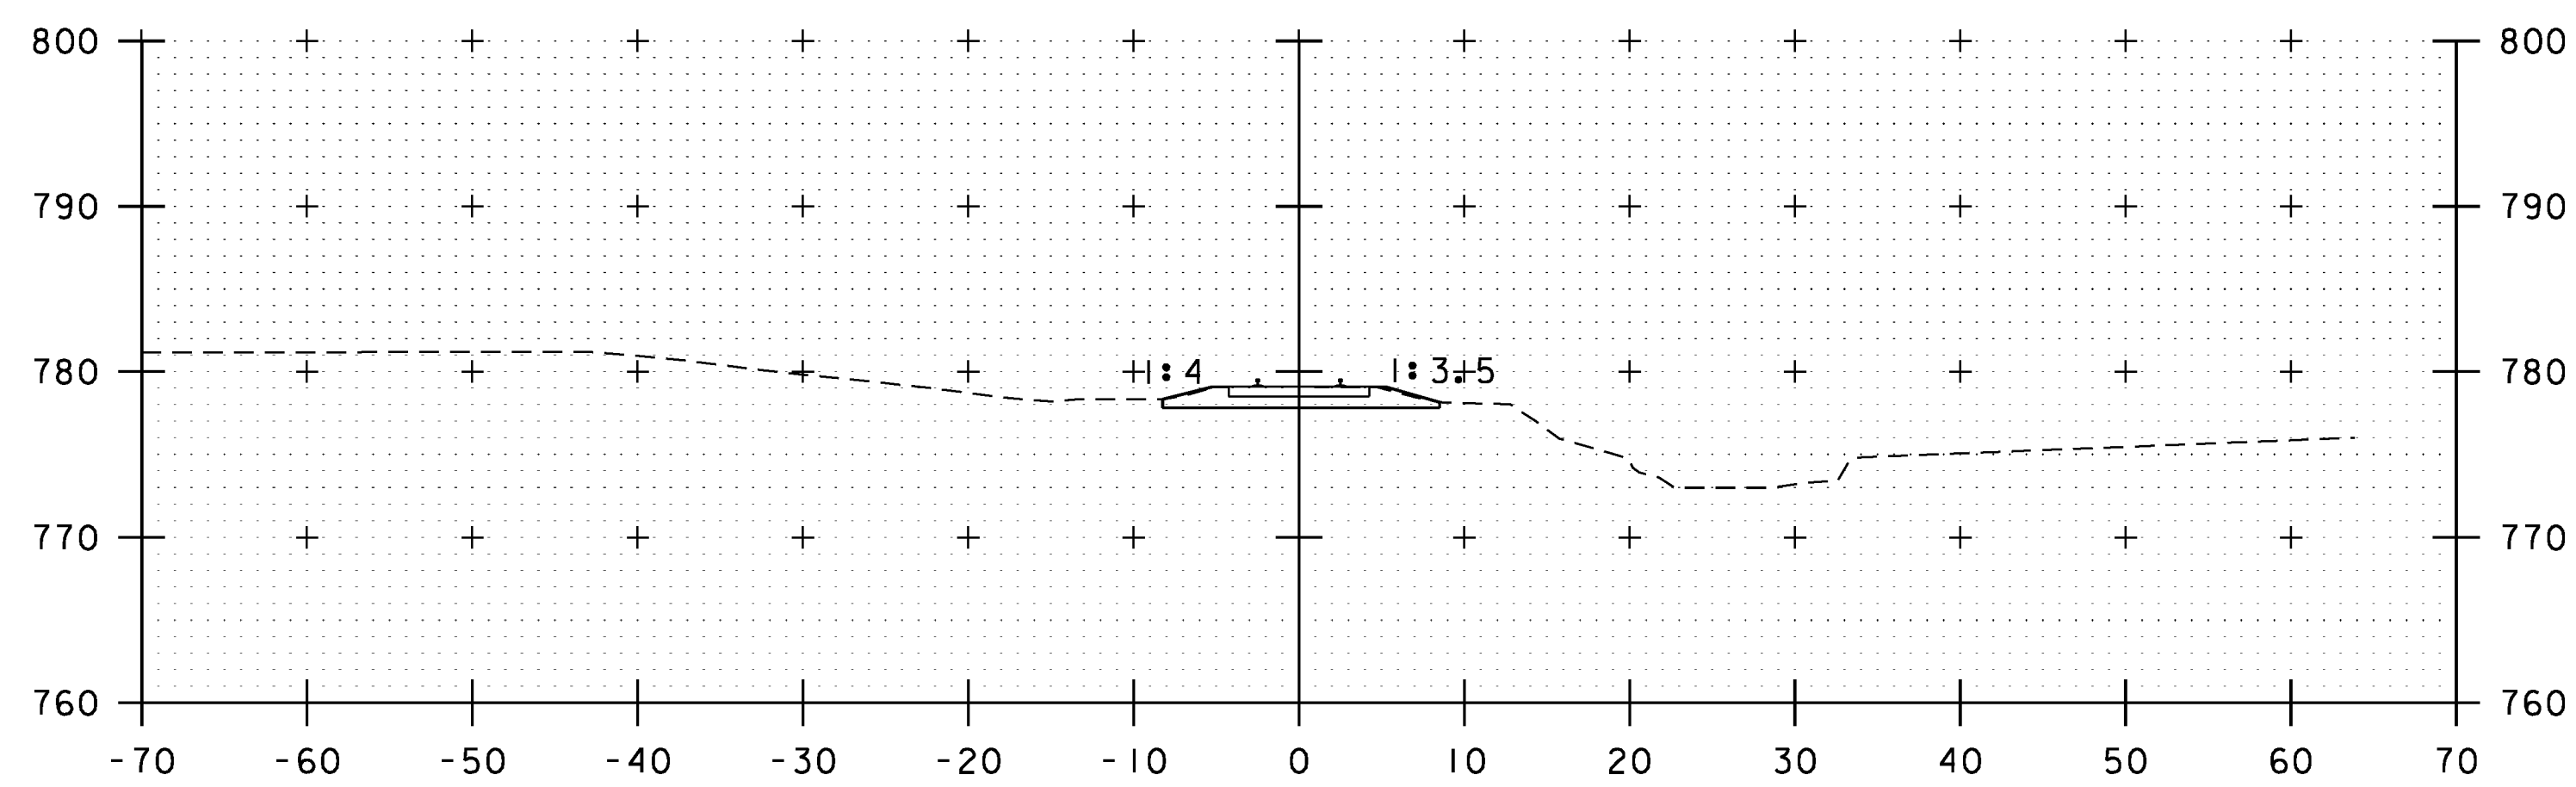


1486+81
 BEGIN PROJECT
 STA. 1486+80.63

RAILROAD CROSS SECTIONS
 STA 1486+81 - 1487+67

SCALE 1" = 10'-0"
 10 0 10

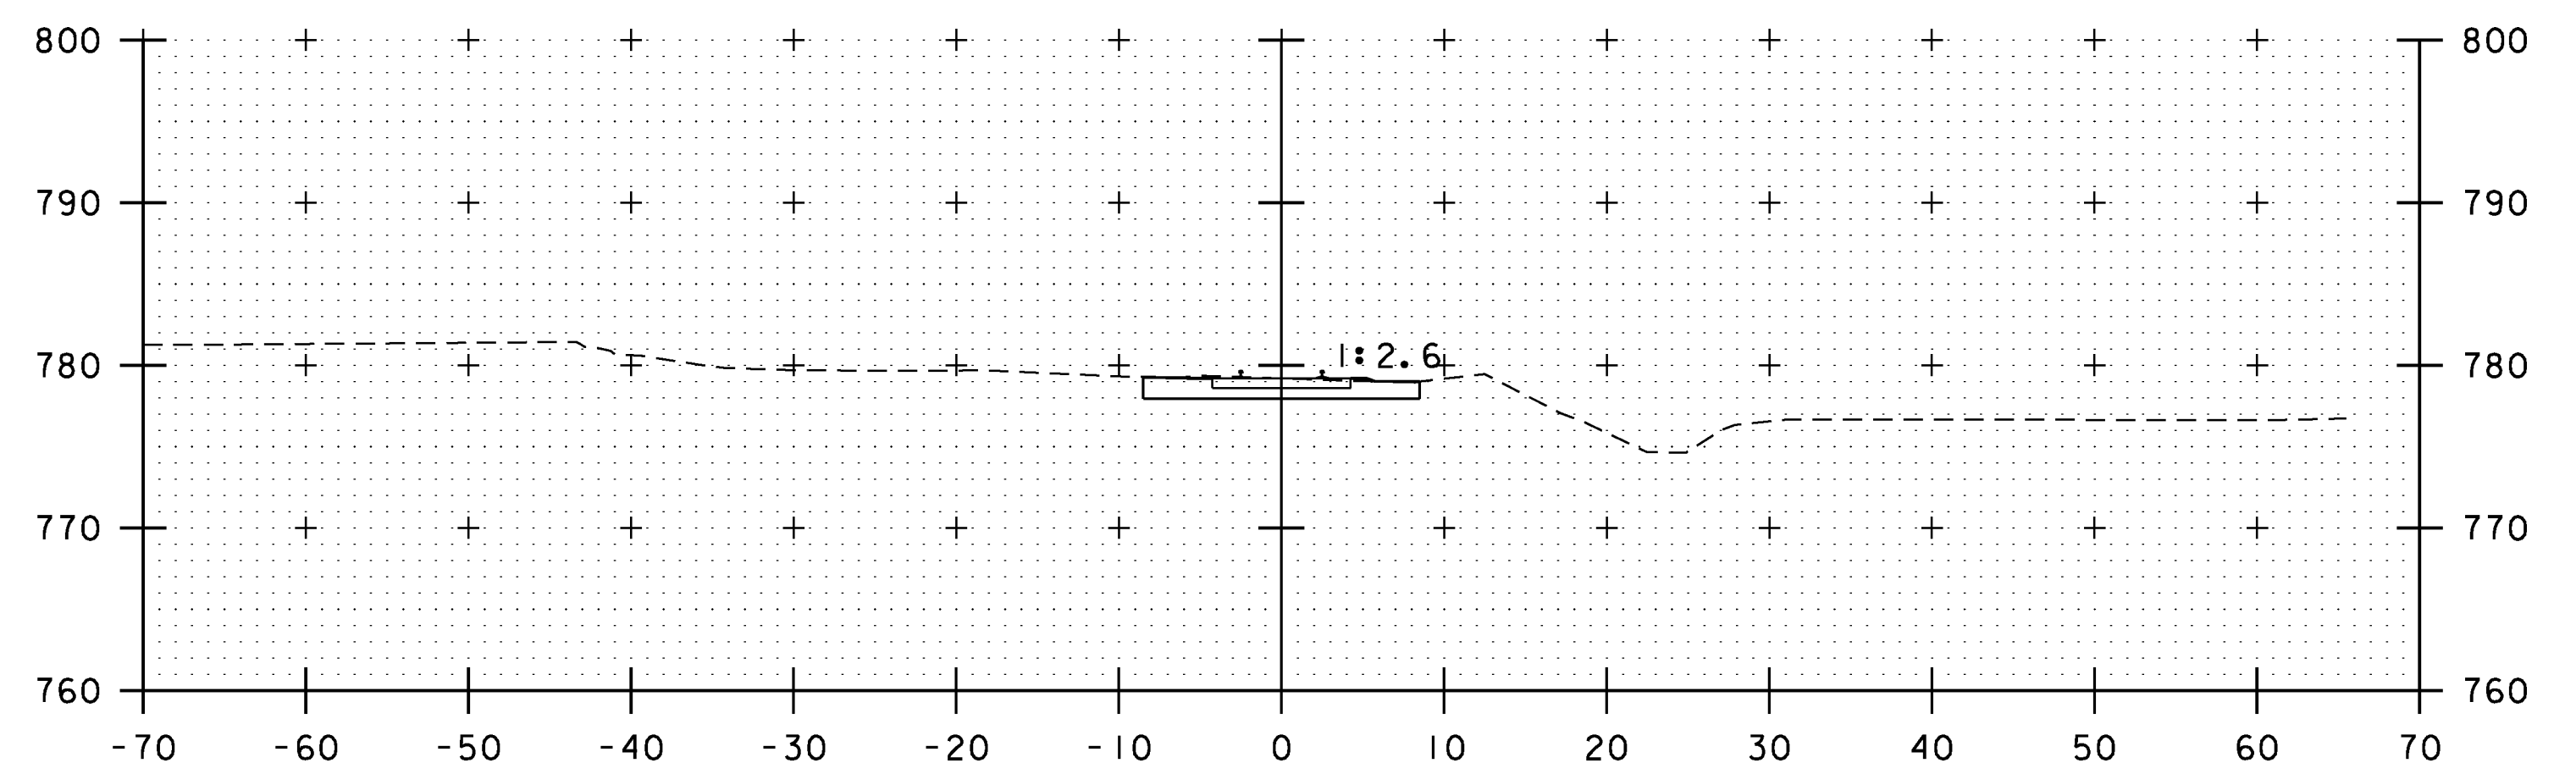

1487+67
 END PROJECT
 STA. 1487+66.79

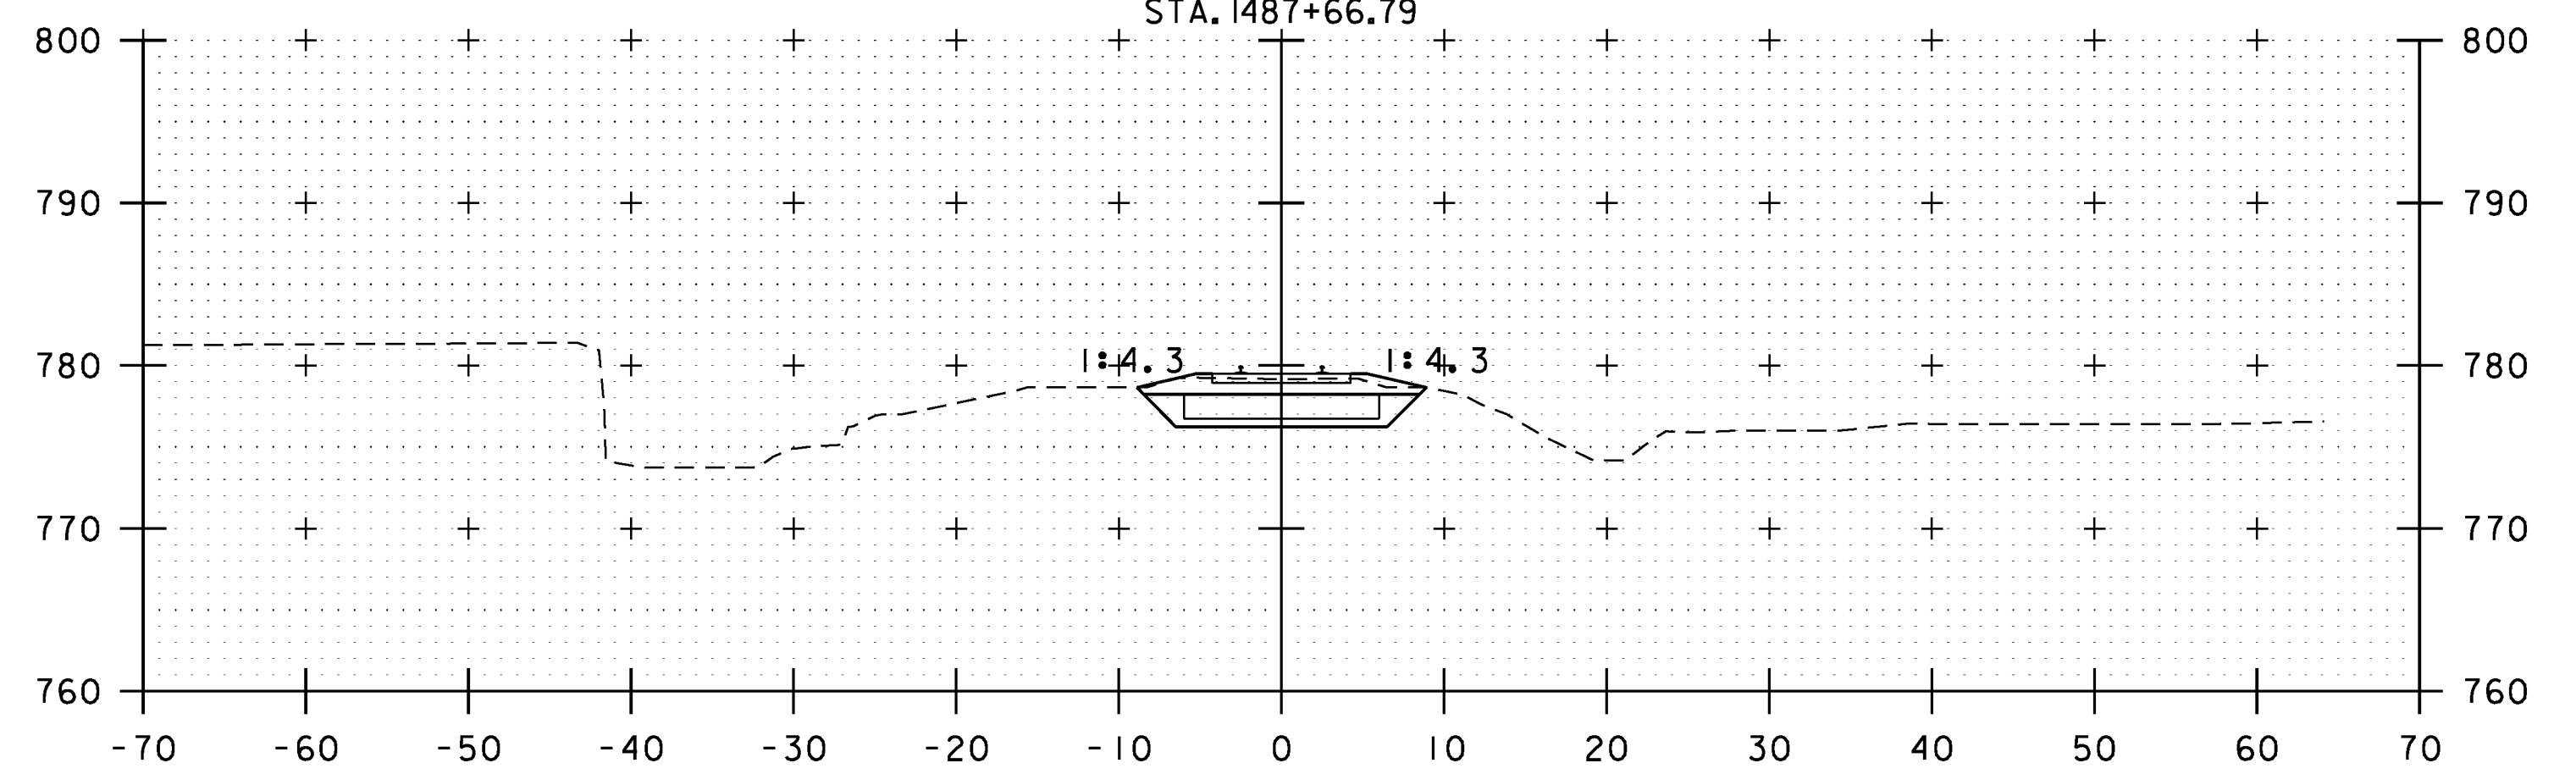

1487+50
 END BRIDGE STA. 1487+40.71

PROJECT NAME: DORSET	PROJECT NUMBER: WCRS(8)
FILE NAME: z08g224xs3.dgn	PLOT DATE: 4/22/2014
PROJECT LEADER: A.P. GUYETTE	DRAWN BY: J.L. LEMIEUX
DESIGNED BY: B.O. CRONIN	CHECKED BY: B.O. CRONIN
RAIL CROSS SECTIONS	SHEET 25 OF 33