


**NOTES:**

1. WHERE LEDGE IS EXPOSED, GRAVEL BAGS MAY BE USED. PAYMENT FOR THIS ITEM SHALL BE INCIDENTAL TO ITEM 900.645 "SPECIAL PROVISION (TEMPORARY RELOCATION OF STREAM)".
2. WATER DIVERSION PIPE TO BE SIZED TO MAINTAIN RIVER FLOW.
3. THE WATER DIVERSION PIPE CONCEPTS SHOWN ARE FOR PERMITTING PURPOSES ONLY. THE CONTRACTOR MAY PROPOSE OTHER WATER DIVERSION SYSTEMS PROVIDED THEY REMAIN WITHIN THE LIMITS OF THE PERMITTED IMPACT AREAS.
4. TEMPORARY WATER DIVERSION WORK, INCLUDING PIPE AND INLET, SHALL BE PERFORMED IN ACCORDANCE WITH AND PAID FOR UNDER ITEM 900.645 SPECIAL PROVISION (TEMPORARY RELOCATION OF STREAM).
5. SEE SHEET 7 FOR SYMBOLOLOGY.

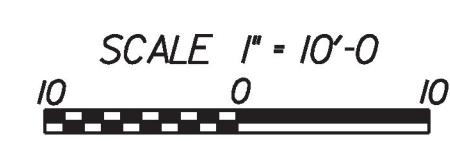

PROJECT NAME:	DORSET	FILE NAME:	z08g224bdr nul.dgn	PLOT DATE:	5/2/2014
PROJECT NUMBER:	WCRS(8)	PROJECT LEADER:	A.P. GUYETTE	DRAWN BY:	E.A. FIALA
		DESIGNED BY:	E.A. FIALA	CHECKED BY:	B.O. CRONIN
		EPSC CONSTRUCTION CONDITIONS SITE PLAN		SHEET 30 OF 33	