


**LEGEND**

- AER E&T — AERIAL ELECTRIC & TELEPHONE
- - - - - RIPARIAN BUFFER ZONE

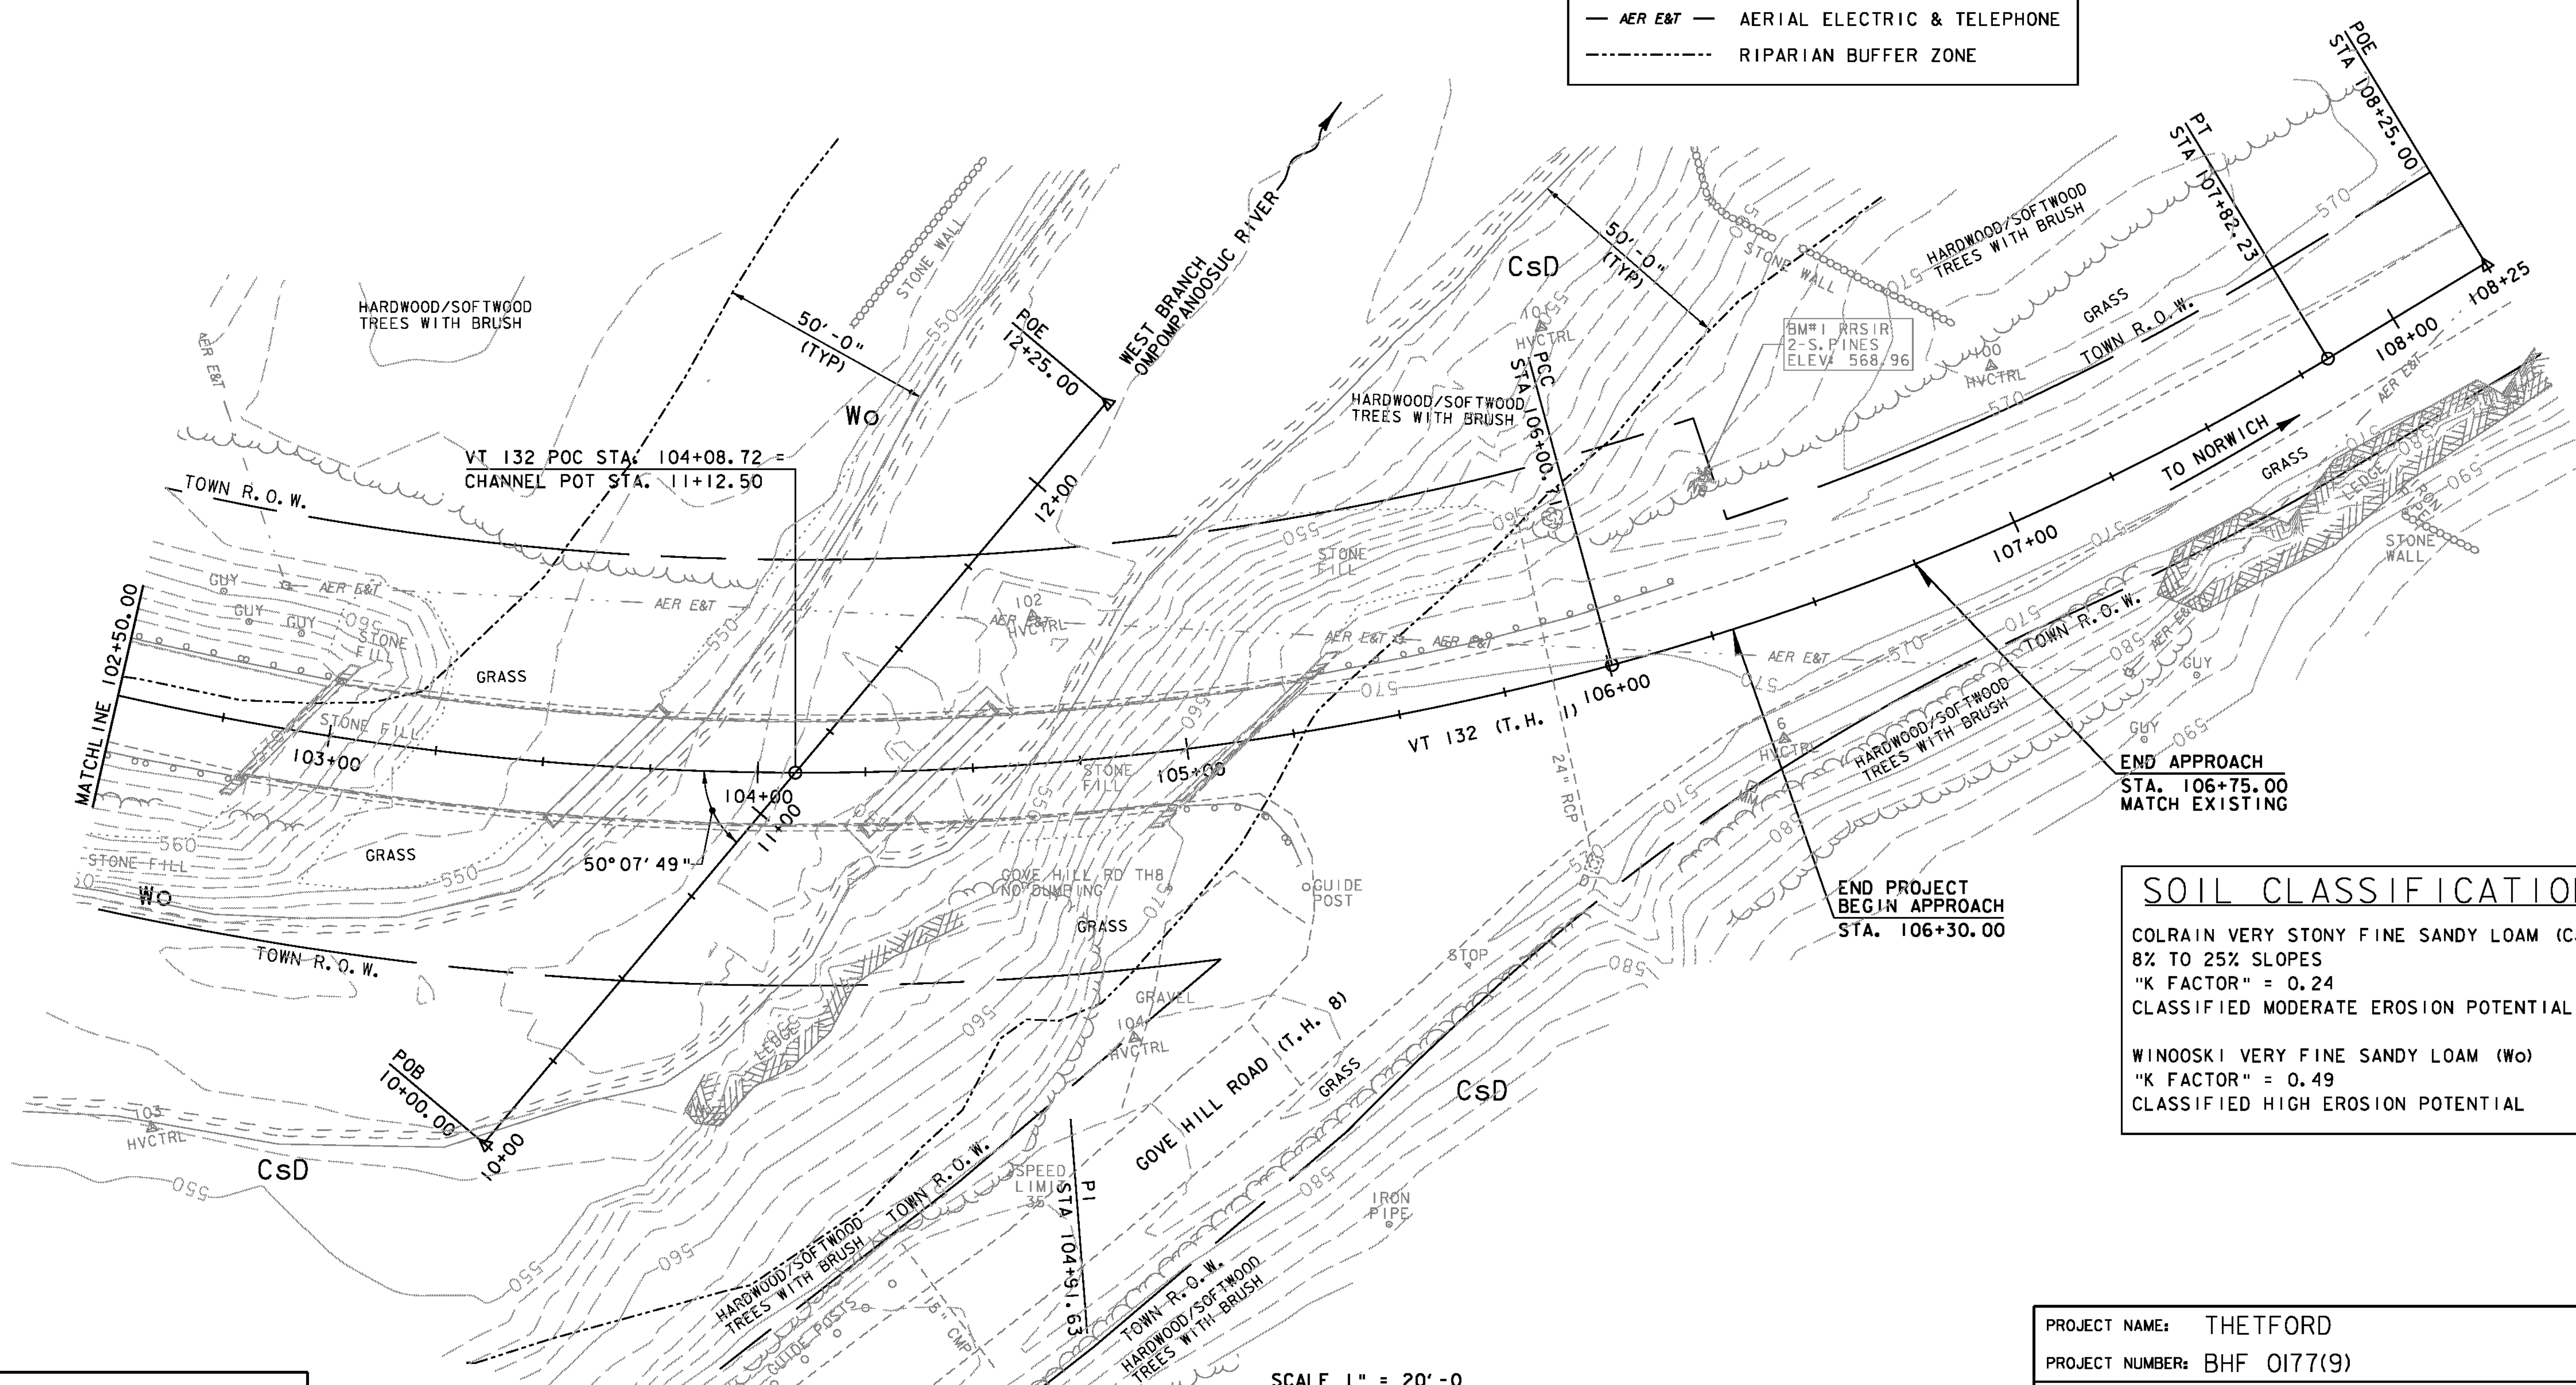

**SOIL CLASSIFICATION**

COLRAIN VERY STONY FINE SANDY LOAM (CSD)  
 8% TO 25% SLOPES  
 "K FACTOR" = 0.24  
 CLASSIFIED MODERATE EROSION POTENTIAL

WINOOSKI VERY FINE SANDY LOAM (WO)  
 "K FACTOR" = 0.49  
 CLASSIFIED HIGH EROSION POTENTIAL

**DATUM**

VERTICAL NAVD 88  
 HORIZONTAL NAD 83 (92)

SCALE 1" = 20'-0"  
 20 0 20



PROJECT NAME: THETFORD  
 PROJECT NUMBER: BHF 0177(9)  
 FILE NAME: z08j174bdr\_ero.dgn PLOT DATE: 2/15/2012  
 PROJECT LEADER: M.A. COLGAN DRAWN BY: B.M. KLINEFELTER  
 DESIGNED BY: S.E. BURBANK CHECKED BY: S.E. BURBANK  
 EPSC EXISTING COND. SITE PLAN (2 OF 2) SHEET 17 OF 78