


LEGEND

- FILTER CURTAIN
- WOVEN WIRE REINFORCED SILT FENCE
- LIMITS OF SOIL DISTURBANCE
- EROSION MATTING
- PROJECT DEMARCATION FENCE
- STABILIZED CONSTRUCTION ENTRANCE
- RIPARIAN BUFFER ZONE
- FILTER FABRIC DROP INLET PROTECTION
- AERIAL ELECTRIC & TELEPHONE
- PROPOSED DEWATERING AREA

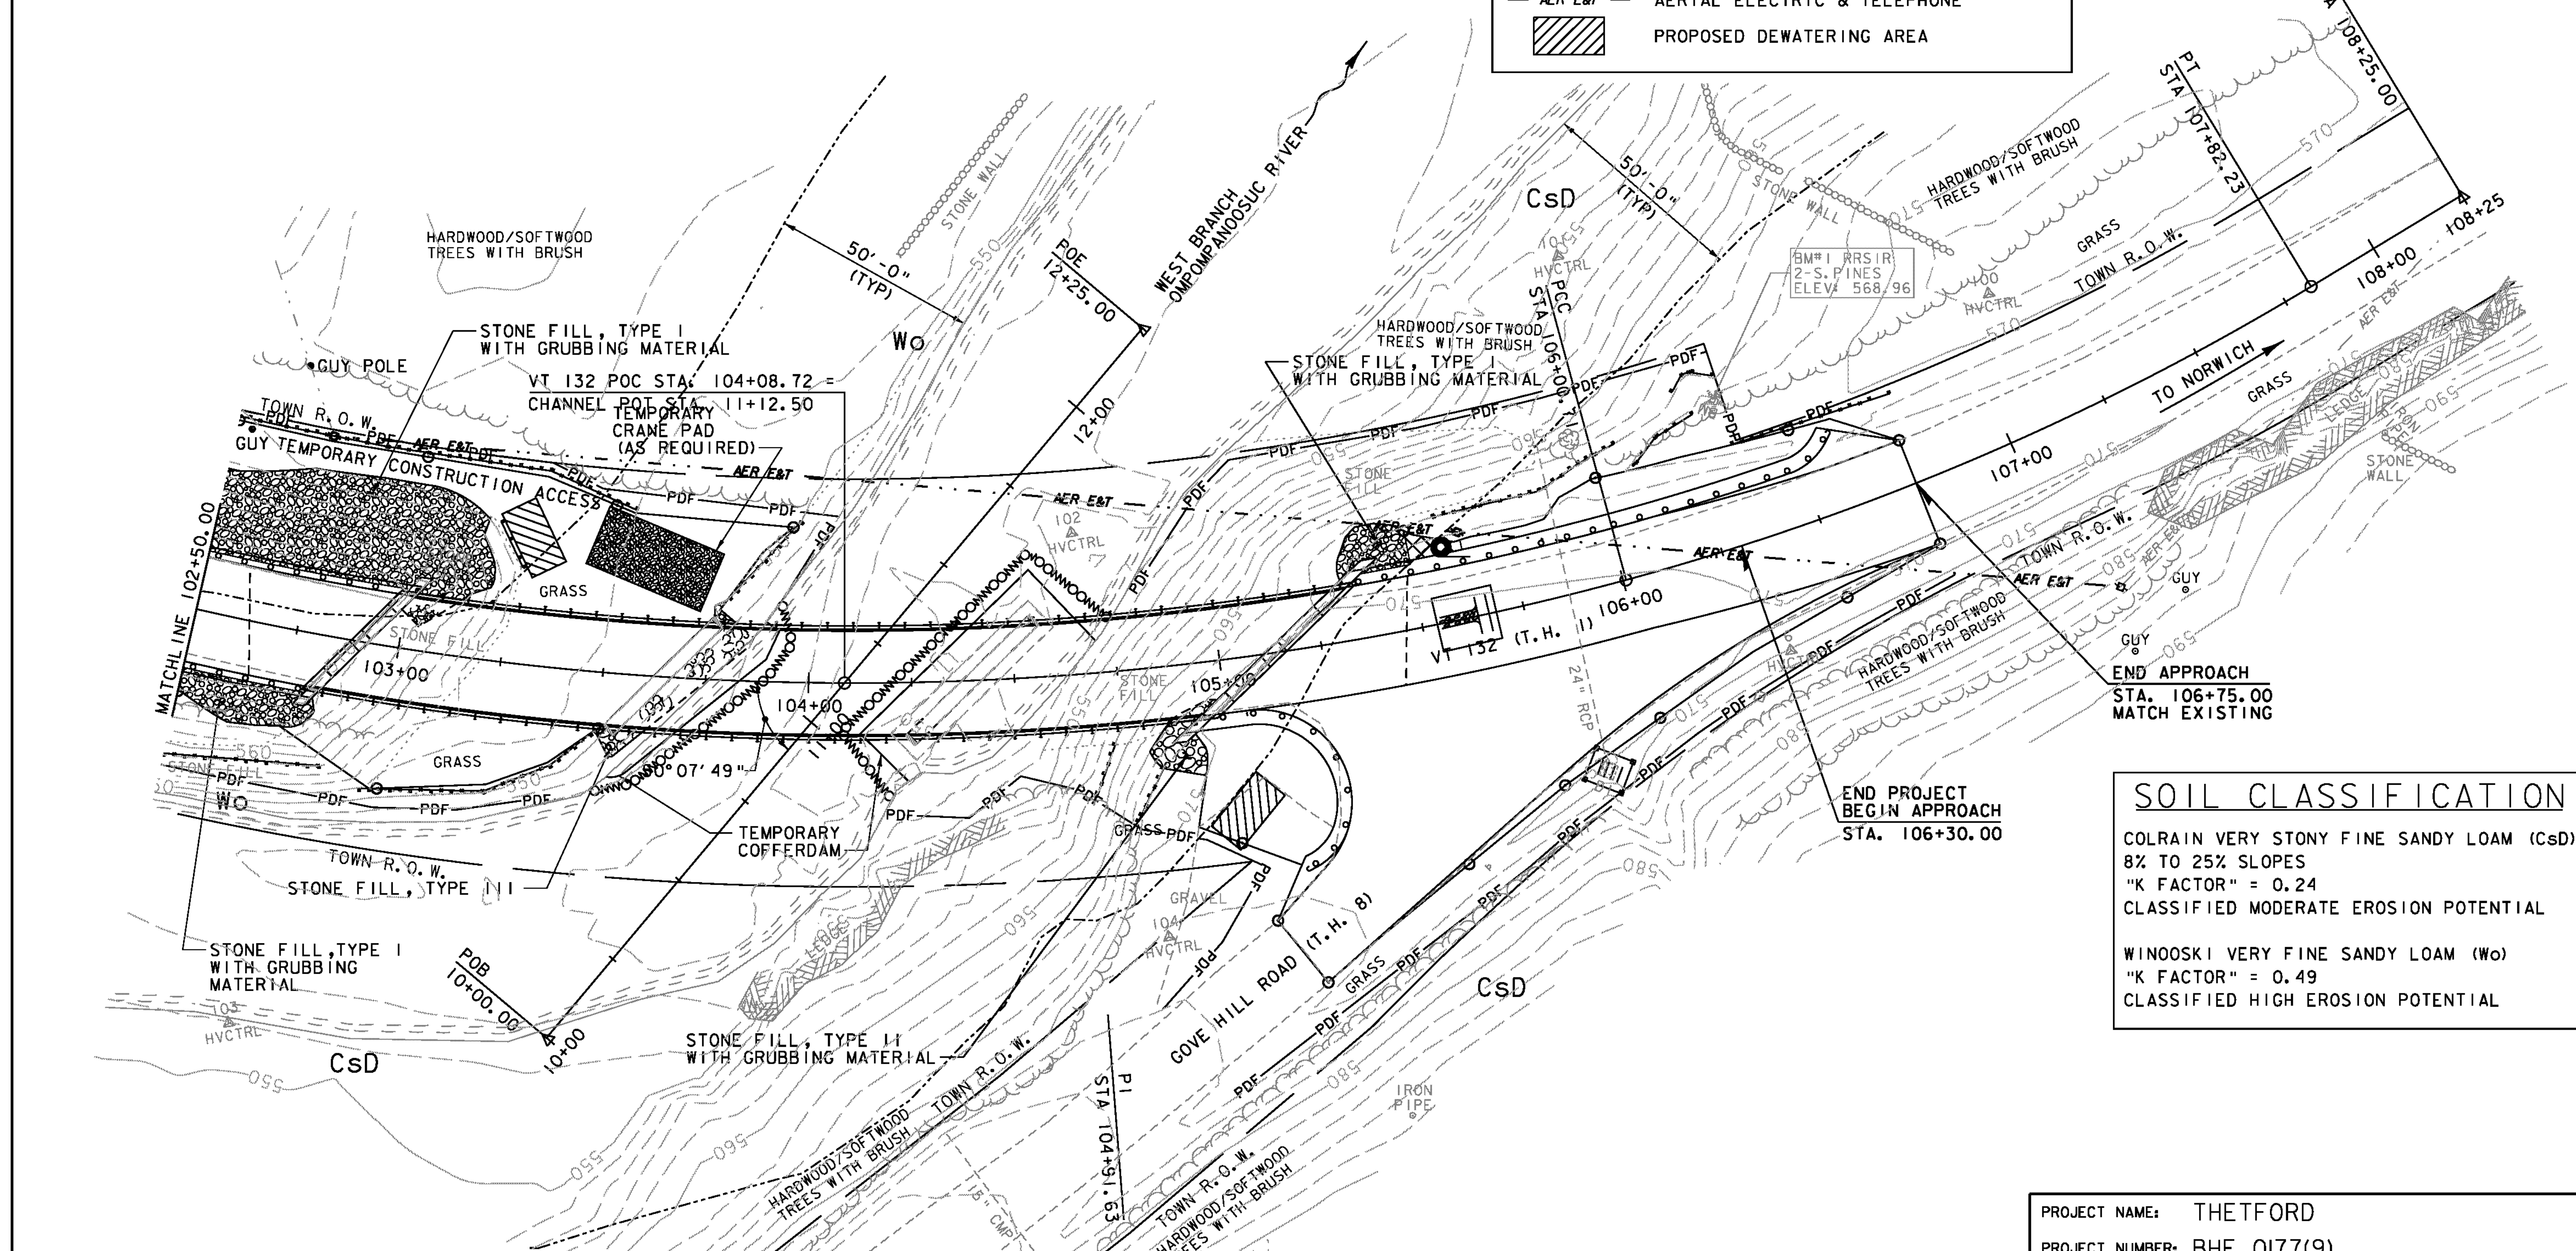

SOIL CLASSIFICATION

COLRAIN VERY STONY FINE SANDY LOAM (CSD)
 8% TO 25% SLOPES
 "K FACTOR" = 0.24
 CLASSIFIED MODERATE EROSION POTENTIAL

WINOOSKI VERY FINE SANDY LOAM (WO)
 "K FACTOR" = 0.49
 CLASSIFIED HIGH EROSION POTENTIAL

DATUM

VERTICAL NAVD 88
 HORIZONTAL NAD 83 (92)

SCALE 1" = 20'-0"
 20 0 20



PROJECT NAME: THETFORD
 PROJECT NUMBER: BHF 0177(9)

FILE NAME: z08j174bdr_ero.dgn PLOT DATE: 2/15/2012
 PROJECT LEADER: M.A. COLGAN DRAWN BY: B.M. KLINEFELTER
 DESIGNED BY: S.E. BURBANK CHECKED BY: S.E. BURBANK
 EPSC CONSTRUCTION SITE PLAN (2 OF 2) SHEET 19 OF 78