


PLAN  
SCALE 1" = 10'-0"

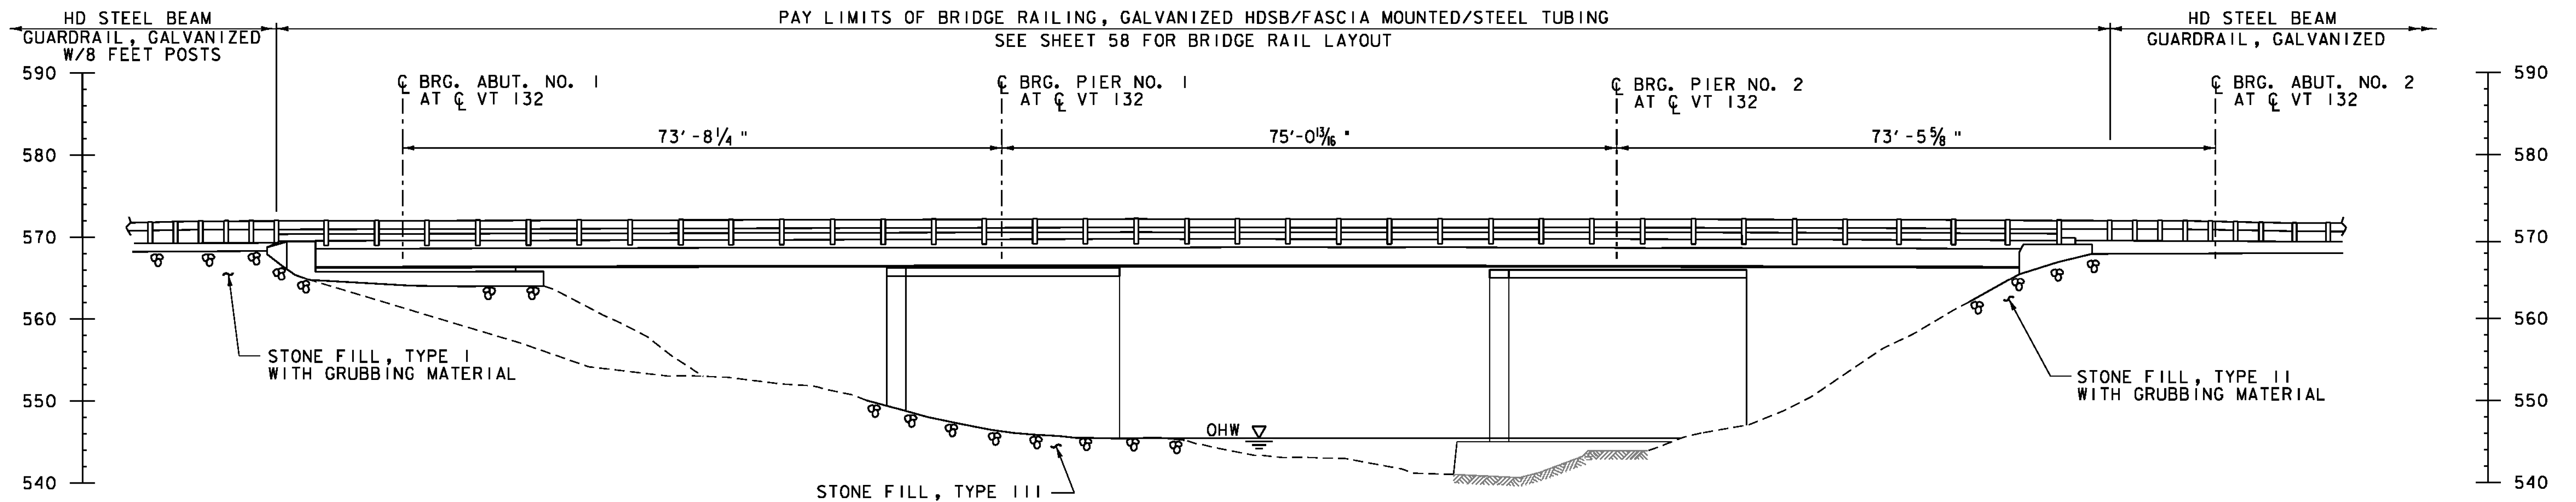

ELEVATION AT UPSTREAM FASCIA  
SCALE 1" = 10'-0"

DATUM  
VERTICAL NAVD 88  
HORIZONTAL NAD 83 (92)



PROJECT NAME: THETFORD	PLOT DATE: 2/15/2012
PROJECT NUMBER: BHF 0177(9)	DRAWN BY: J.W. GOLEK
FILE NAME: z08j174pe.dgn	CHECKED BY: S.E. BURBANK
PROJECT LEADER: M.A. COLGAN	SHEET 30 OF 78
DESIGNED BY: S.E. BURBANK	
PLAN AND ELEVATION	