



NOTE: METAL STAY-IN-PLACE FORMS NOT SHOWN FOR CLARITY.

TYPICAL BRIDGE SECTION  
SCALE 1/2" = 1'-0"

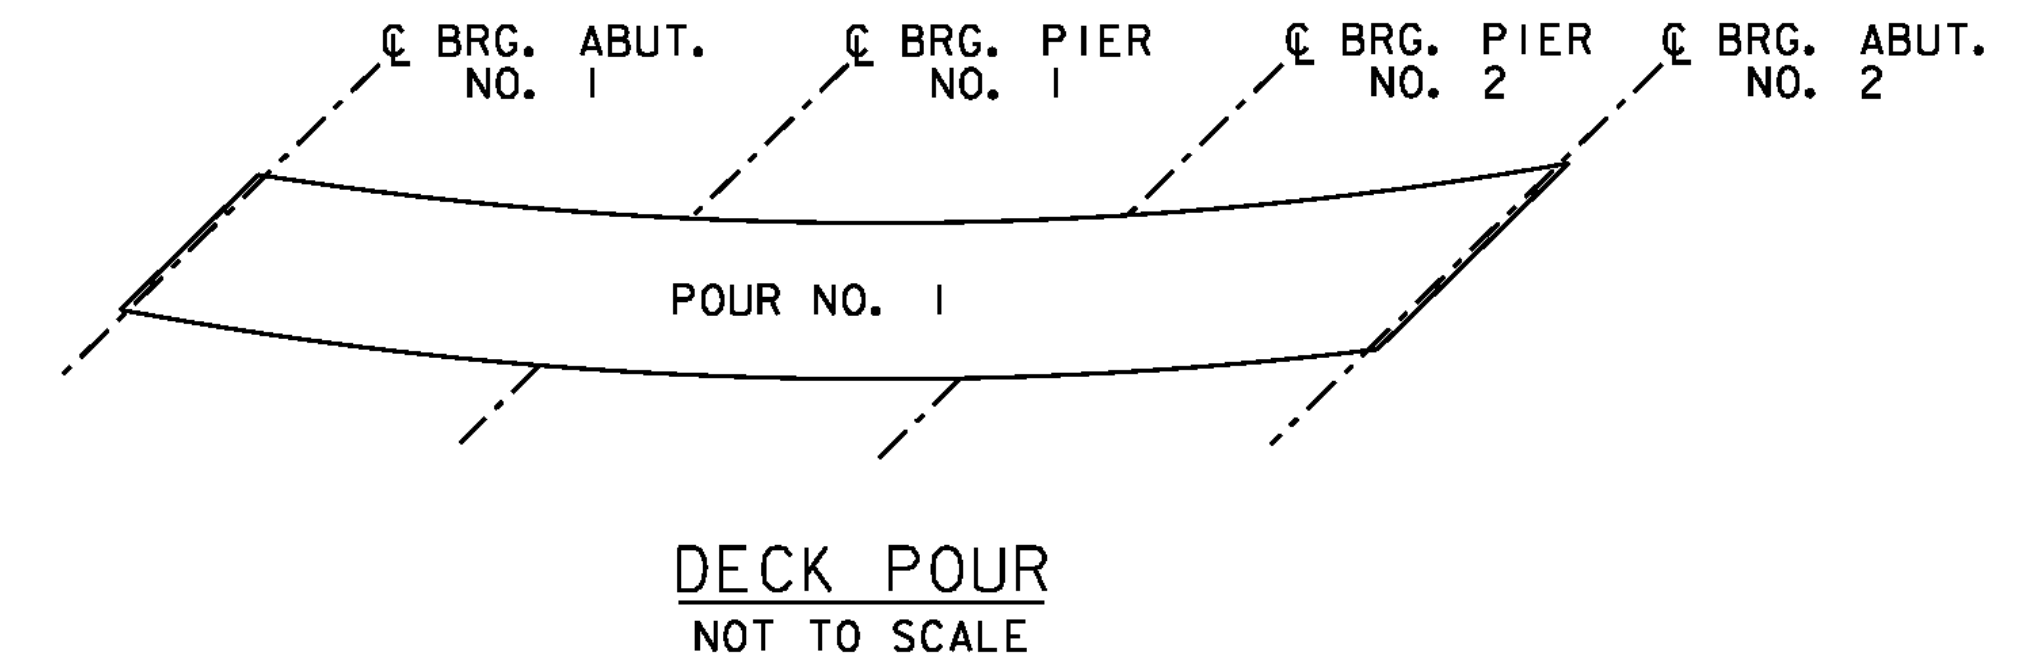


NOTES:

1. THE CONCRETE SHALL BE DEPOSITED BY BEGINNING AT THE LOWER END OF THE BRIDGE AND WORKING TOWARD THE UPPER END OF THE BRIDGE.
2. IF AN ALTERNATE POUR SEQUENCE IS USED, IT MUST BE APPROVED BY THE PROJECT MANAGER PRIOR TO THE APPROVAL OF THE STEEL FABRICATION DRAWINGS.

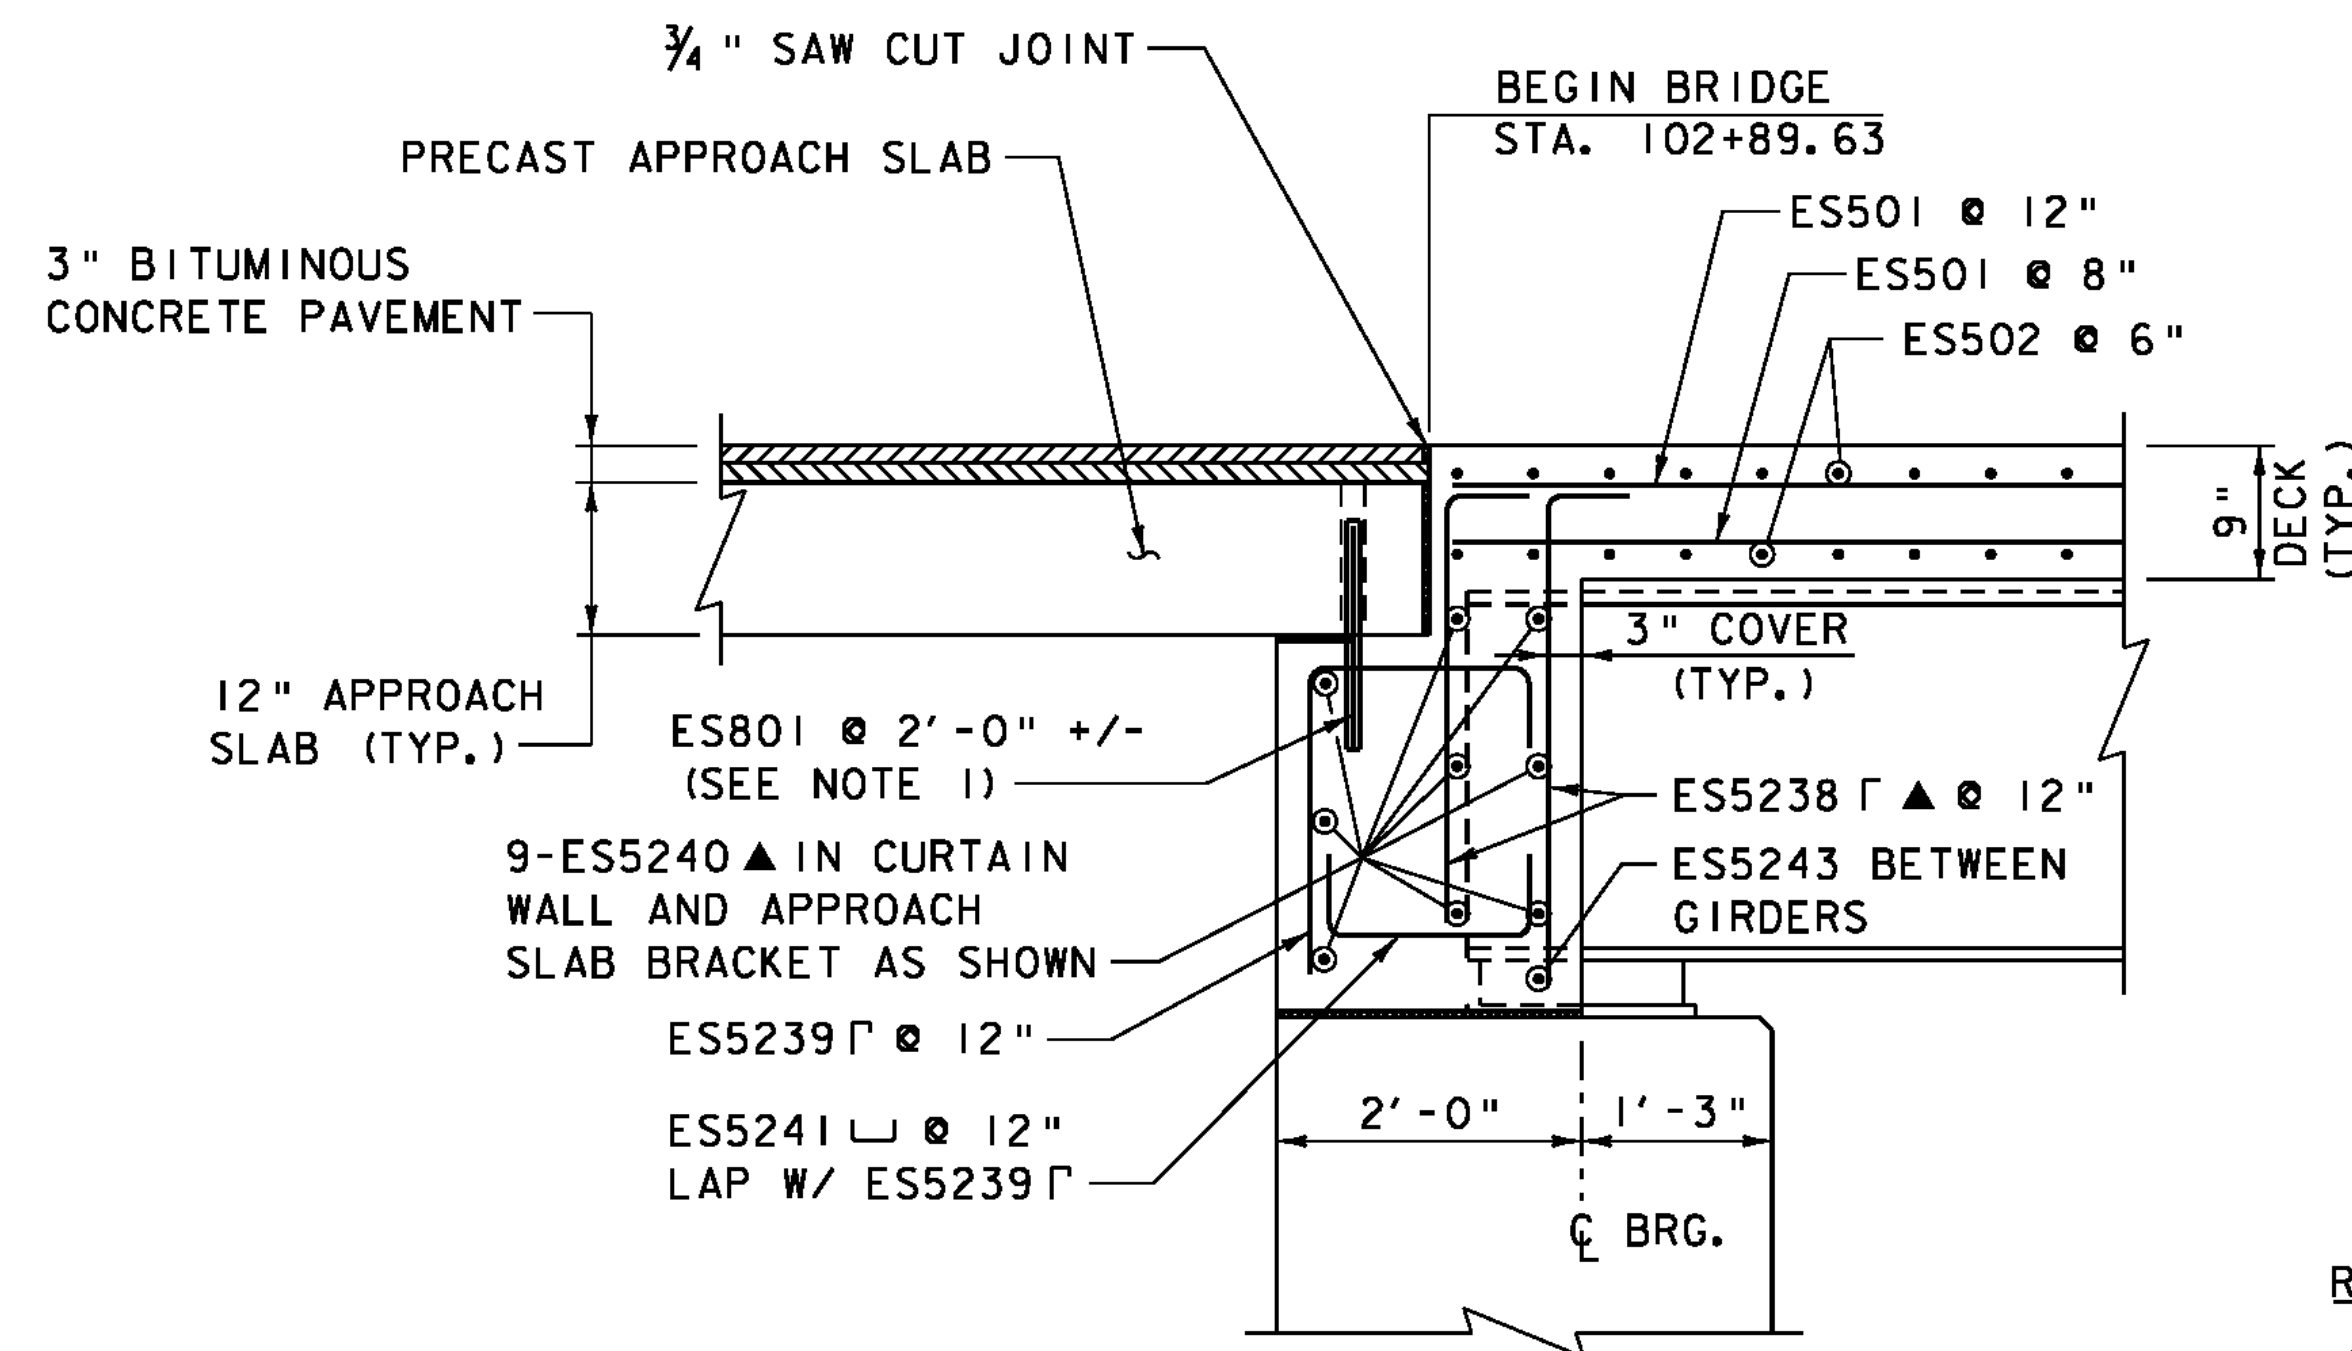

BRIDGE END DETAIL ABUTMENT NO. 1  
SCALE 3/4" = 1'-0"

REINFORCING KEY:  
▲ CUT IN FIELD

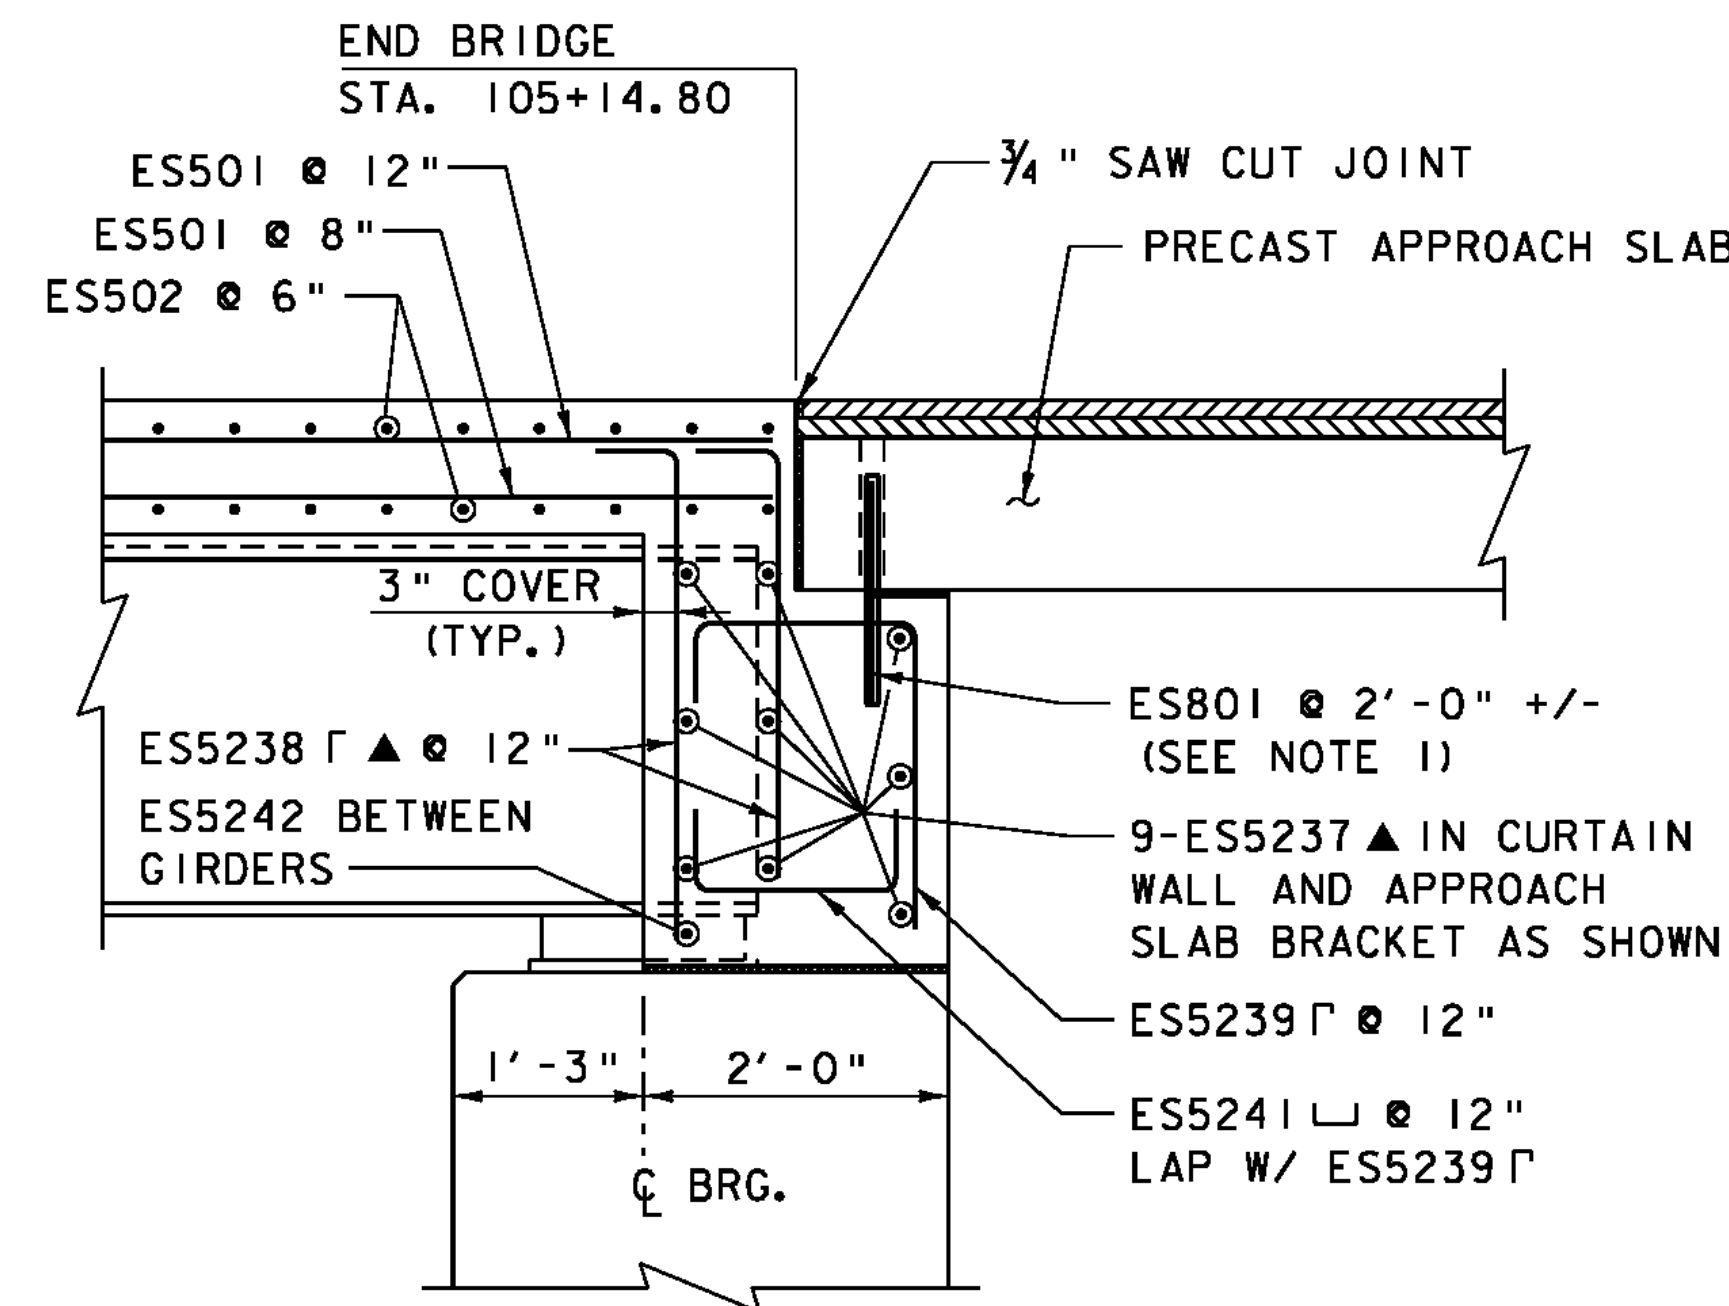

BRIDGE END DETAIL ABUTMENT NO. 2  
SCALE 3/4" = 1'-0"

NOTE:

1. APPROACH SLAB DOWEL LOCATIONS TO BE COORDINATED WITH PRECAST APPROACH SLAB FABRICATOR TO ENSURE PROPER FIT-UP IN FIELD.

PROJECT NAME: THETFORD  
PROJECT NUMBER: BHF 0177(9)

FILE NAME: z08j174deckr3.dgn  
PROJECT LEADER: M.A. COLGAN  
DESIGNED BY: G.S. GOODRICH  
TYPICAL DECK SECTIONS

PLOT DATE: 2/15/2012  
DRAWN BY: K.D. WENTWORTH  
CHECKED BY: M.J. MOZER  
SHEET 33 OF 78