


**ABUTMENT NO. 1**  
SCALE 3/8" = 1'-0"

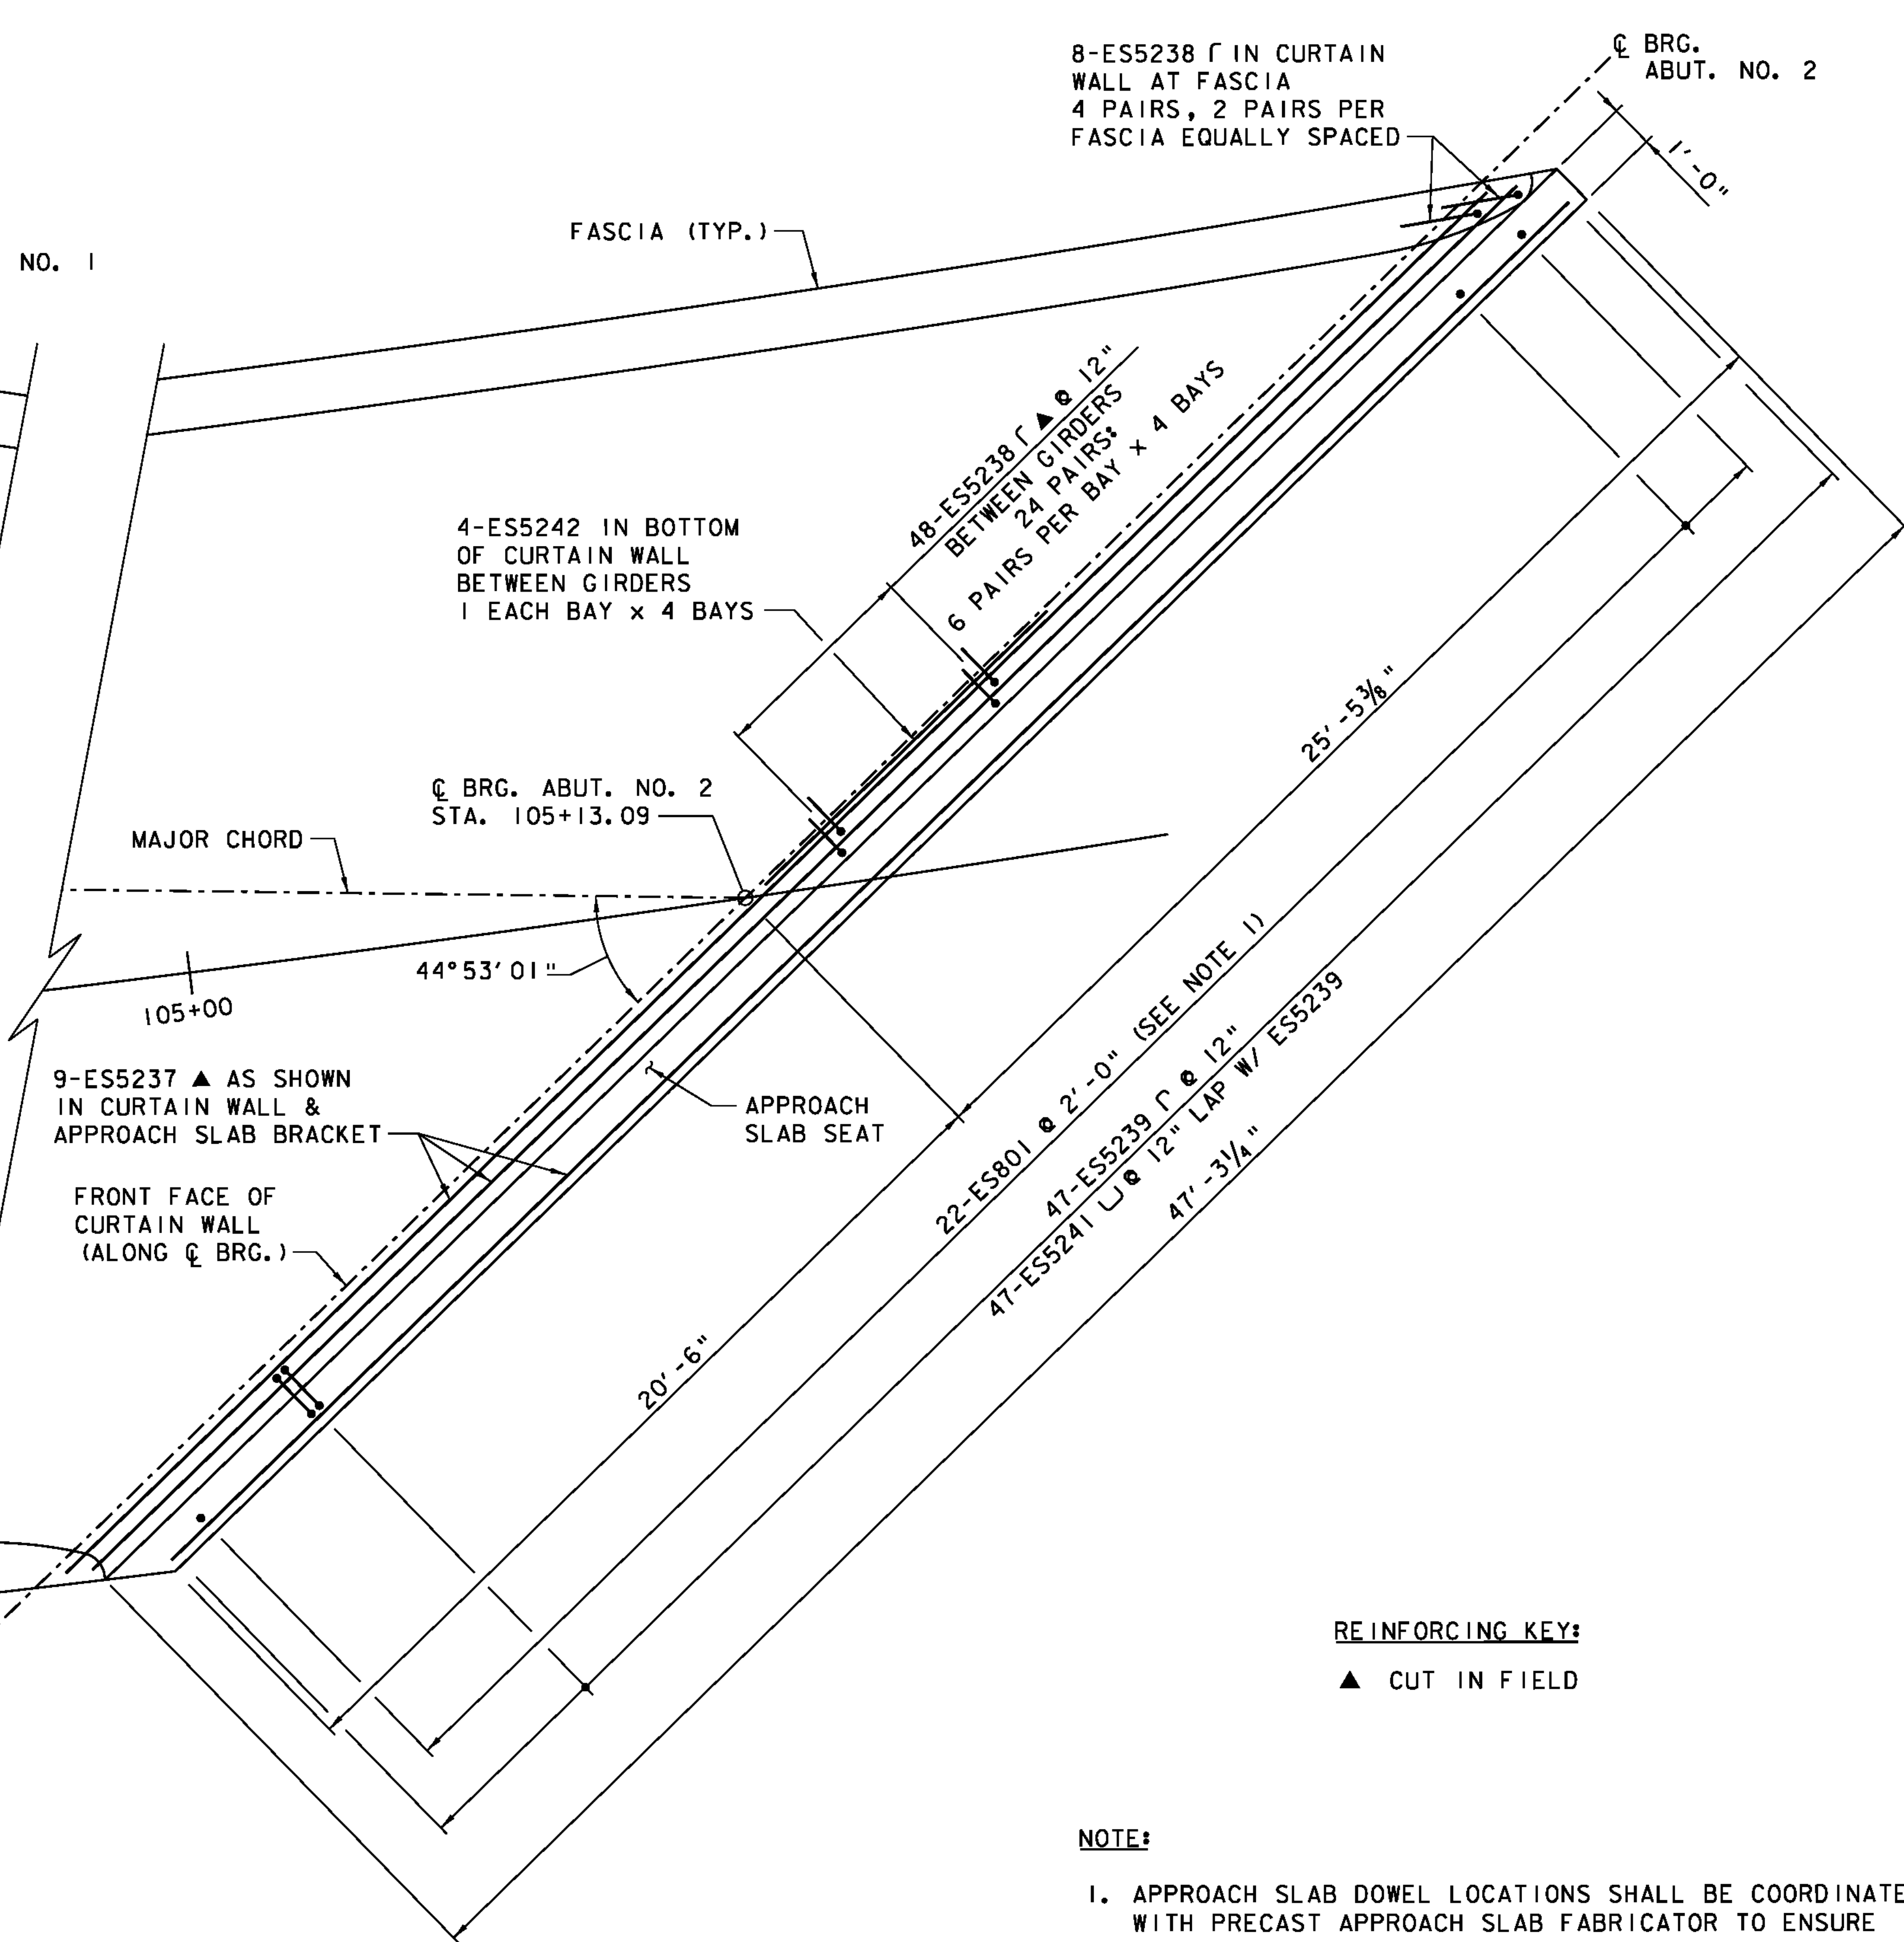

**ABUTMENT NO. 2**  
SCALE 3/8" = 1'-0"

**REINFORCING KEY:**  
▲ CUT IN FIELD

**NOTE:**

- APPROACH SLAB DOWEL LOCATIONS SHALL BE COORDINATED WITH PRECAST APPROACH SLAB FABRICATOR TO ENSURE PROPER FIT-UP.

PROJECT NAME:	THETFORD		
PROJECT NUMBER:	BHF 0177(9)		
FILE NAME:	z08j174deckr4.dgn	PLOT DATE:	2/15/2012
PROJECT LEADER:	M.A. COLGAN	DRAWN BY:	B.J. MASSE
DESIGNED BY:	G.S. GOODRICH	CHECKED BY:	M.J. MOZER
CURTAIN WALL REINFORCING PLAN			SHEET 36 OF 78

