



TOP FLANGE PLAN

SCALE 1/2" = 1'-0"

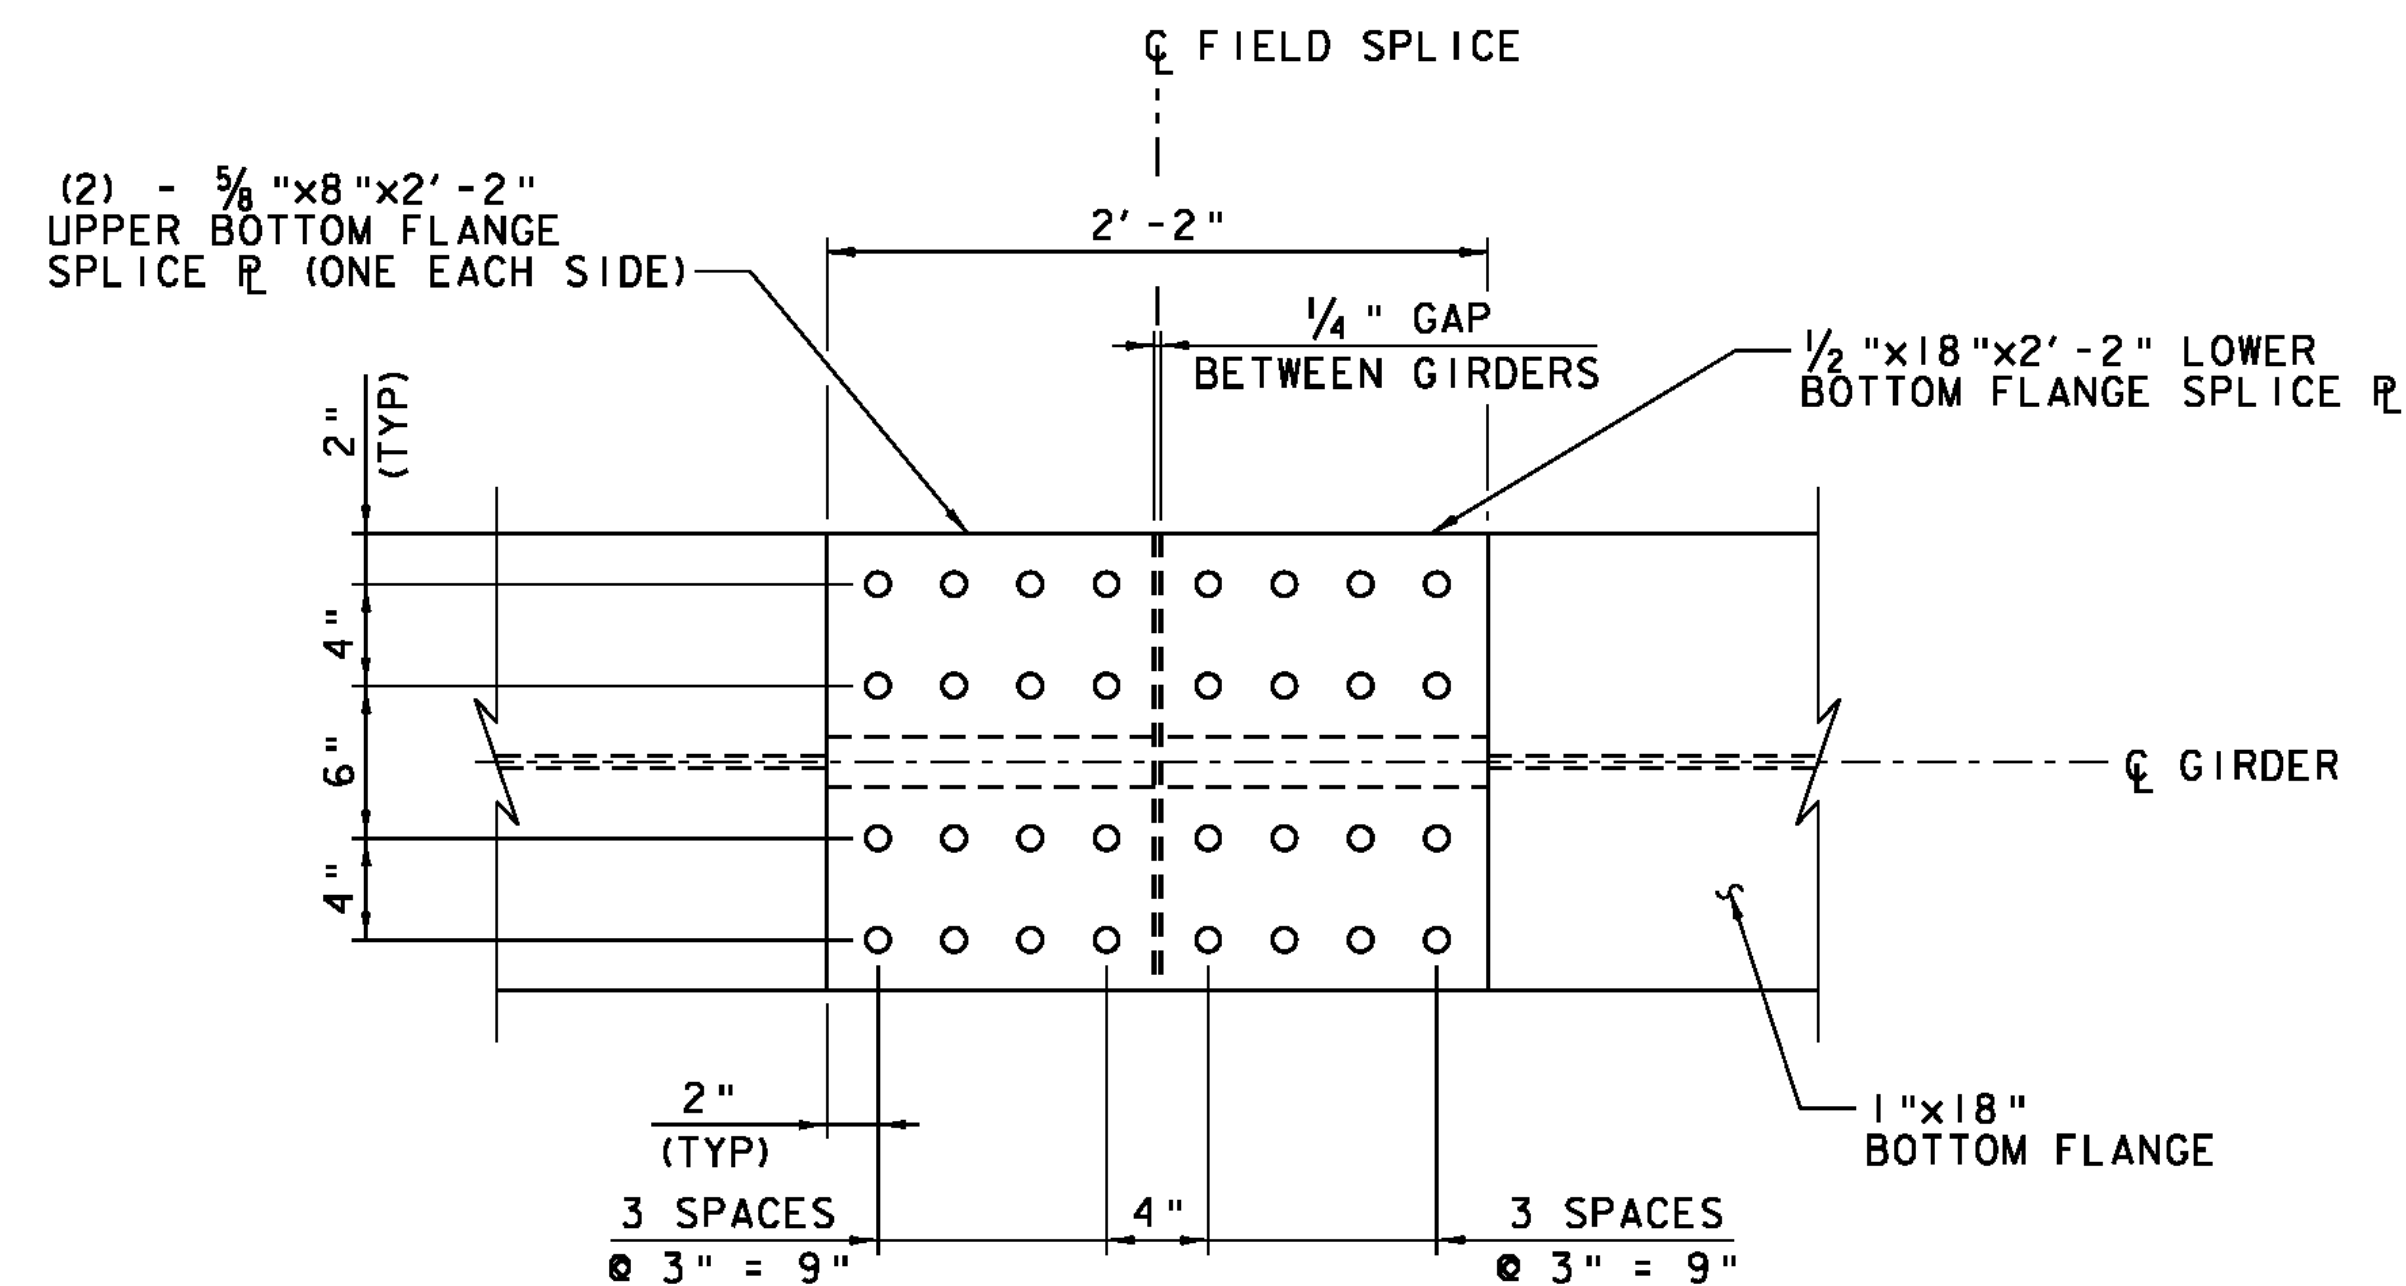


BOTTOM FLANGE PLAN

SCALE 1/2" = 1'-0"

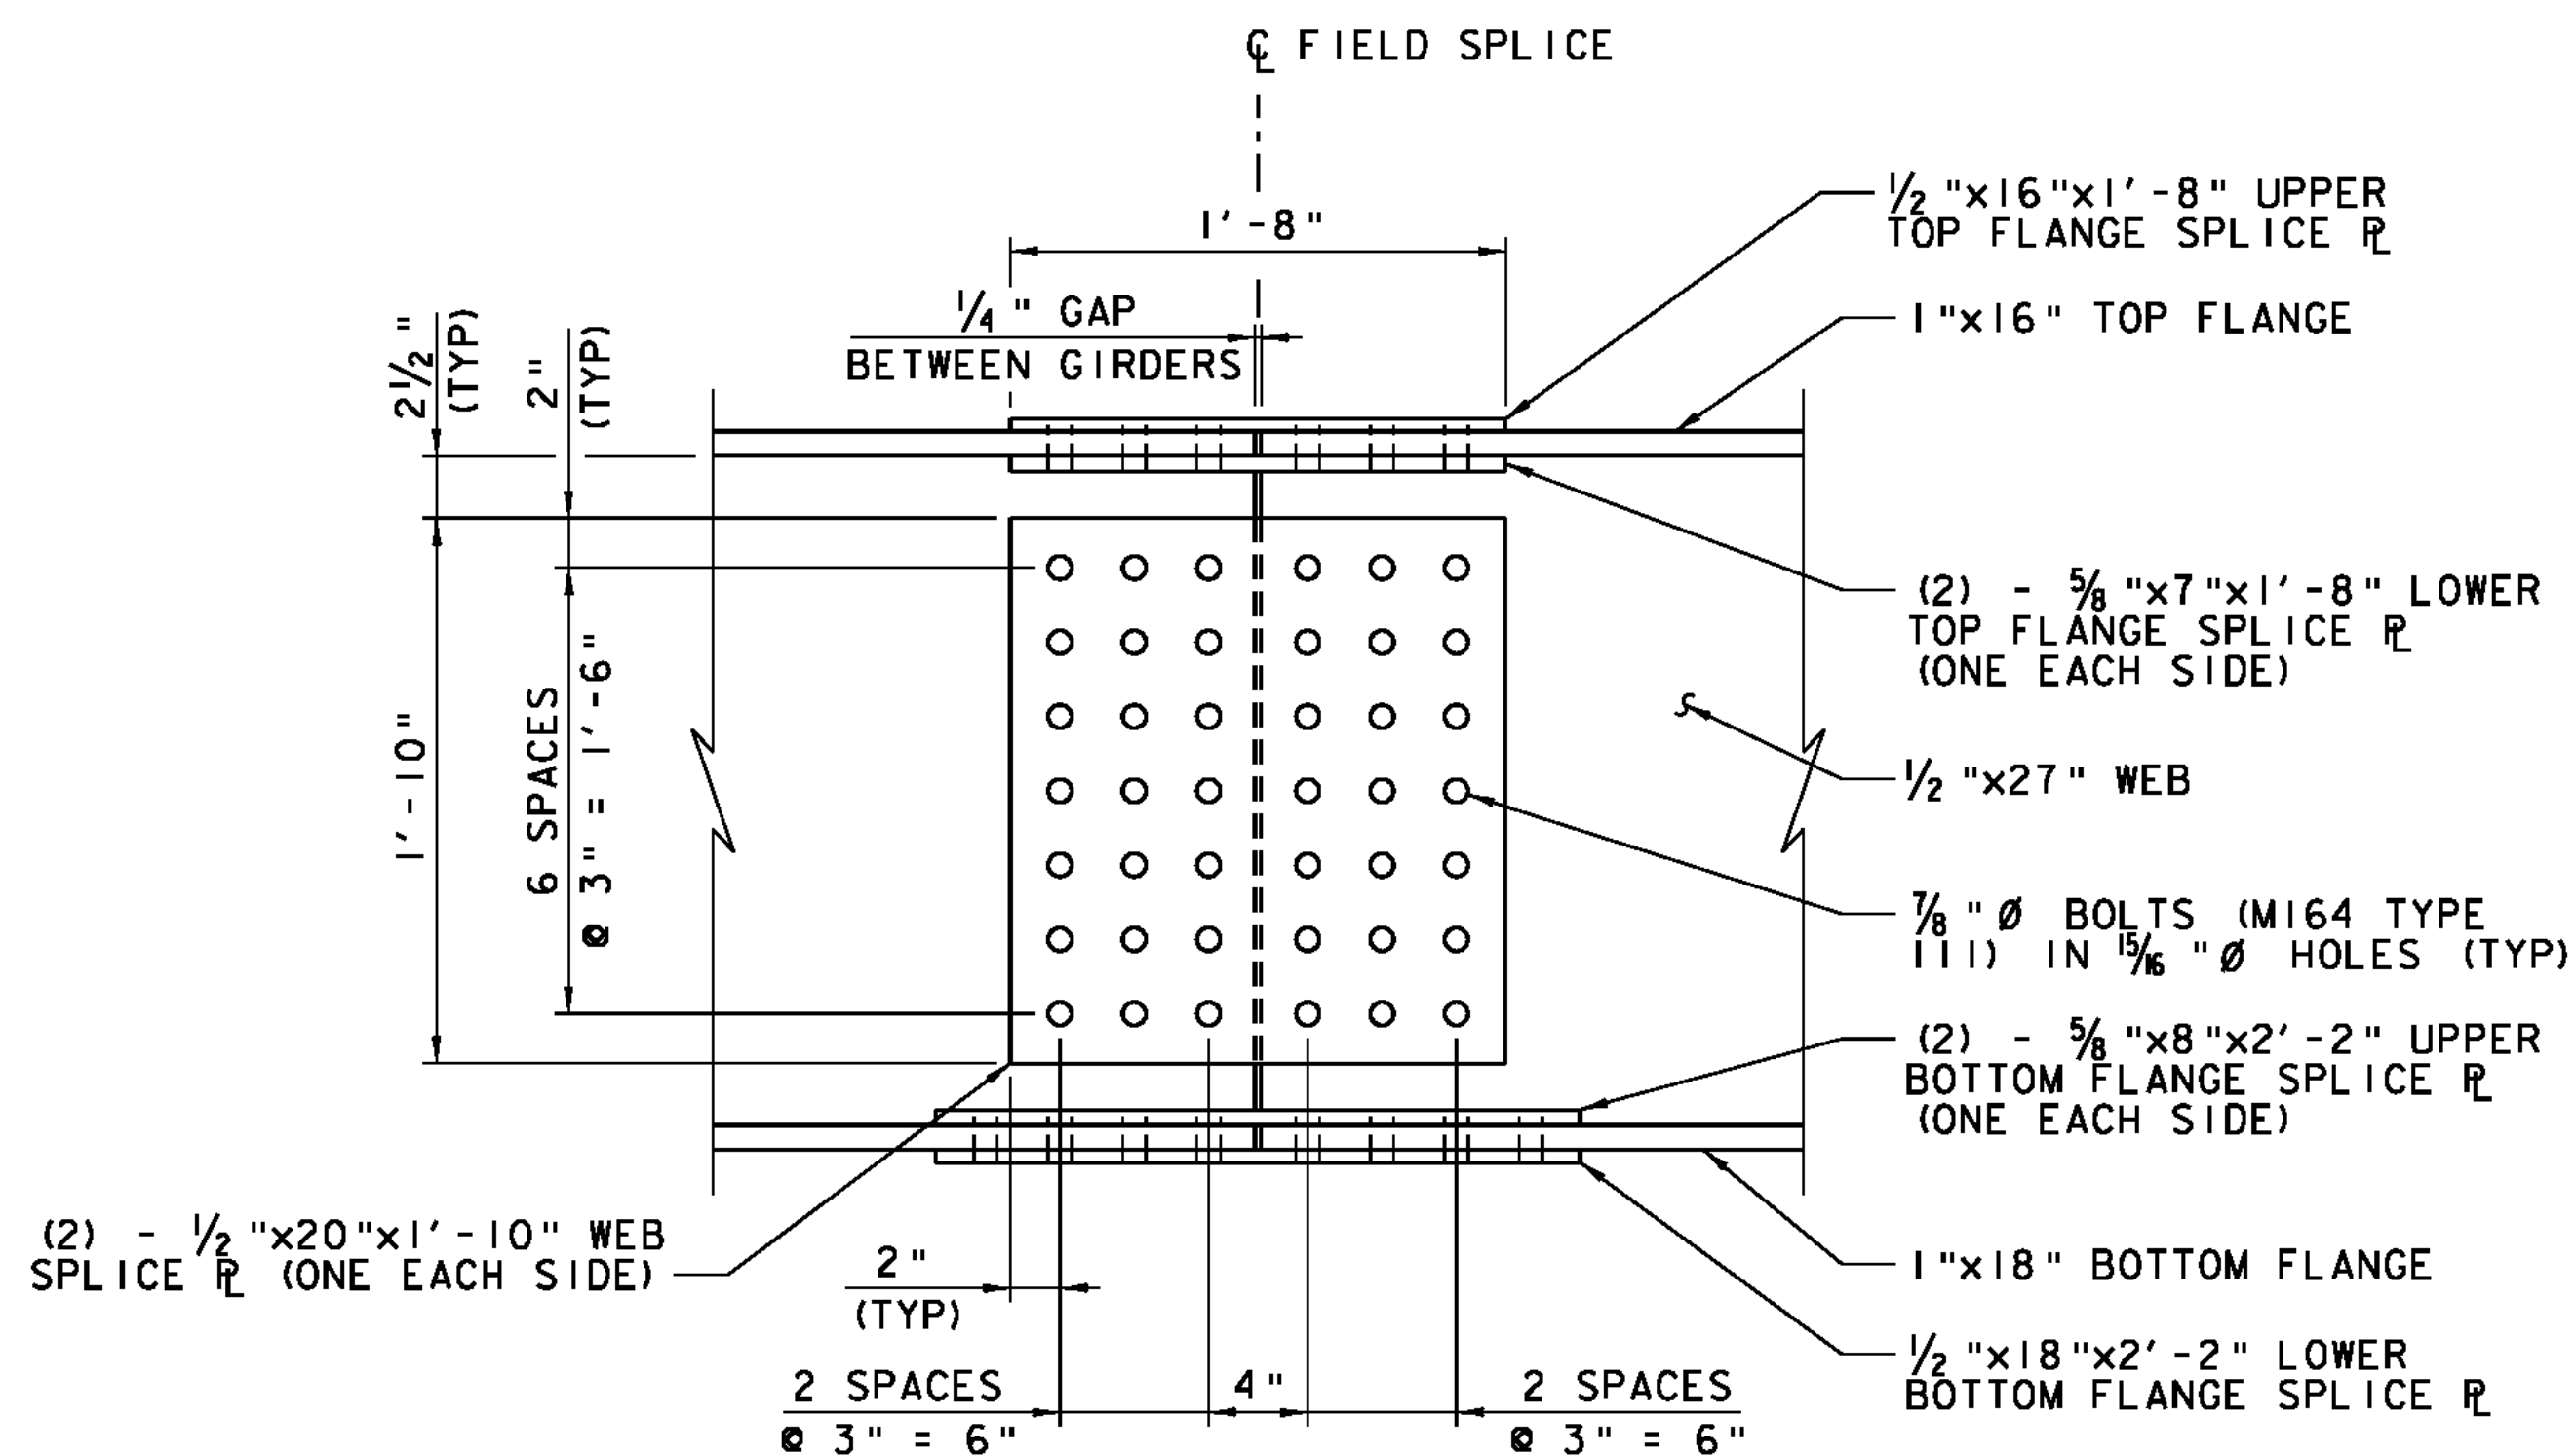

SPlice ELEVATION

SCALE 1/2" = 1'-0"

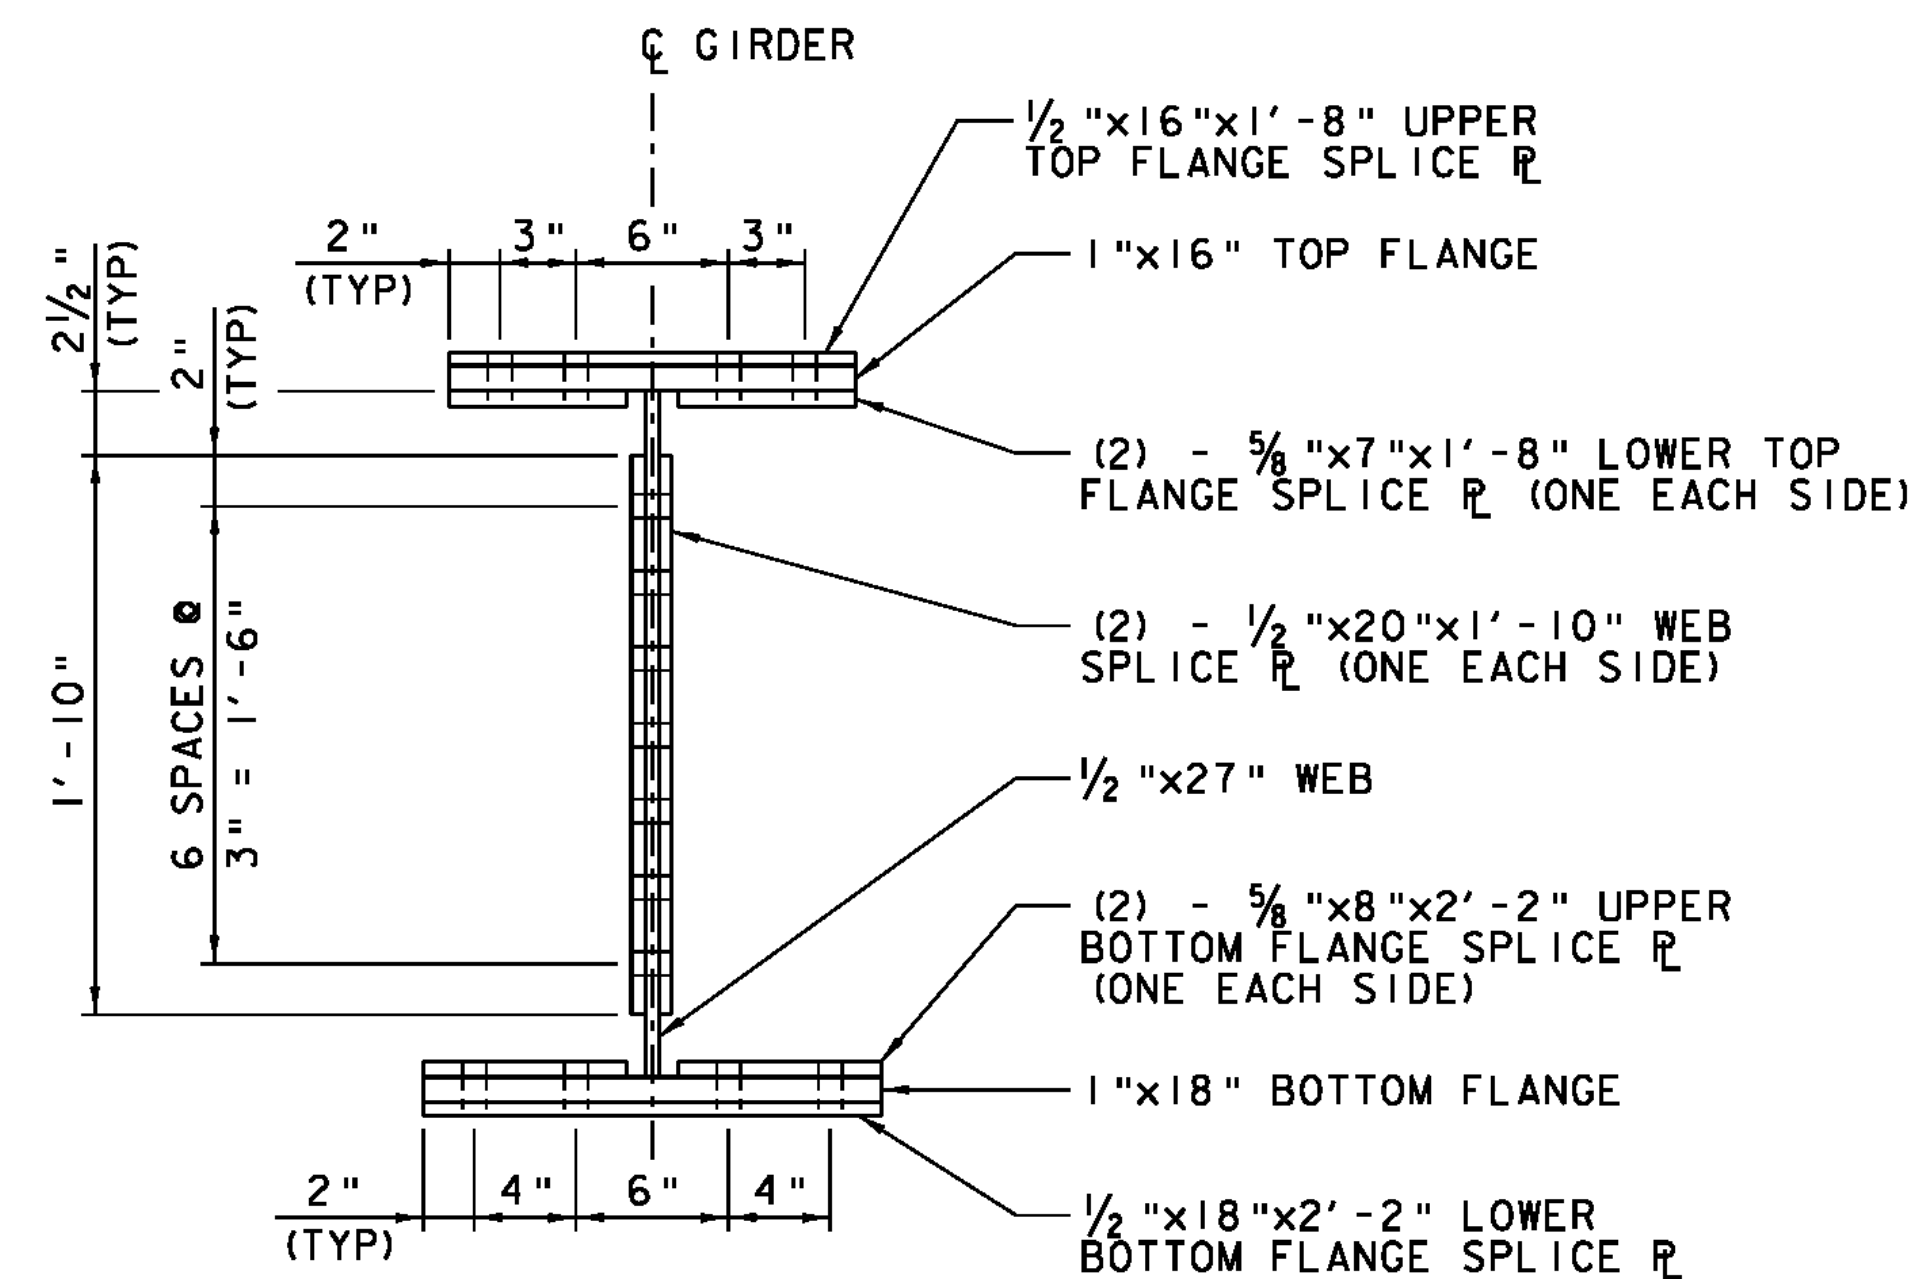

SPlice SECTION

SCALE 1/2" = 1'-0"

NOTE: ALL SECTIONS OF SPLICE SHALL BE CVN (CHARPY V-NOTCH) TESTED.



PROJECT NAME: THETFORD

PROJECT NUMBER: BHF 0177(9)

FILE NAME: z08j174sup04.dgn

PROJECT LEADER: M.A. COLGAN

DESIGNED BY: G.S. GOODRICH

FIELD SPLICE DETAILS

PLOT DATE: 2/15/2012

DRAWN BY: K.D. WENTWORTH

CHECKED BY: M.J. MOZER

SHEET 41 OF 78