


ABUTMENT NO. 2 PLAN  
SCALE 1/4" = 1'-0"

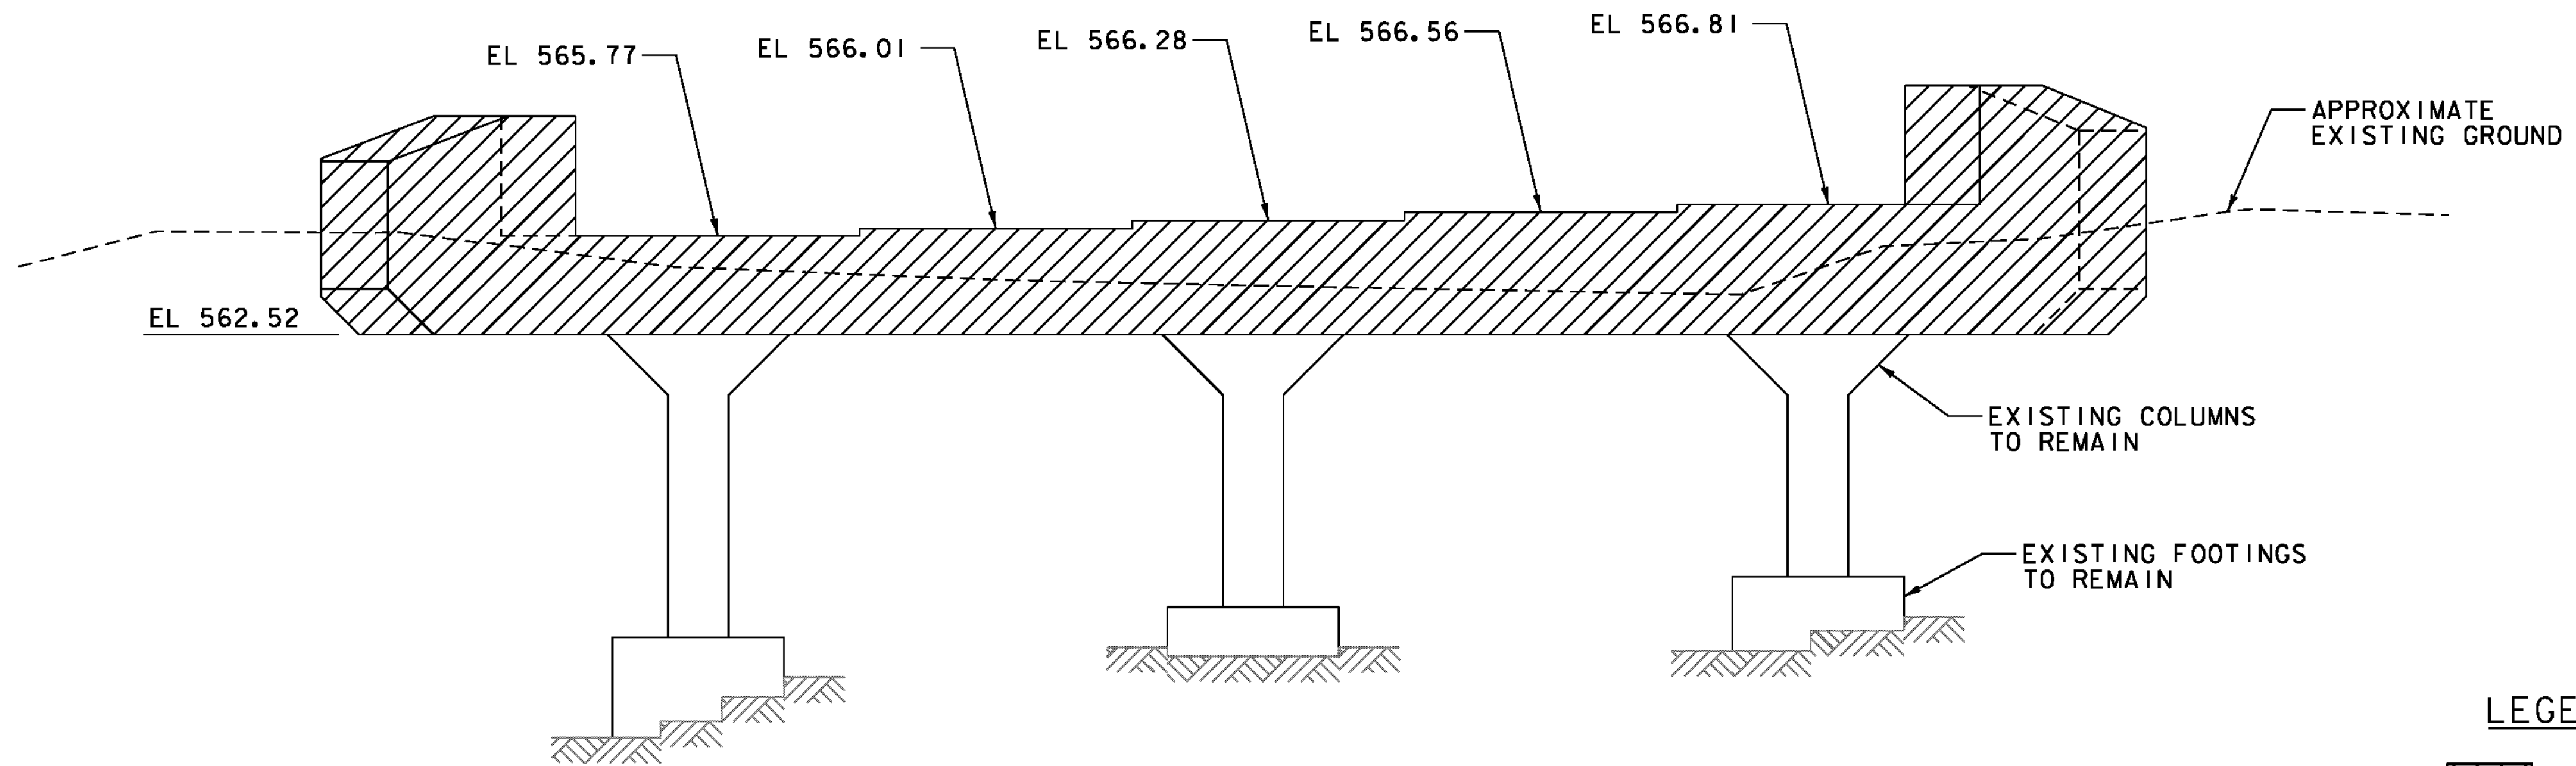

ABUTMENT NO. 2 ELEVATION  
SCALE 1/4" = 1'-0"

LEGEND

 DENOTES LIMIT OF REMOVAL

NOTES:

1. SEE SHEET 32 FOR REMOVAL AND REPAIR NOTES.
2. EXISTING STRUCTURE AND ELEVATIONS SHOWN.

PROJECT NAME: THETFORD

PROJECT NUMBER: BHF 0177(9)

FILE NAME: z08j174sub\_abut\_2.dgn

PROJECT LEADER: M.A. COLGAN

DESIGNED BY: S.E. BURBANK

ABUTMENT NO. 2 REMOVAL PLAN

PLOT DATE: 2/15/2012

DRAWN BY: B.M. KLINEFELTER

CHECKED BY: G.S. GOODRICH

SHEET 49 OF 78

