



PIER NO. 1 PLAN
SCALE 1/4" = 1'-0"

NOTE:

- NF = NEAR FACE
- FF = FAR FACE
- EF = EACH FACE
- ▲ = CUT TO FIT IN FIELD
- 4" CLEAR, UNLESS OTHERWISE SPECIFIED ON THE PLANS.
- 2'-2" BAR LAP UNLESS OTHERWISE SPECIFIED ON THE PLANS.

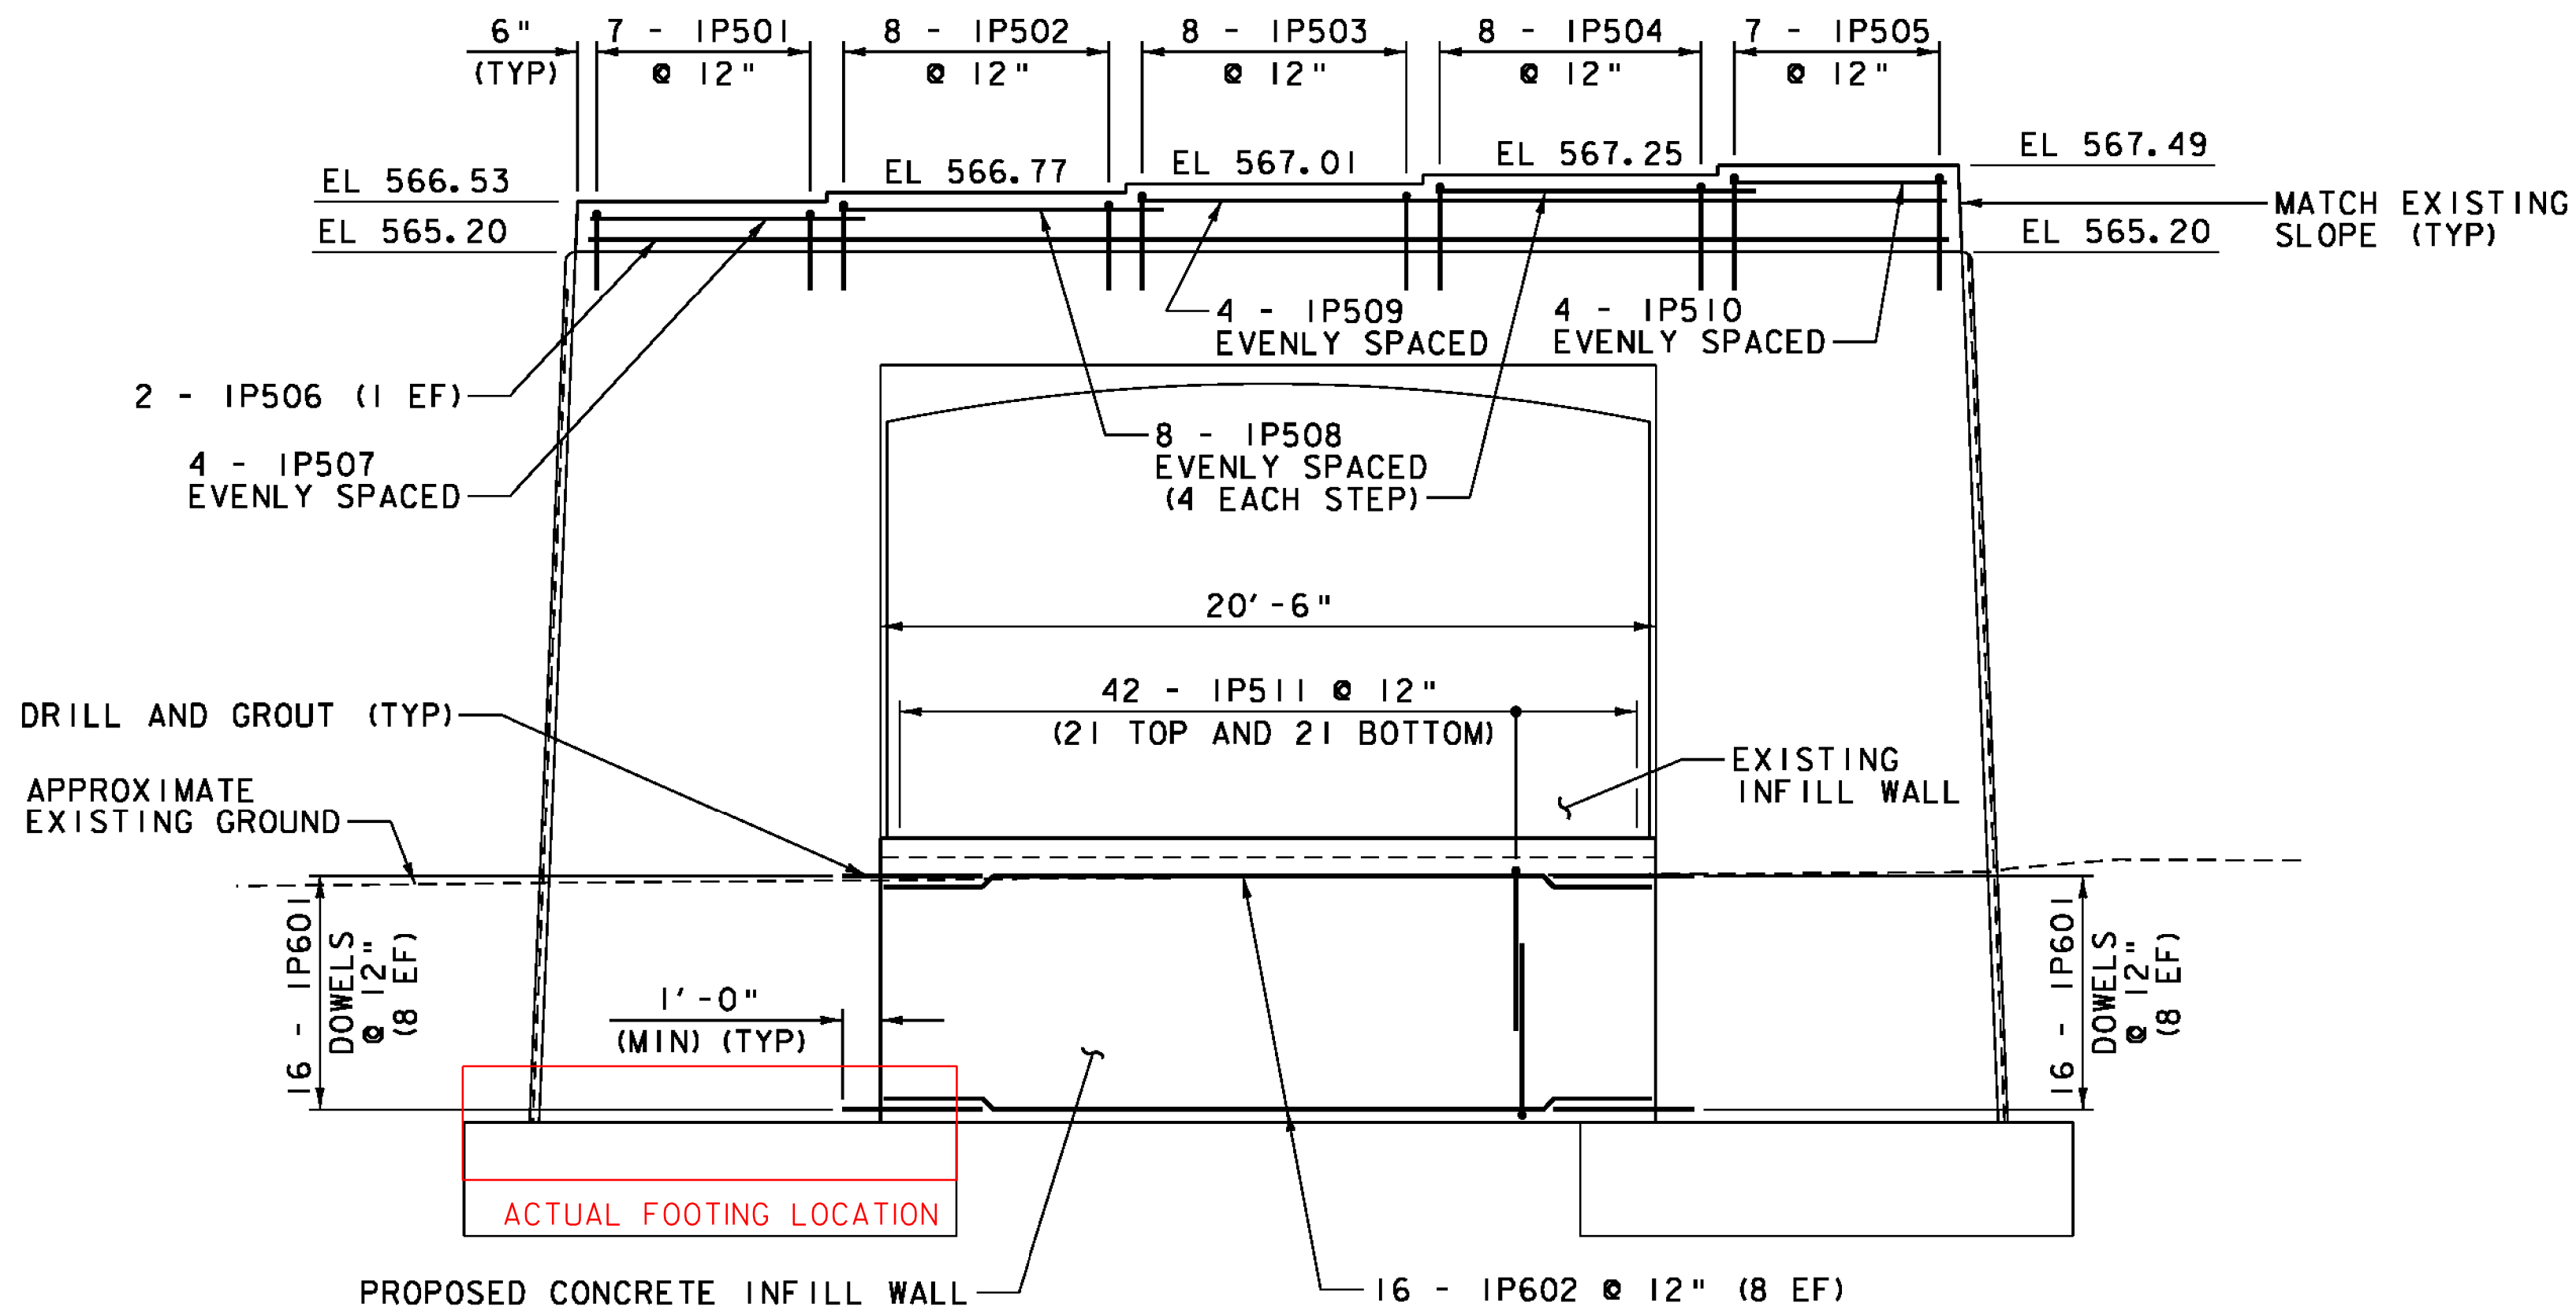

PIER NO. 1 ELEVATION
SCALE 1/4" = 1'-0"

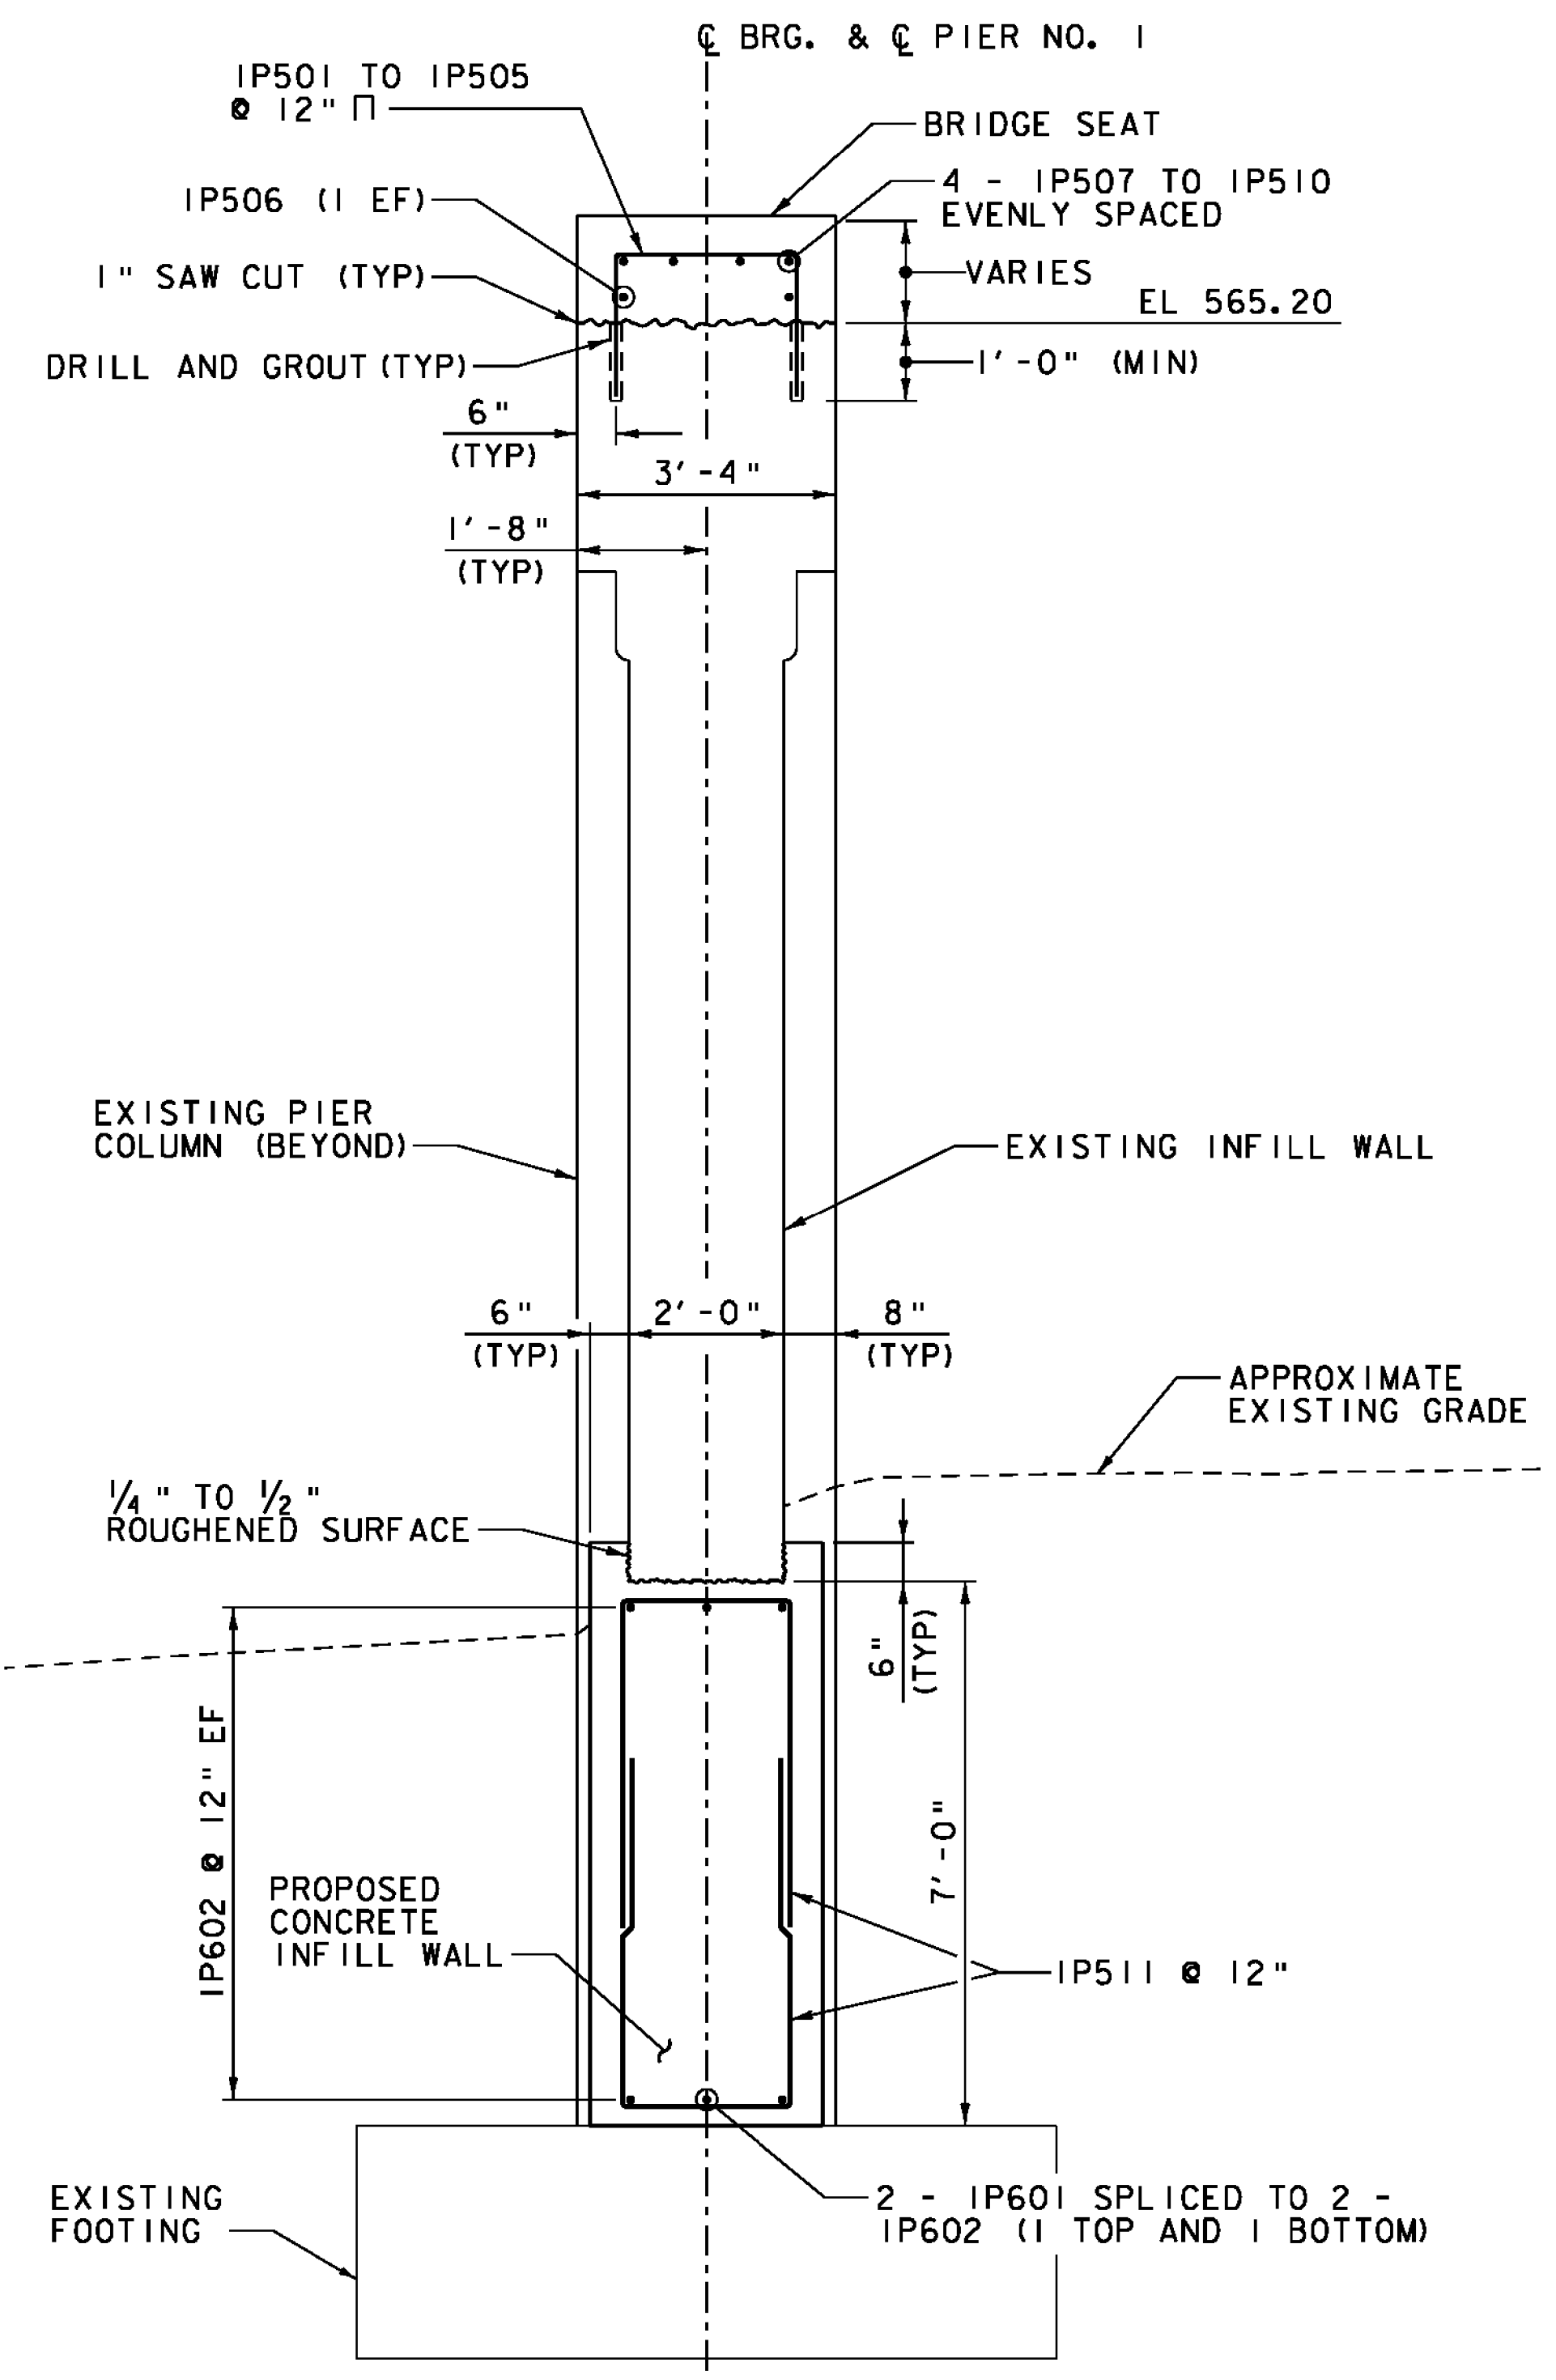

PIER NO. 1 SECTION
SCALE 1/2" = 1'-0"

PROJECT NAME:	THETFORD
PROJECT NUMBER:	BHF 0177(9)
FILE NAME:	z08j174sub.pier_1.dgn
PROJECT LEADER:	M.A. COLGAN
DESIGNED BY:	G.S. GOODRICH
PIER NO.1 DETAILS	
PLOT DATE:	2/15/2012
DRAWN BY:	E.A. FIALA
CHECKED BY:	S.E. BURBANK
SHEET	56 OF 78

