



PIER NO. 2 PLAN
SCALE 1/4" = 1'-0"

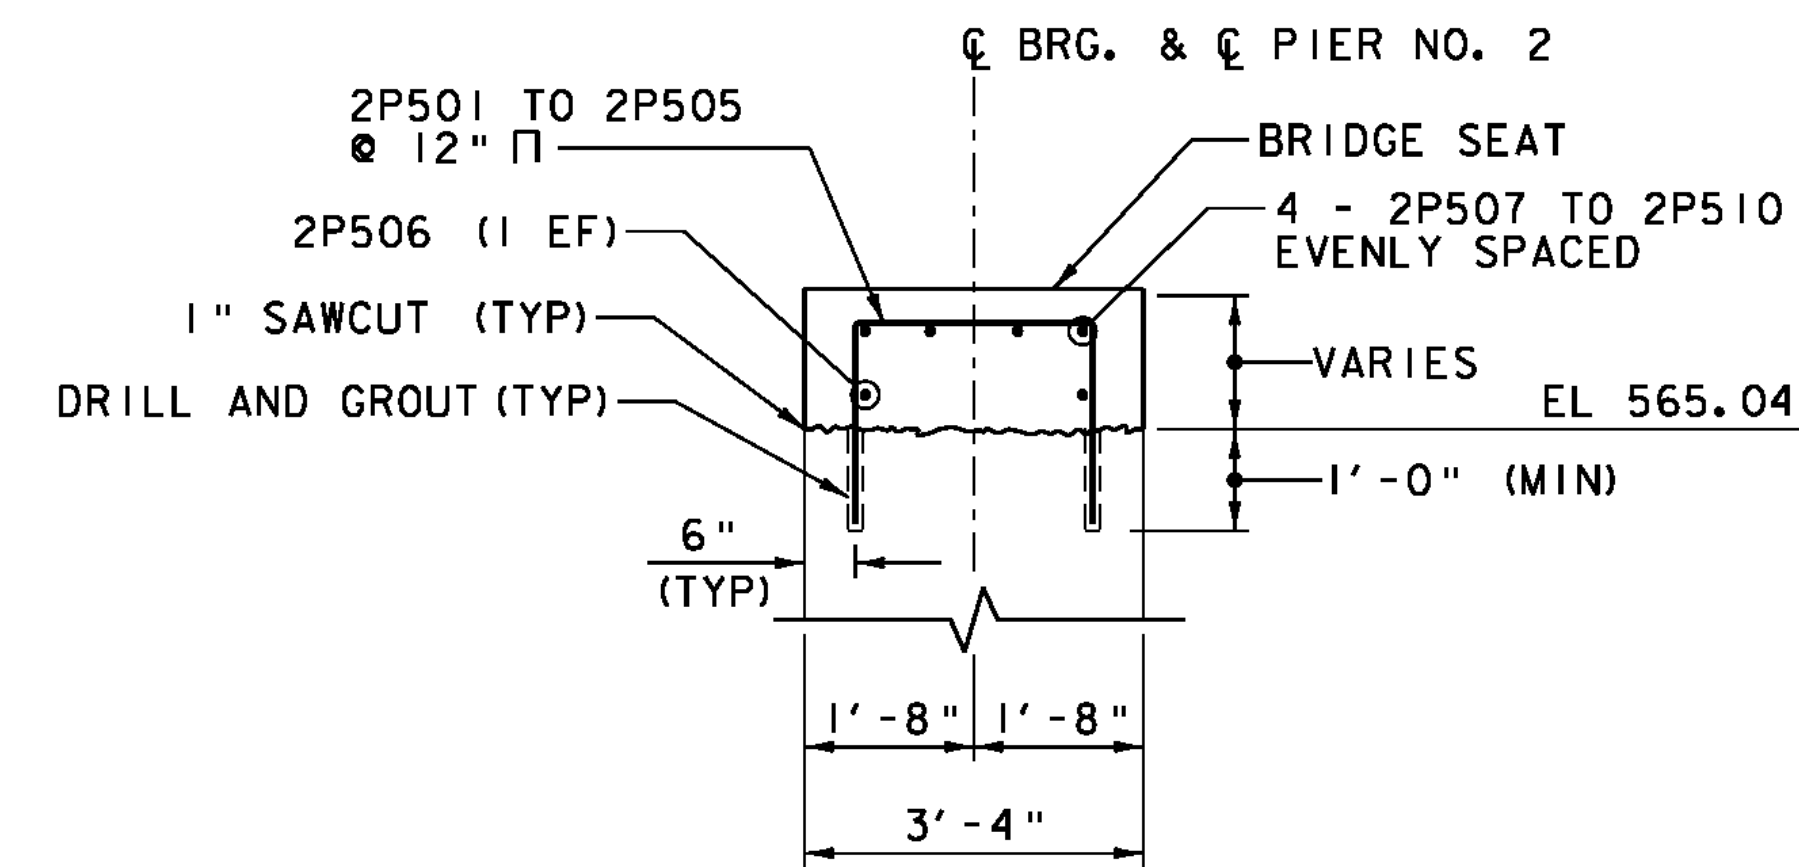

PIER NO. 2 SECTION
SCALE 1/2" = 1'-0"

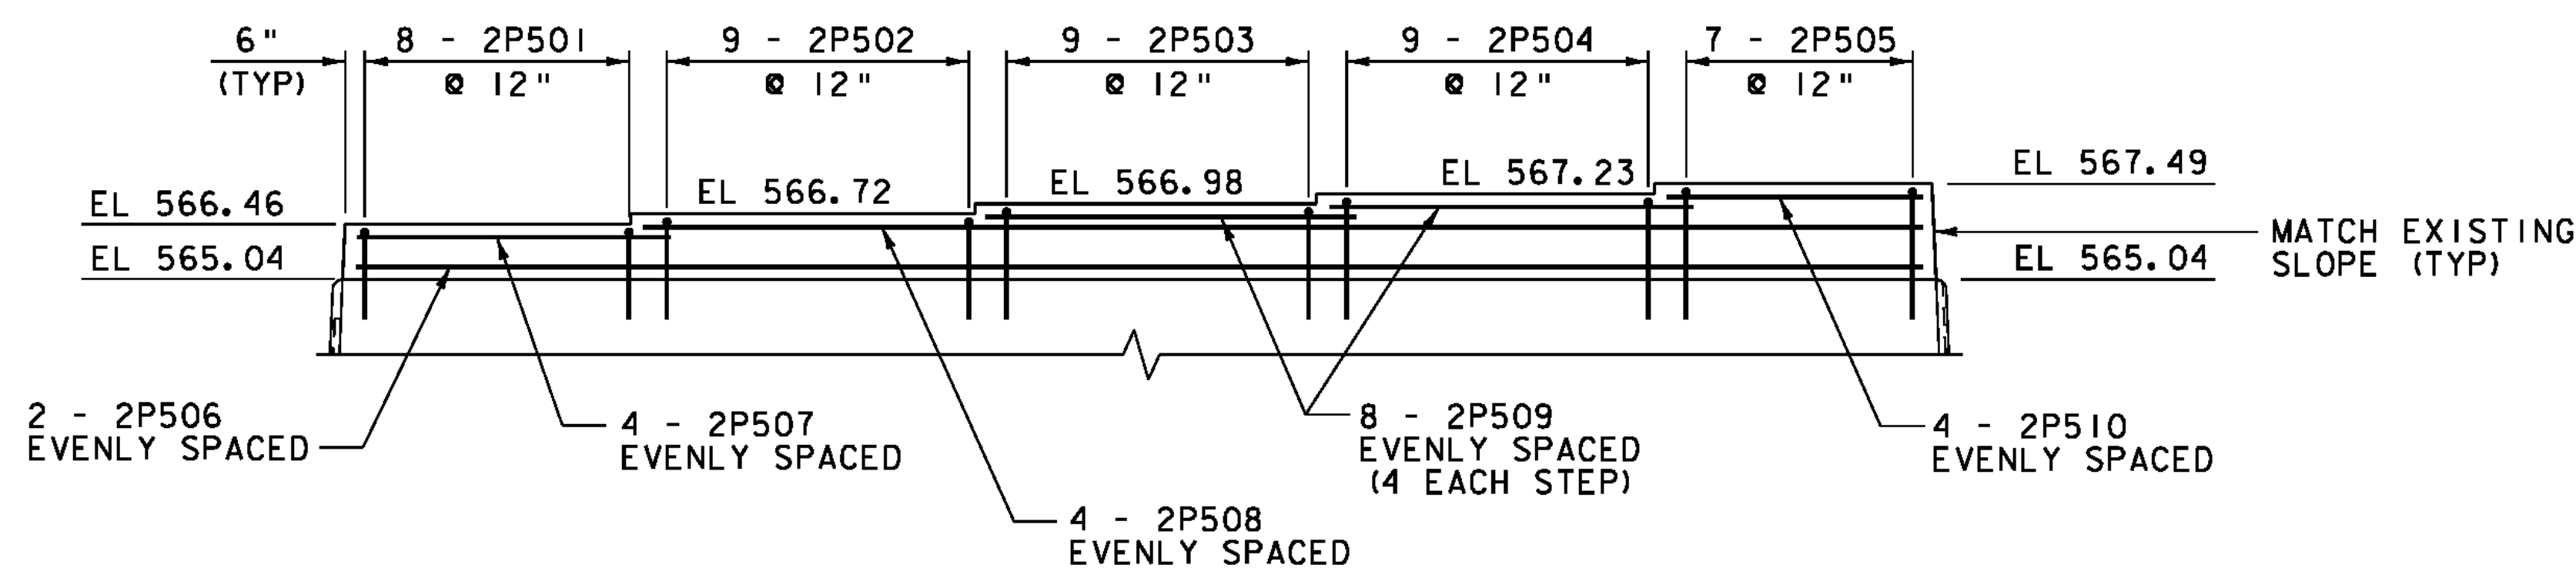

PIER NO. 2 ELEVATION
SCALE 1/4" = 1'-0"

NOTE:

- NF = NEAR FACE
- FF = FAR FACE
- EF = EACH FACE
- ▲ = CUT TO FIT IN FIELD
- 4" CLEAR, UNLESS OTHERWISE SPECIFIED ON THE PLANS.
- 2'-2" BAR LAP UNLESS OTHERWISE SPECIFIED ON THE PLANS.

PROJECT NAME: THETFORD
PROJECT NUMBER: BHF 0177(9)

FILE NAME: z08j174sub_pier_2.dgn
PROJECT LEADER: M.A. COLGAN
DESIGNED BY: G.S. GOODRICH
PIER NO. 2 DETAILS

PLOT DATE: 2/15/2012
DRAWN BY: E.A. FIALA
CHECKED BY: S.E. BURBANK
SHEET 57 OF 78

