



102+00

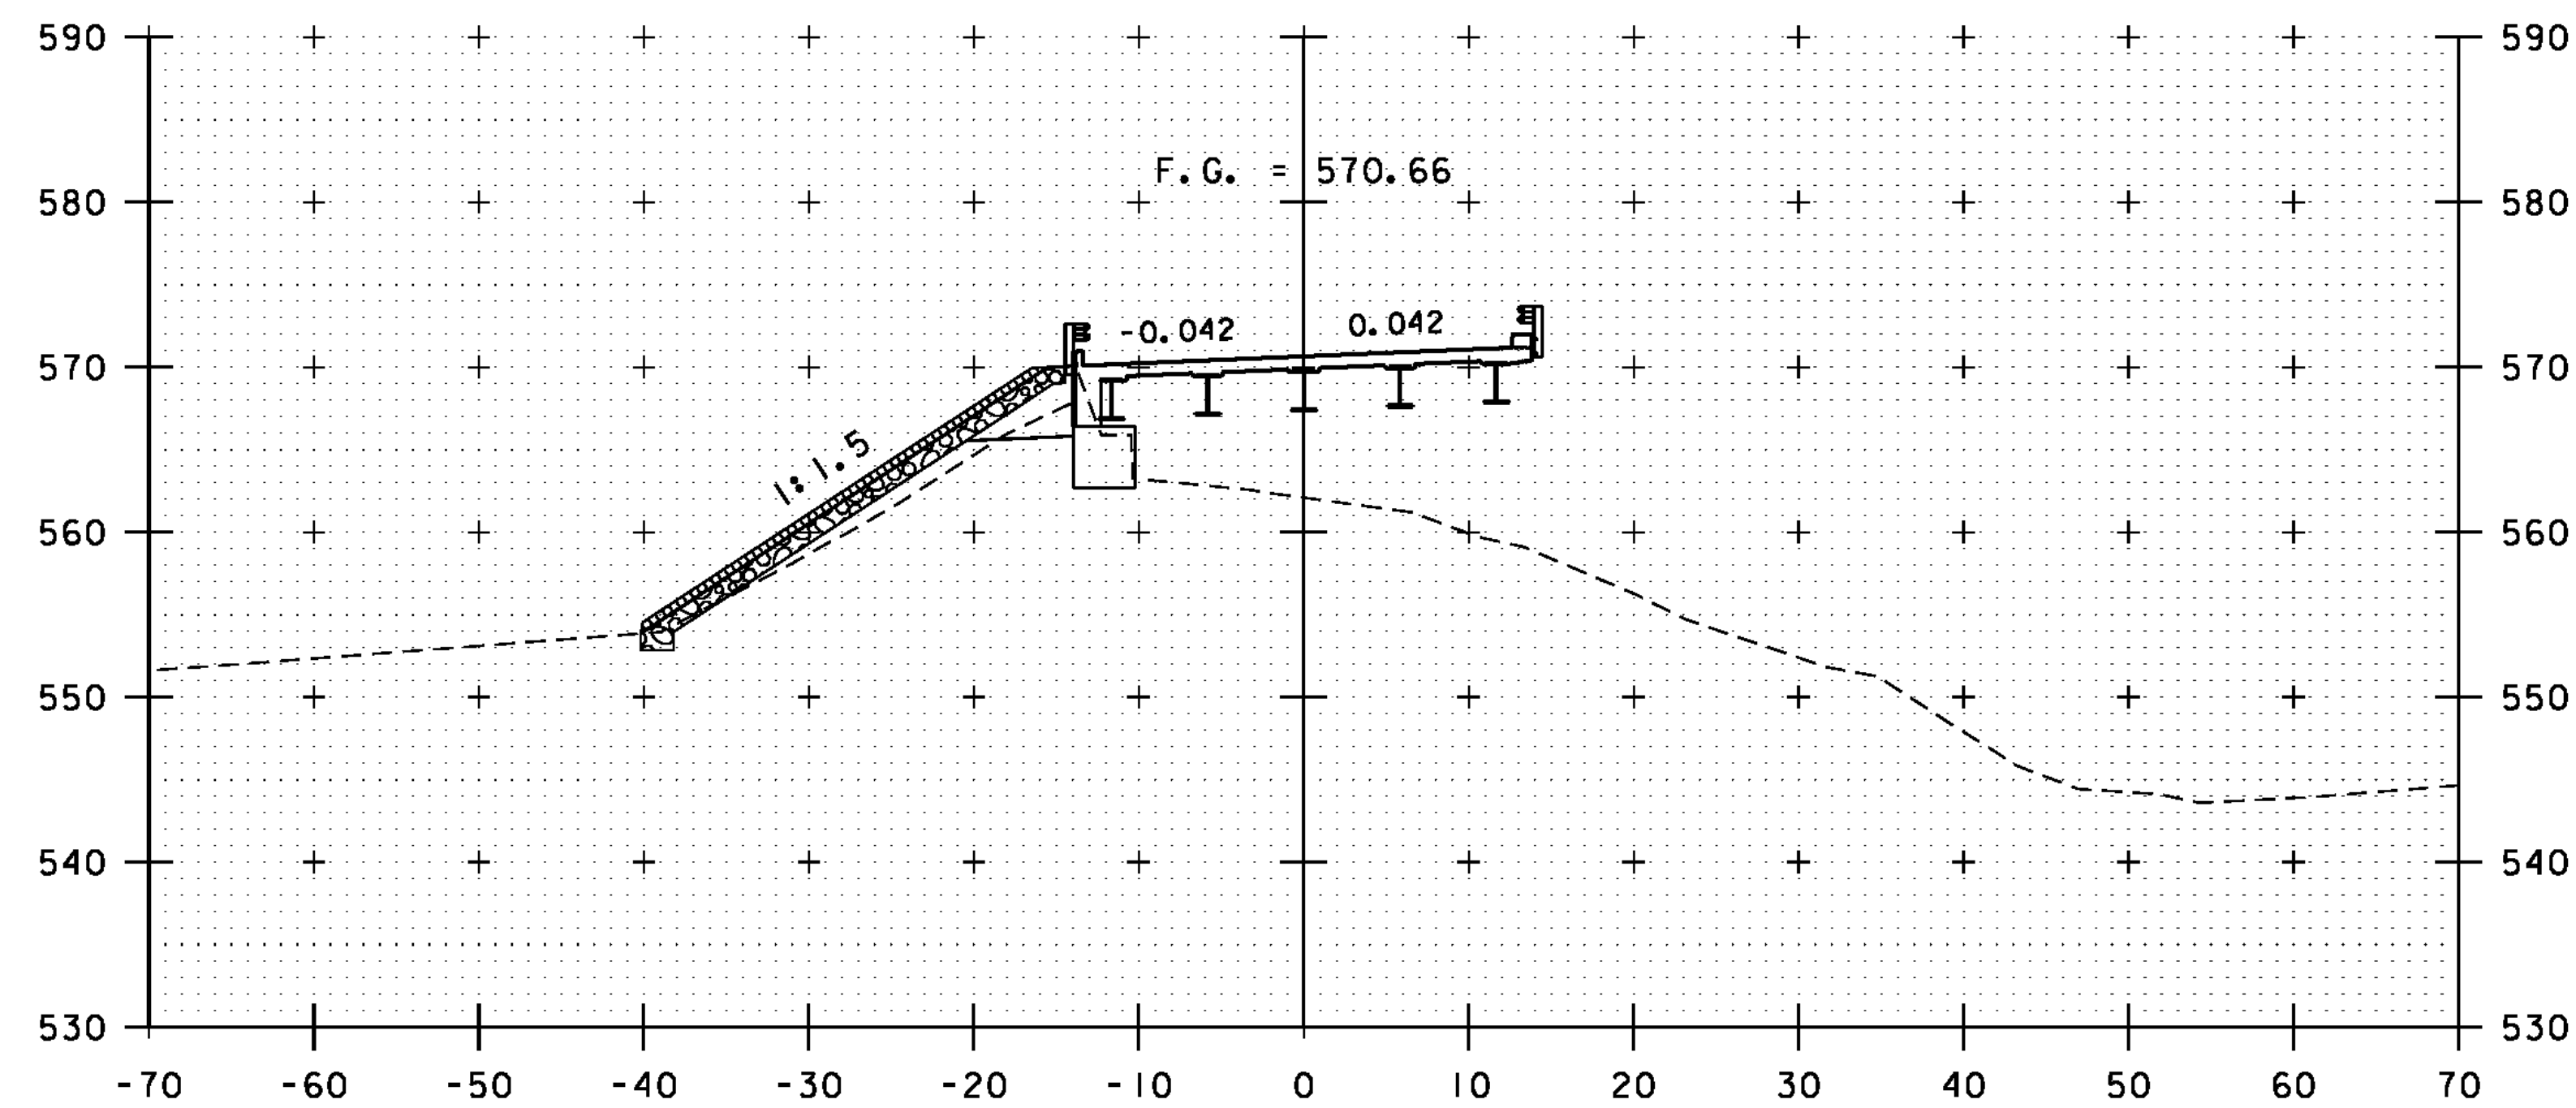


103+00

BEGIN BRIDGE
STA. 102+89.63

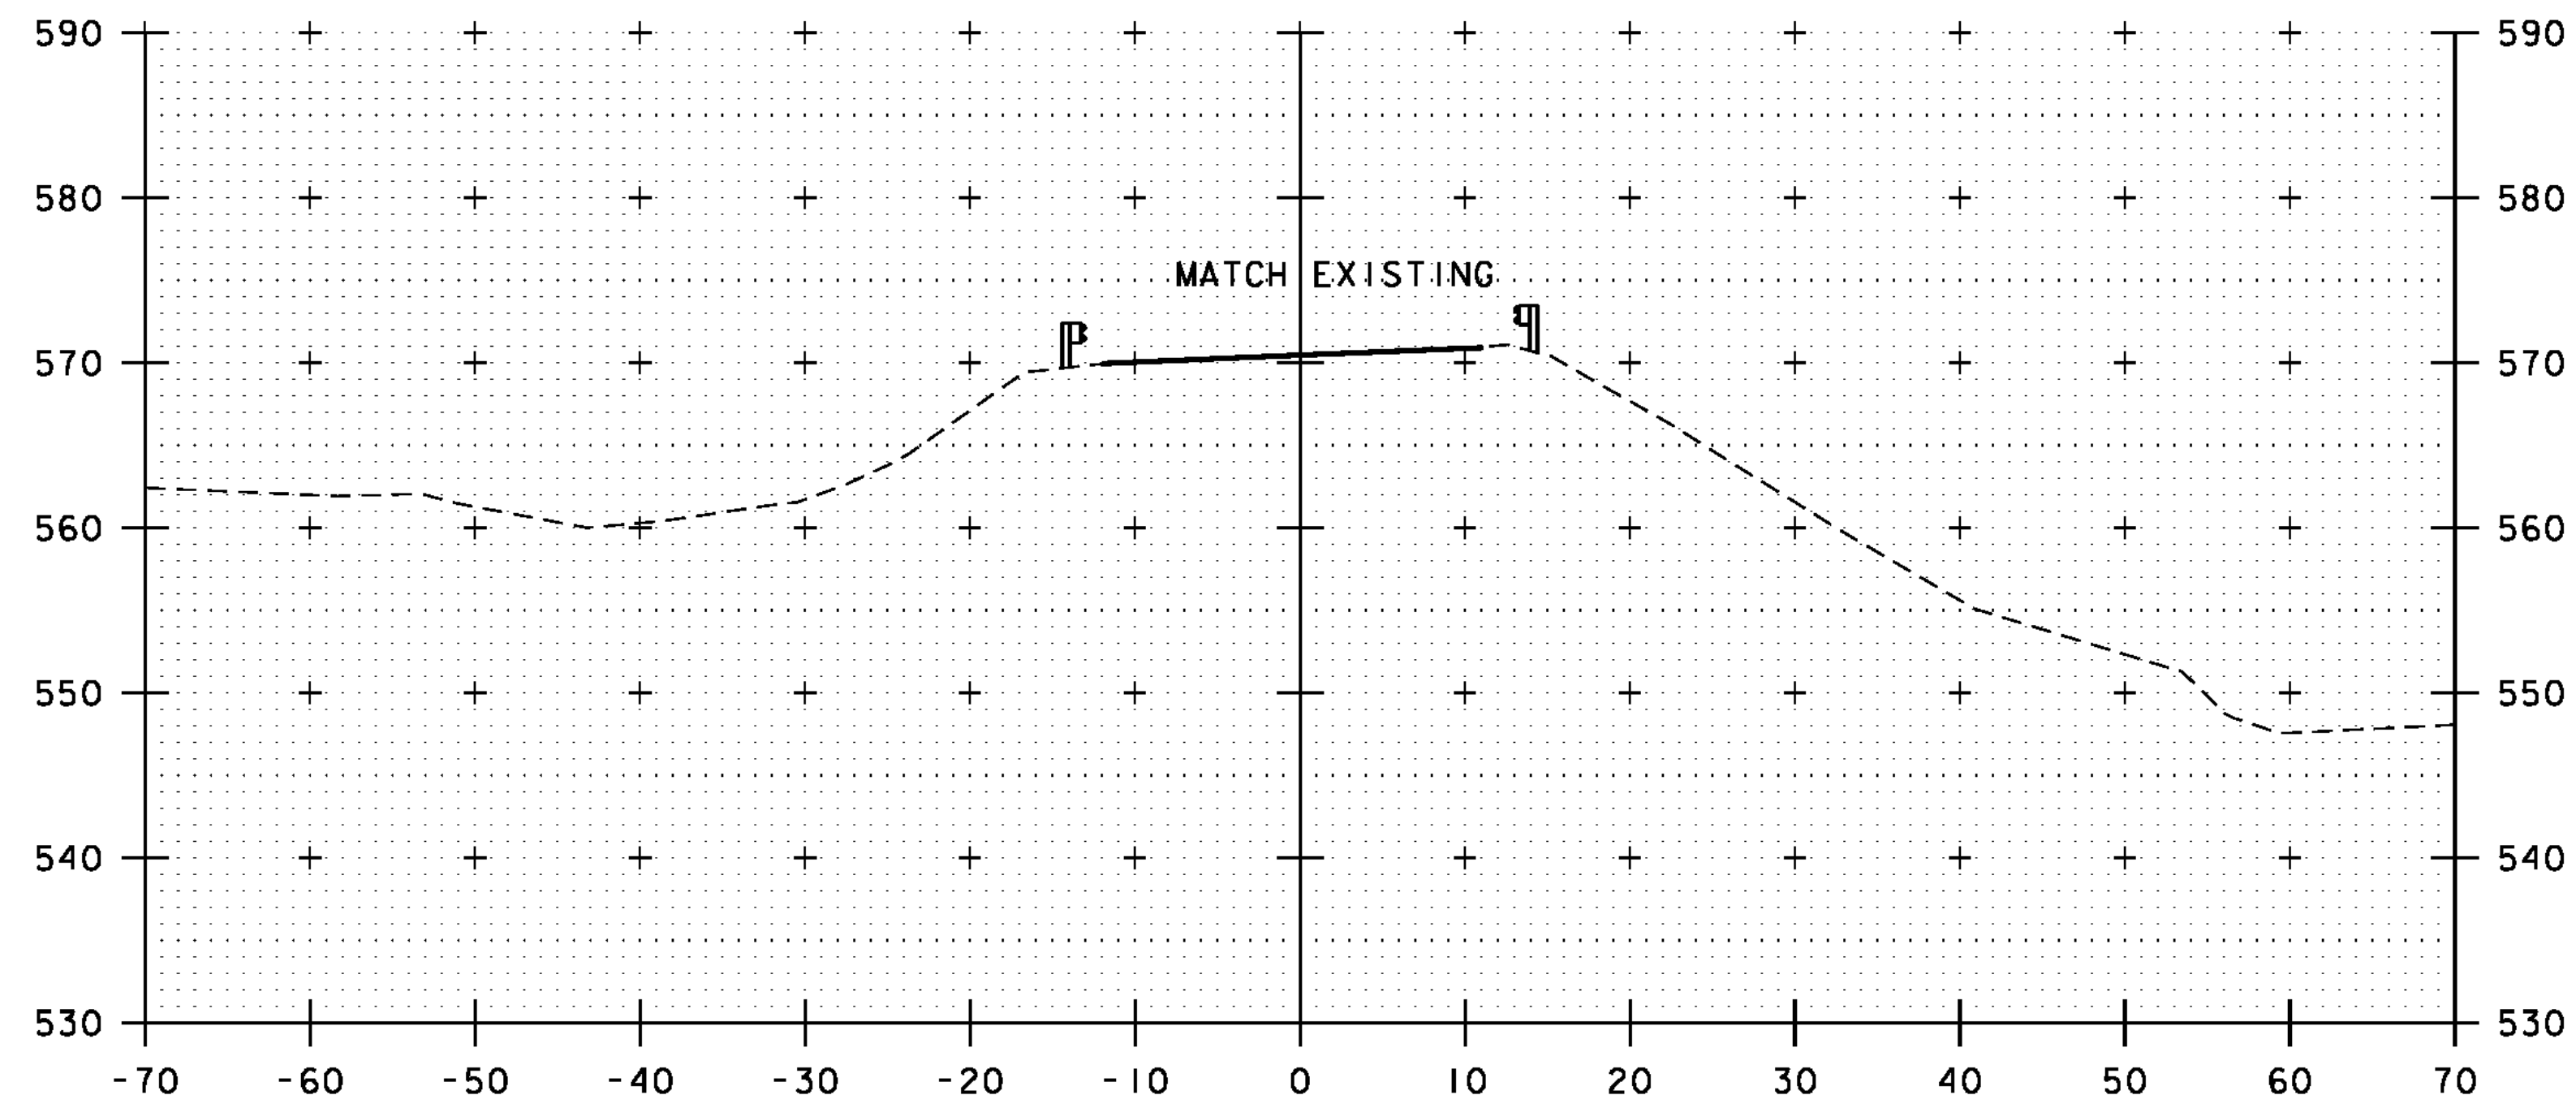

101+61

BEGIN APPROACH
STA. 101+61.00

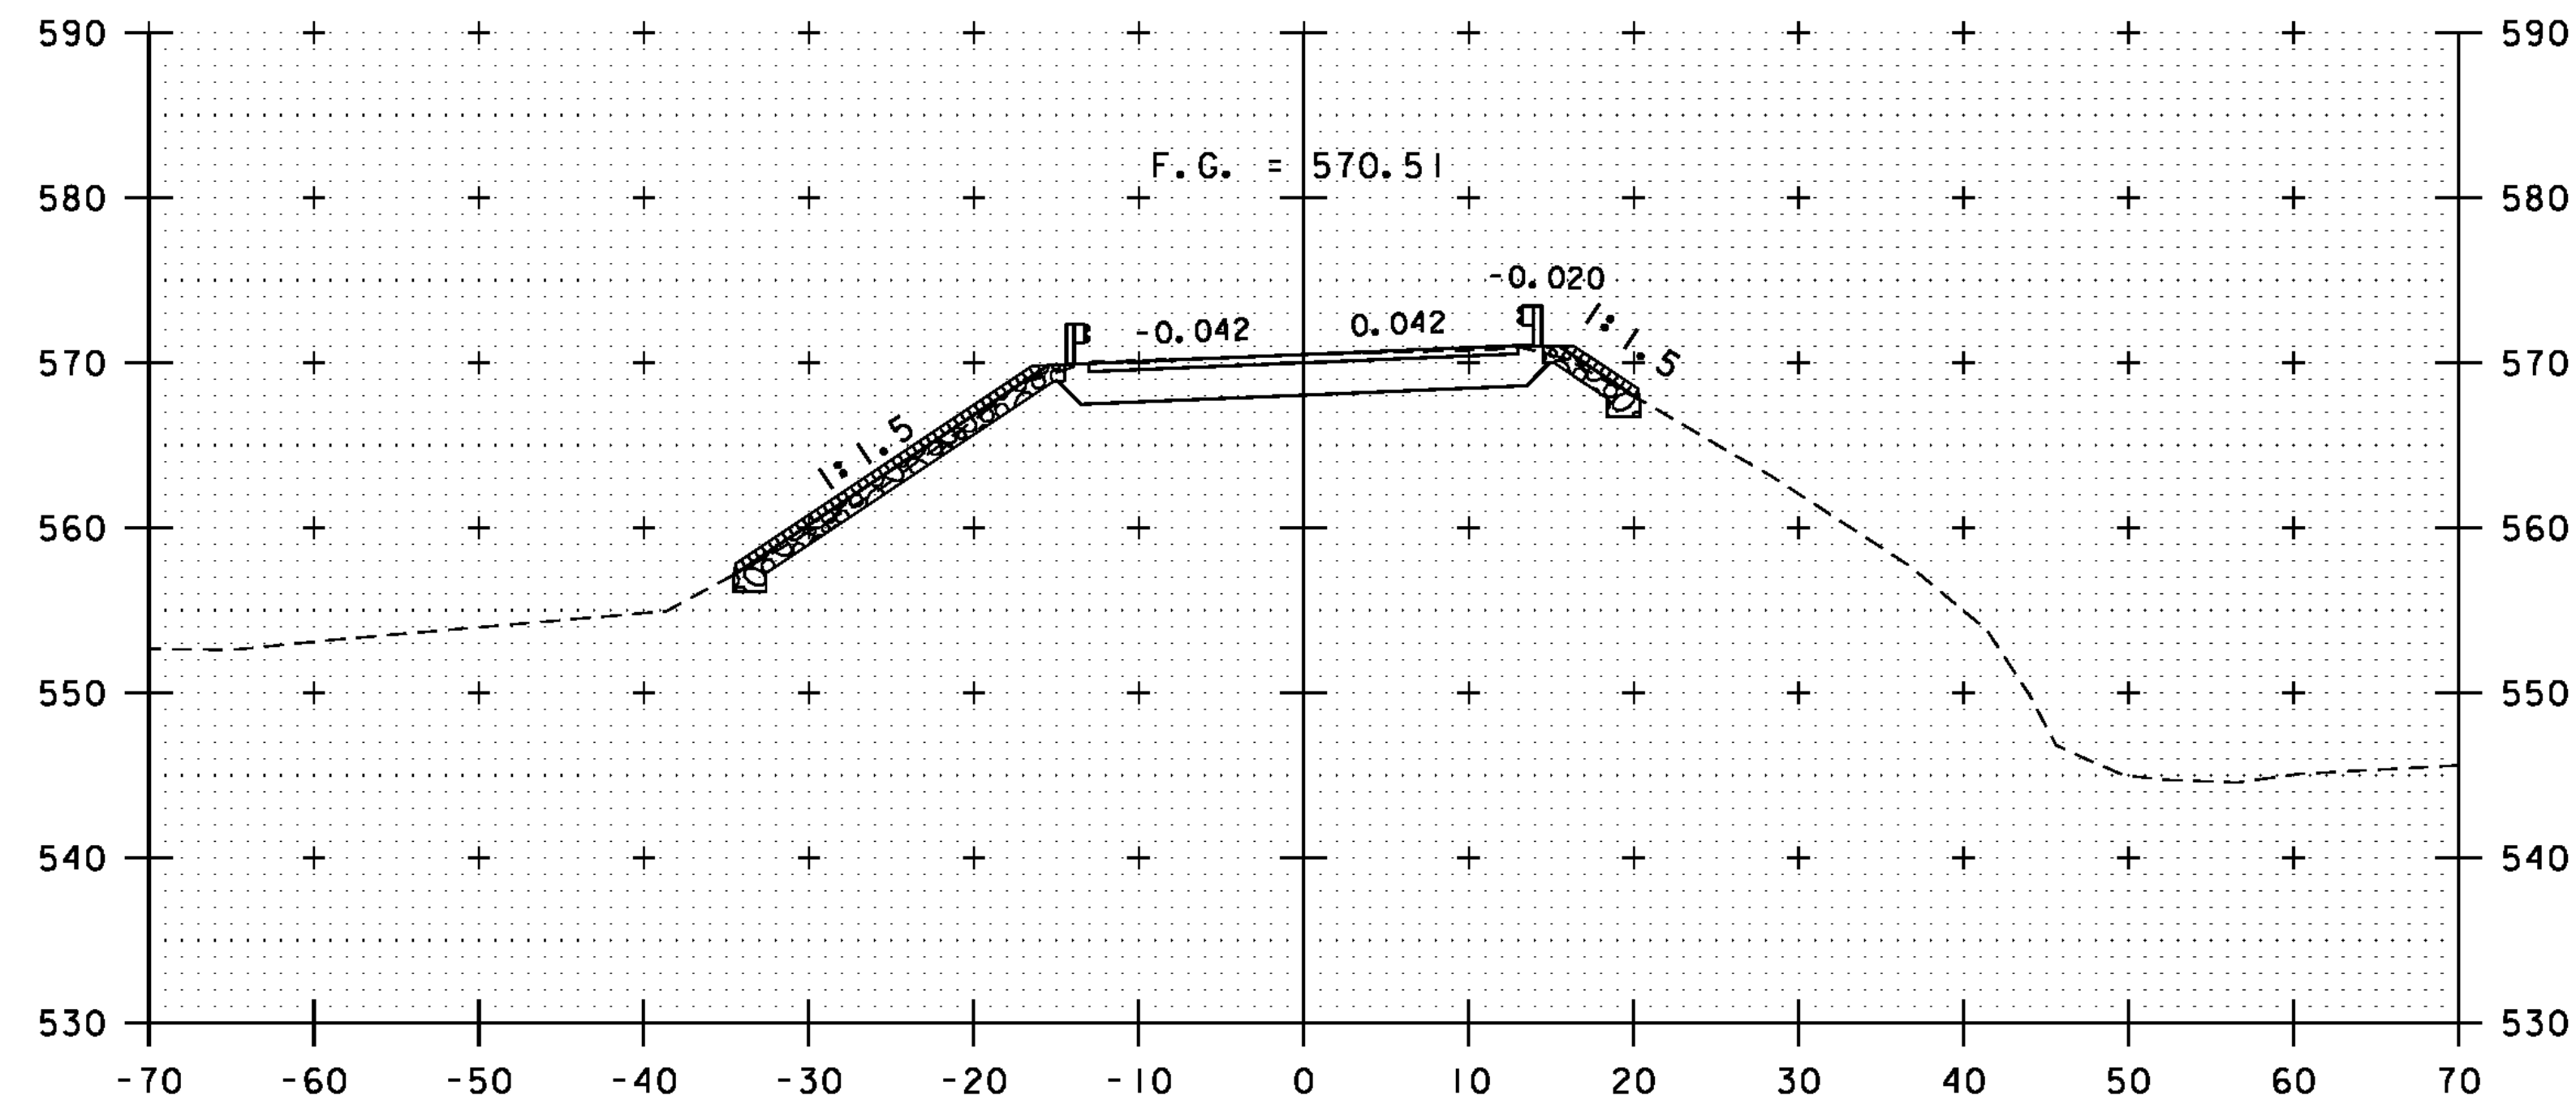

102+50

END APPROACH/BEGIN PROJECT
STA. 102+06.00

ROADWAY CROSS SECTIONS

SCALE 1" = 10'-0"

STA. 101+61 - STA. 103+00

PROJECT NAME: THETFORD

PROJECT NUMBER: BHF 0177(9)

FILE NAME: z08j174xsl.dgn

PLOT DATE: 2/15/2012

PROJECT LEADER: M.A. COLGAN

DRAWN BY: E.A. FIALA

DESIGNED BY: S.E. BURBANK

CHECKED BY: S.E. BURBANK

ROADWAY CROSS SECTIONS (1 OF 3)

SHEET 64 OF 78

