




104+00

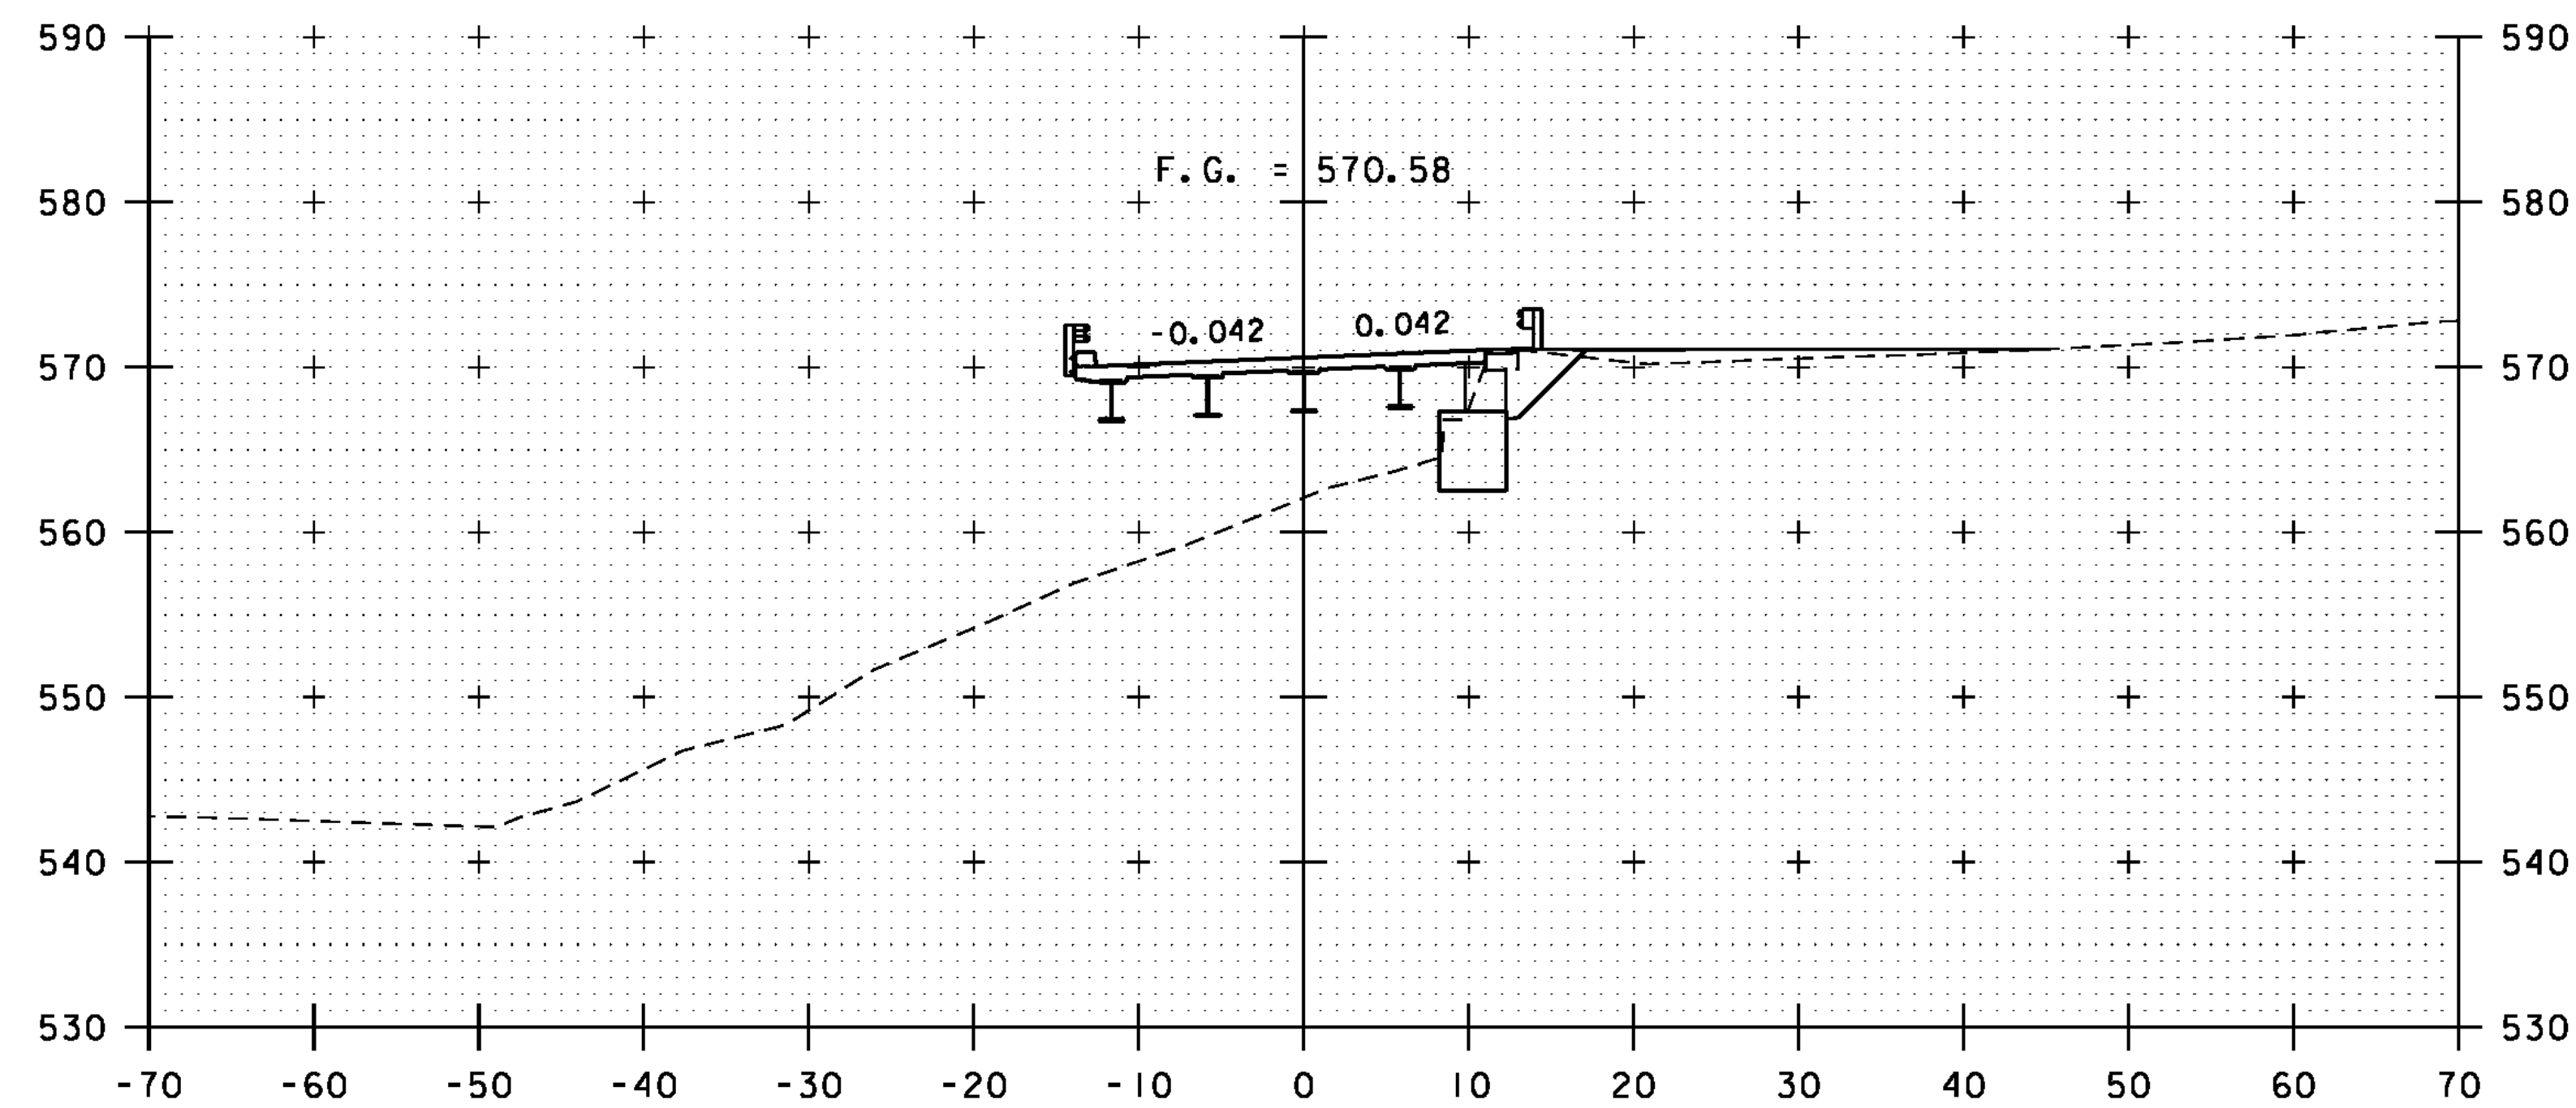

105+00

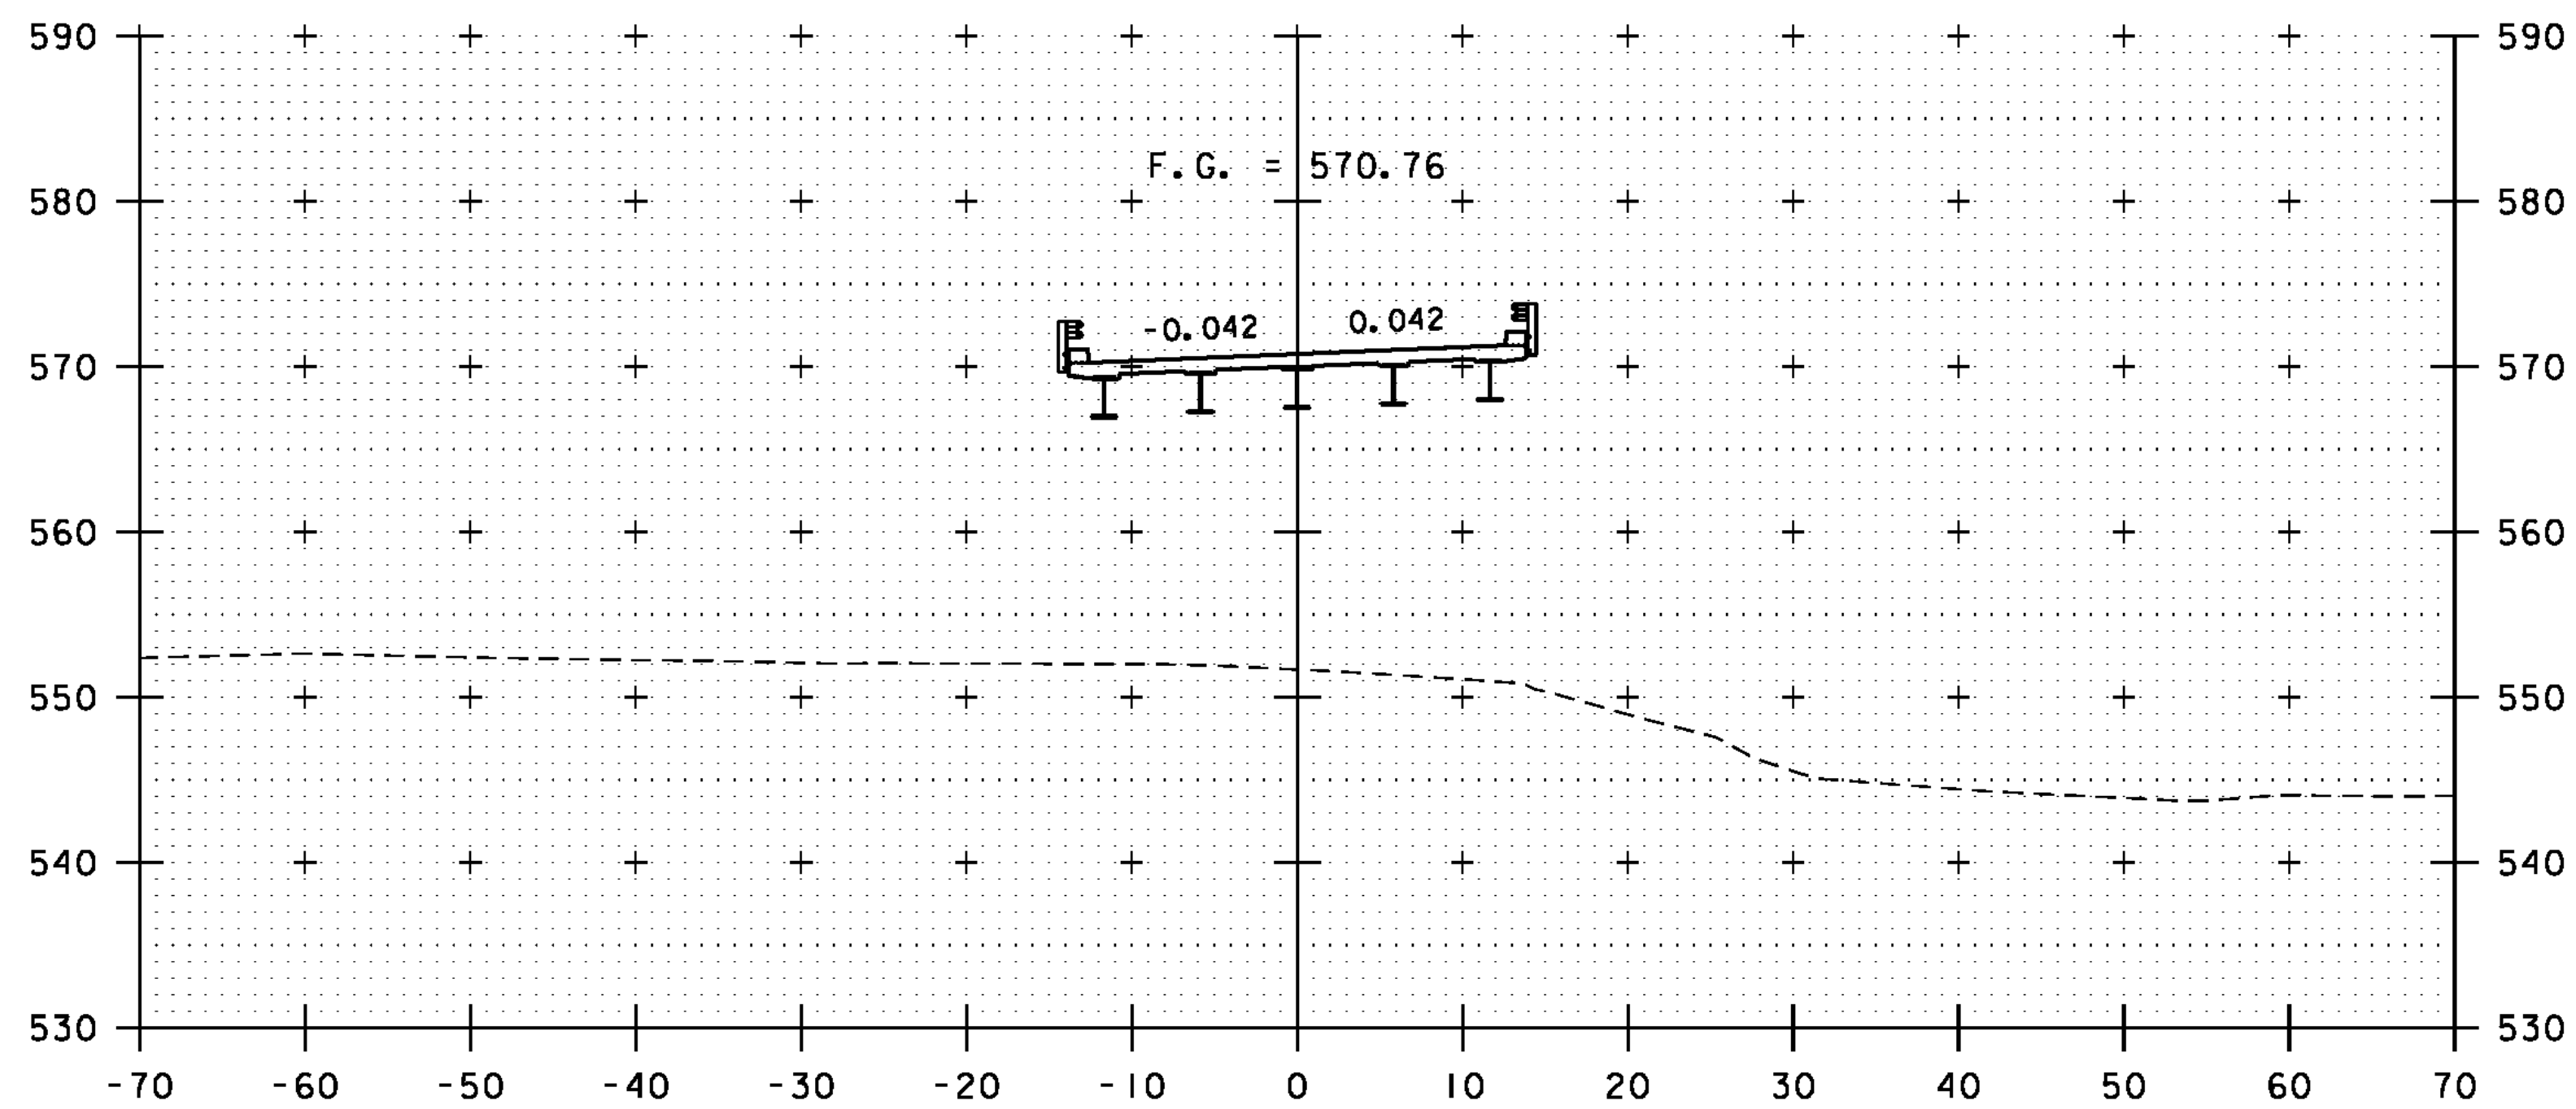

103+50

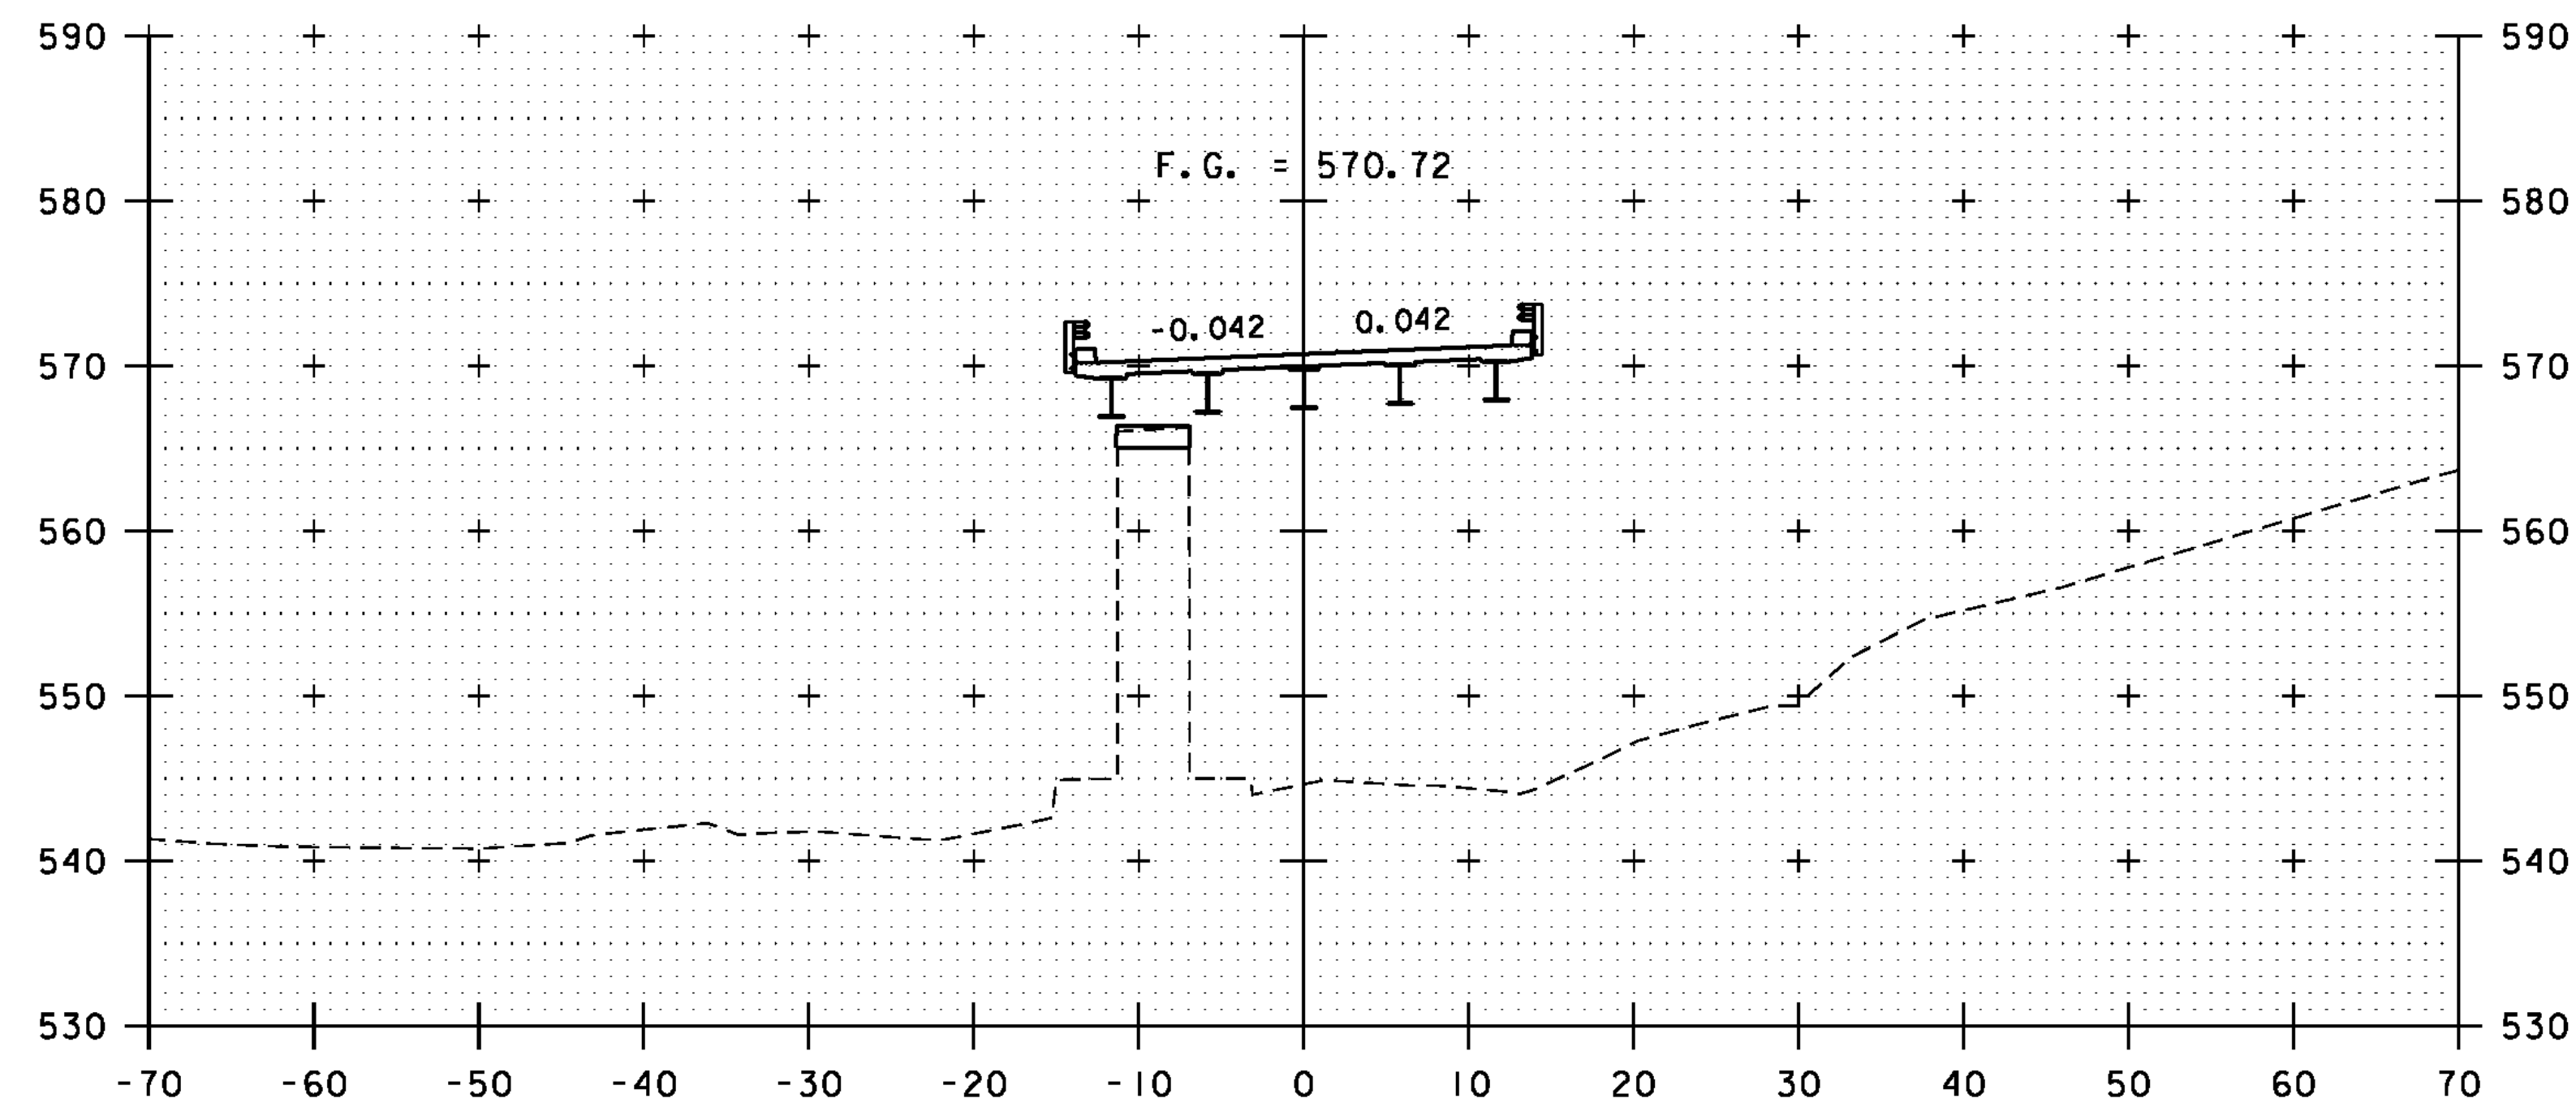

104+50

ROADWAY CROSS SECTIONS

SCALE 1" = 10'-0"

STA. 103+50 - STA. 105+00



PROJECT NAME: THETFORD	
PROJECT NUMBER: BHF 0177(9)	
FILE NAME: z08j174xsl.dgn	PLOT DATE: 2/15/2012
PROJECT LEADER: M.A. COLGAN	DRAWN BY: E.A. FIALA
DESIGNED BY: S.E. BURBANK	CHECKED BY: S.E. BURBANK
ROADWAY CROSS SECTIONS (2 OF 3)	SHEET 65 OF 78