


10+75  
 BEGIN UNCLASSIFIED CHANNEL EXCAVATION  
 STONE FILL, TYPE III  
 GEOTEXTILE UNDER STONE FILL  
 STA. 10+62.00, LT



10+50  
 CHANNEL CROSS SECTIONS  
 SCALE 1" = 10'-0"  
 STA. 10+50 - STA. 10+75

PROJECT NAME: THETFORD	
PROJECT NUMBER: BHF 0177(9)	
FILE NAME: z08j174xsl.dgn	PLOT DATE: 2/15/2012
PROJECT LEADER: M.A. COLGAN	DRAWN BY: B.M. KLINEFELTER
DESIGNED BY: S.E. BURBANK	CHECKED BY: S.E. BURBANK
CHANNEL CROSS SECTIONS (2 OF 5)	SHEET 68 OF 78

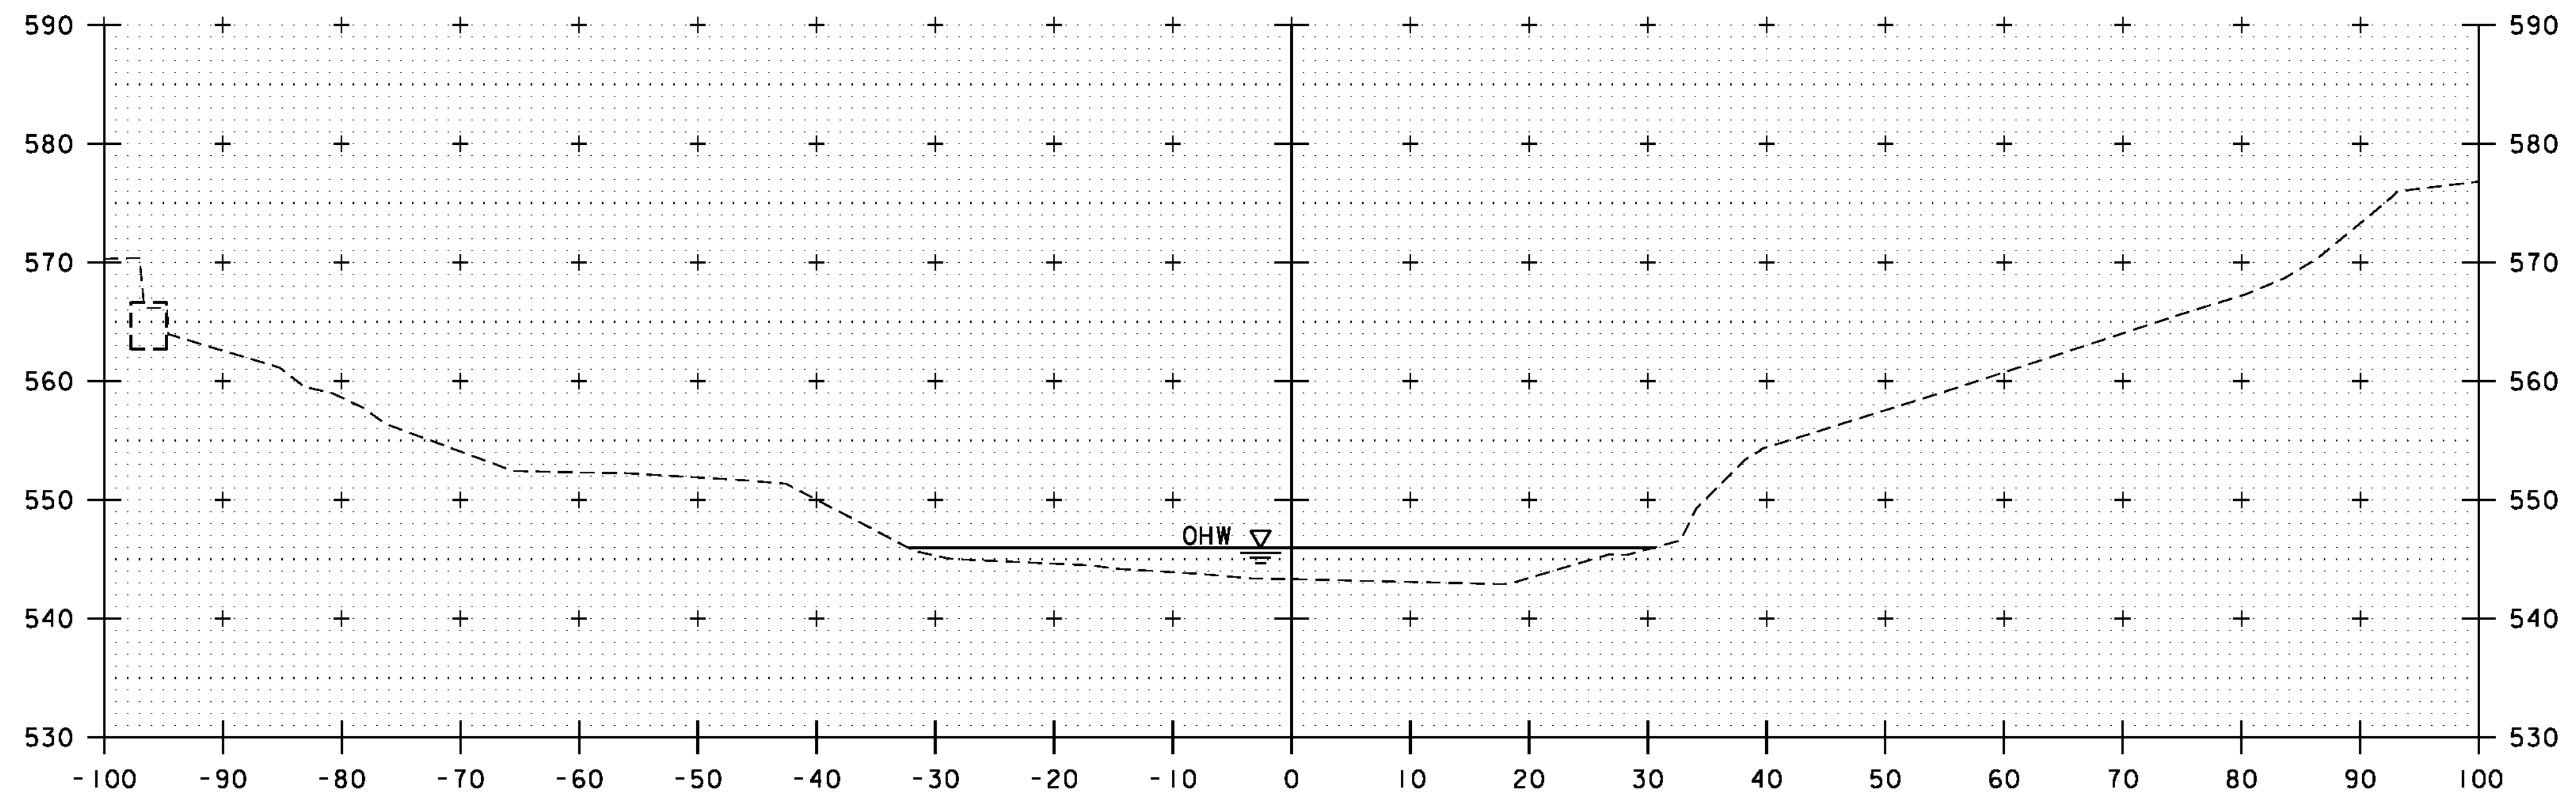