


11+25  
 END UNCLASSIFIED CHANNEL EXCAVATION  
 STONE FILL, TYPE III  
 GEOTEXTILE UNDER STONE FILL  
 STA. 11+06.73, LT



11+00  
 CHANNEL CROSS SECTIONS  
 SCALE 1" = 10'-0"  
 STA. 11+00 - STA. 11+25

PROJECT NAME:	THETFORD	FILE NAME:	z08j174xsl.dgn	PLOT DATE:	2/15/2012
PROJECT NUMBER:	BHF 0177(9)	PROJECT LEADER:	M.A. COLGAN	DRAWN BY:	B.M. KLINEFELTER
		DESIGNED BY:	S.E. BURBANK	CHECKED BY:	S.E. BURBANK
		CHANNEL CROSS SECTIONS	(3 OF 5)	SHEET	69 OF 78

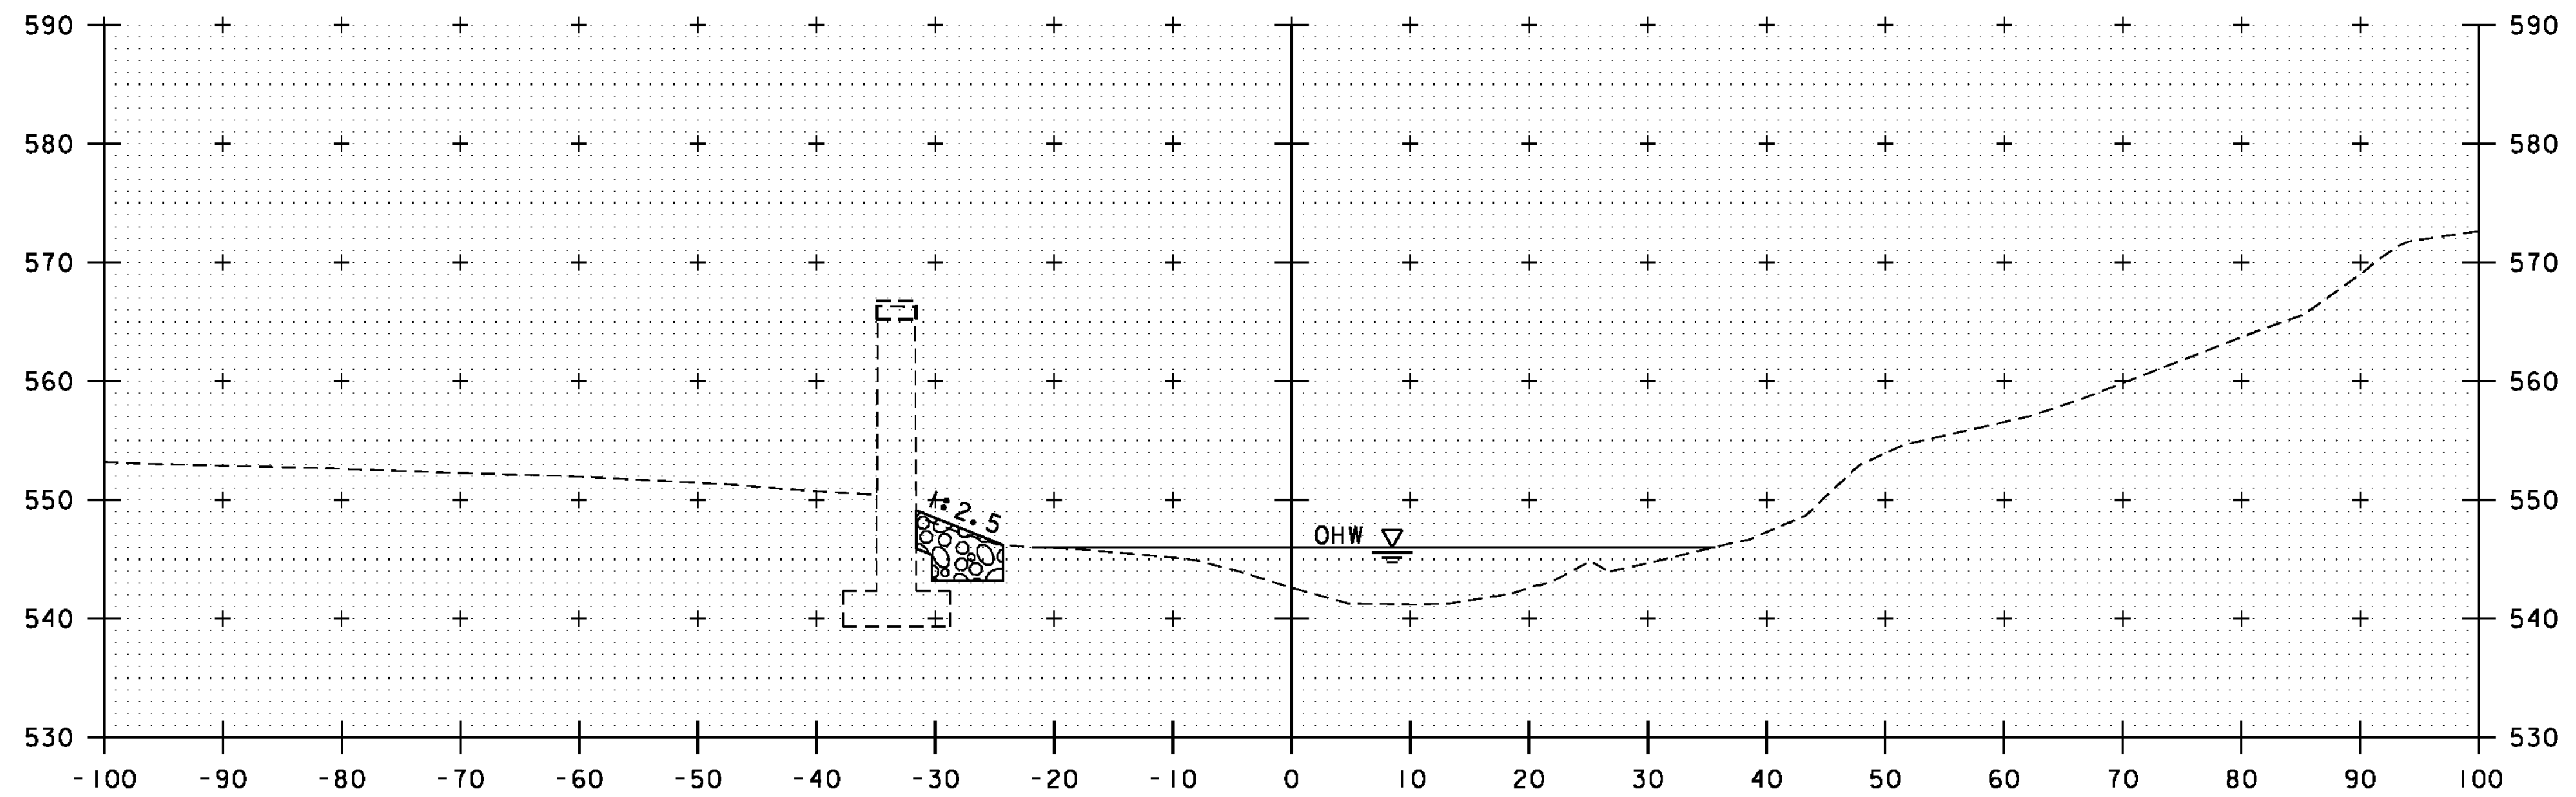