


12+25



12+00

CHANNEL CROSS SECTIONS
 SCALE 1" = 10'-0"
 STA. 12+00 - STA. 12+25

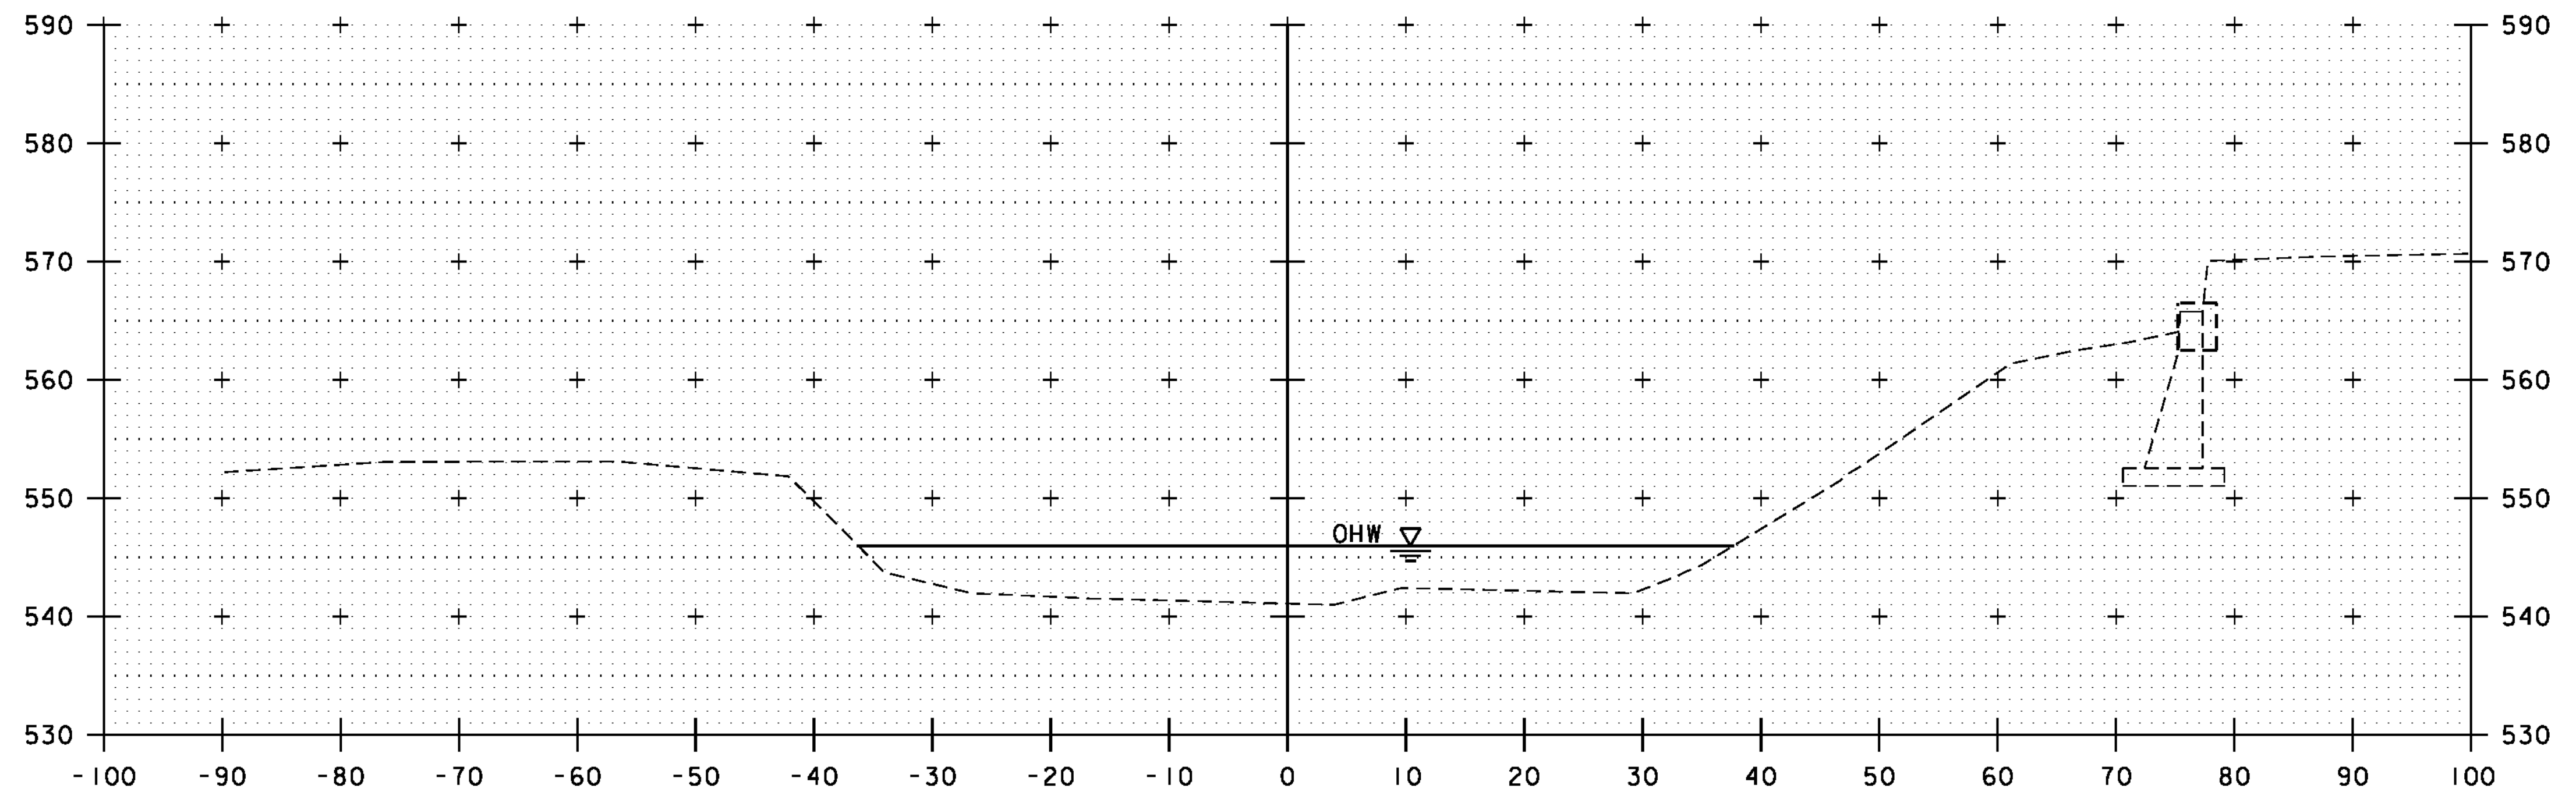

PROJECT NAME: THETFORD	
PROJECT NUMBER: BHF 0177(9)	
FILE NAME: z08j174xsl.dgn	PLOT DATE: 2/15/2012
PROJECT LEADER: M.A. COLGAN	DRAWN BY: B.M. KLINEFELTER
DESIGNED BY: S.E. BURBANK	CHECKED BY: S.E. BURBANK
CHANNEL CROSS SECTIONS (5 OF 5)	SHEET 71 OF 78