

# STATE OF VERMONT AGENCY OF TRANSPORTATION





## PROPOSED IMPROVEMENT TOWNS OF MANCHESTER - SPRINGFIELD COUNTIES OF BENNINGTON, WINDHAM, AND WINDSOR VERMONT ROUTE 11

BEGINNING IN MANCHESTER CENTER AT A POINT 1.260 MILES FROM THE INTERSECTION OF VT ROUTE 11 AND VT ROUTE 7A, WHERE THE CLASS I LIMITS ENDS AND STATE HIGHWAY BEGINS, ON ROUTE 11 AT MILE MARKER 1.260 AND EXTENDING EASTERLY ALONG VT ROUTE 11 FOR A DISTANCE OF 40.963 MILES TO THE INTERSECTION OF VT ROUTE 11 AND ROUTE 5 IN THE TOWN OF SPRINGFIELD AT MILE MARKER 8.203. EXCLUDING CLASS I SECTIONS WITHIN THE PROJECT CORRIDOR.

LENGTH OF ROADWAY = 40.963 MILES  
LENGTH OF PROJECT = 36.050 MILES

WORK TO BE PERFORMED UNDER THIS PROJECT INCLUDES THE REMOVAL OF EXISTING SIGNS AND POSTS AND THE INSTALLATION OF NEW SIGNS AND SIGN POSTS AND INCIDENTAL ITEMS.

INDEX OF SHEETS  
SEE SHEET 2

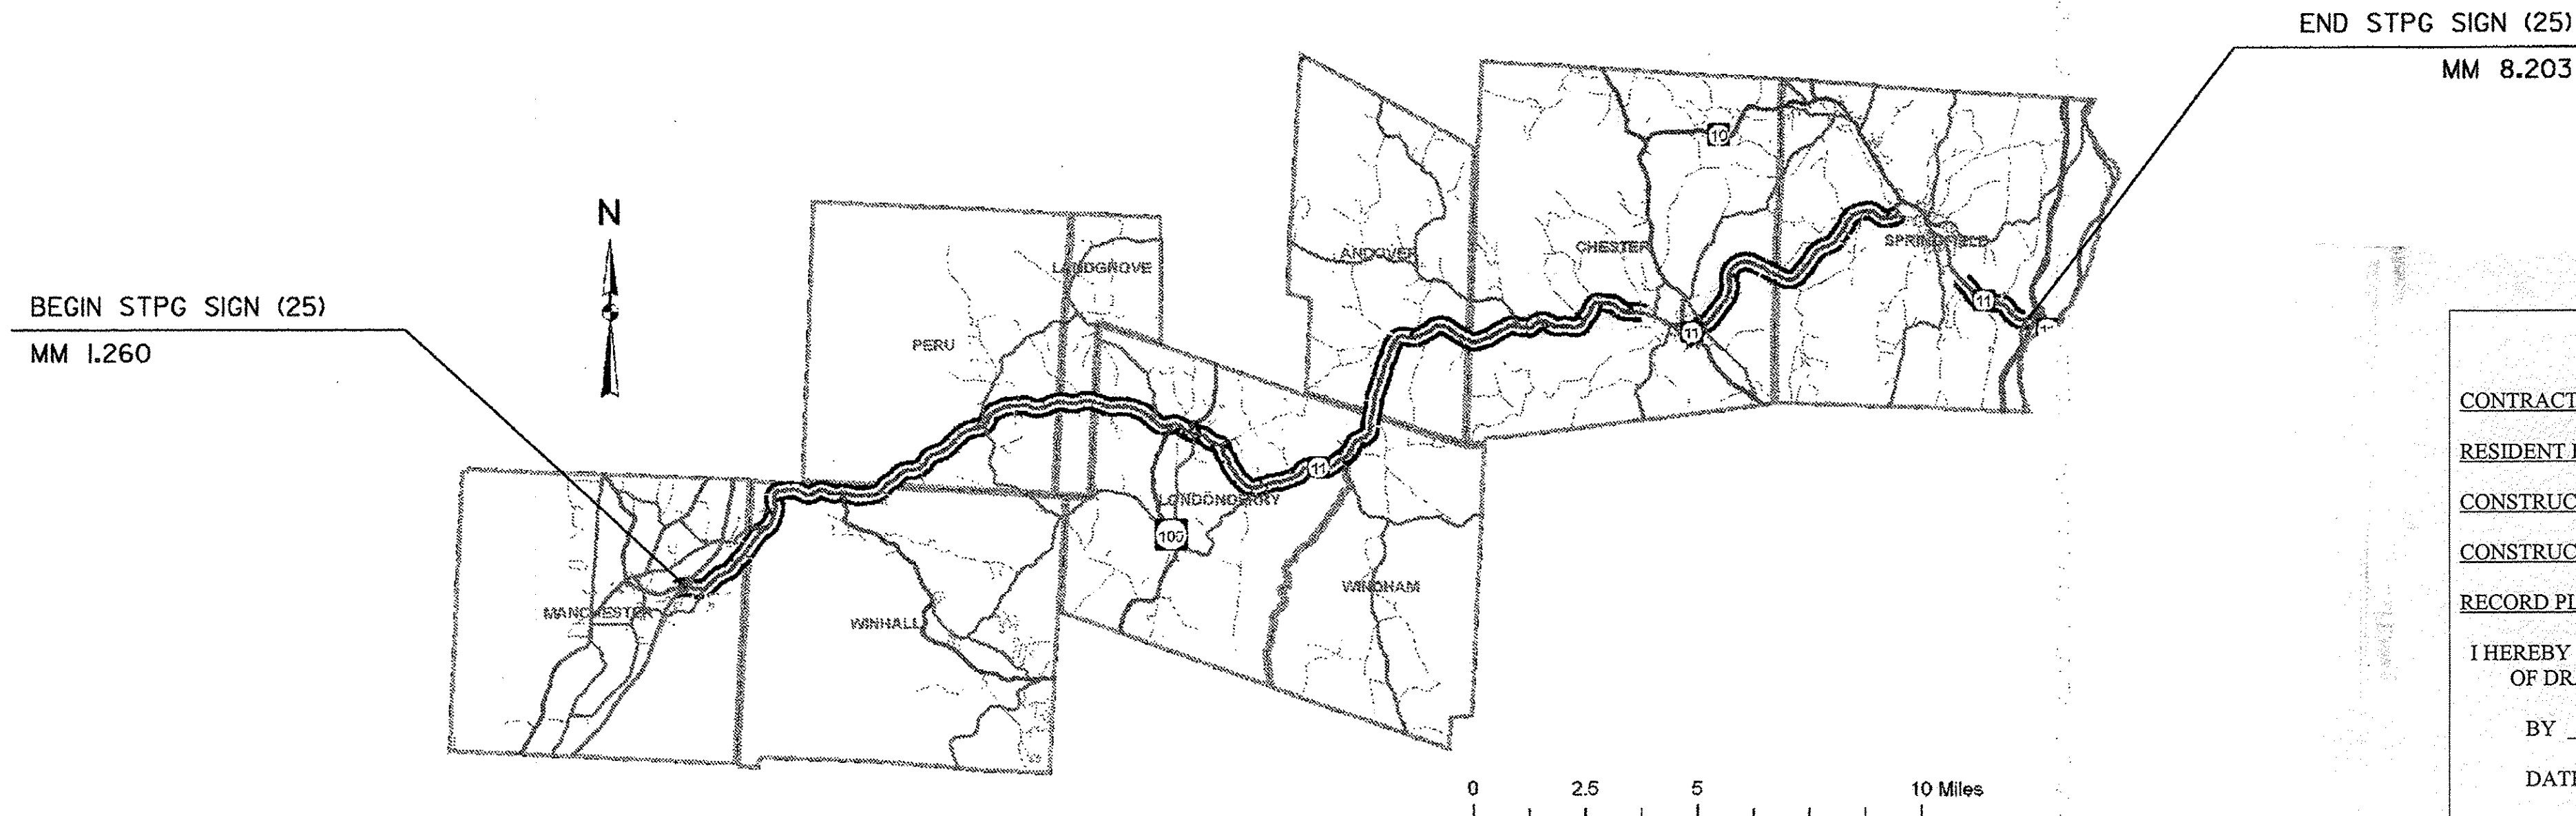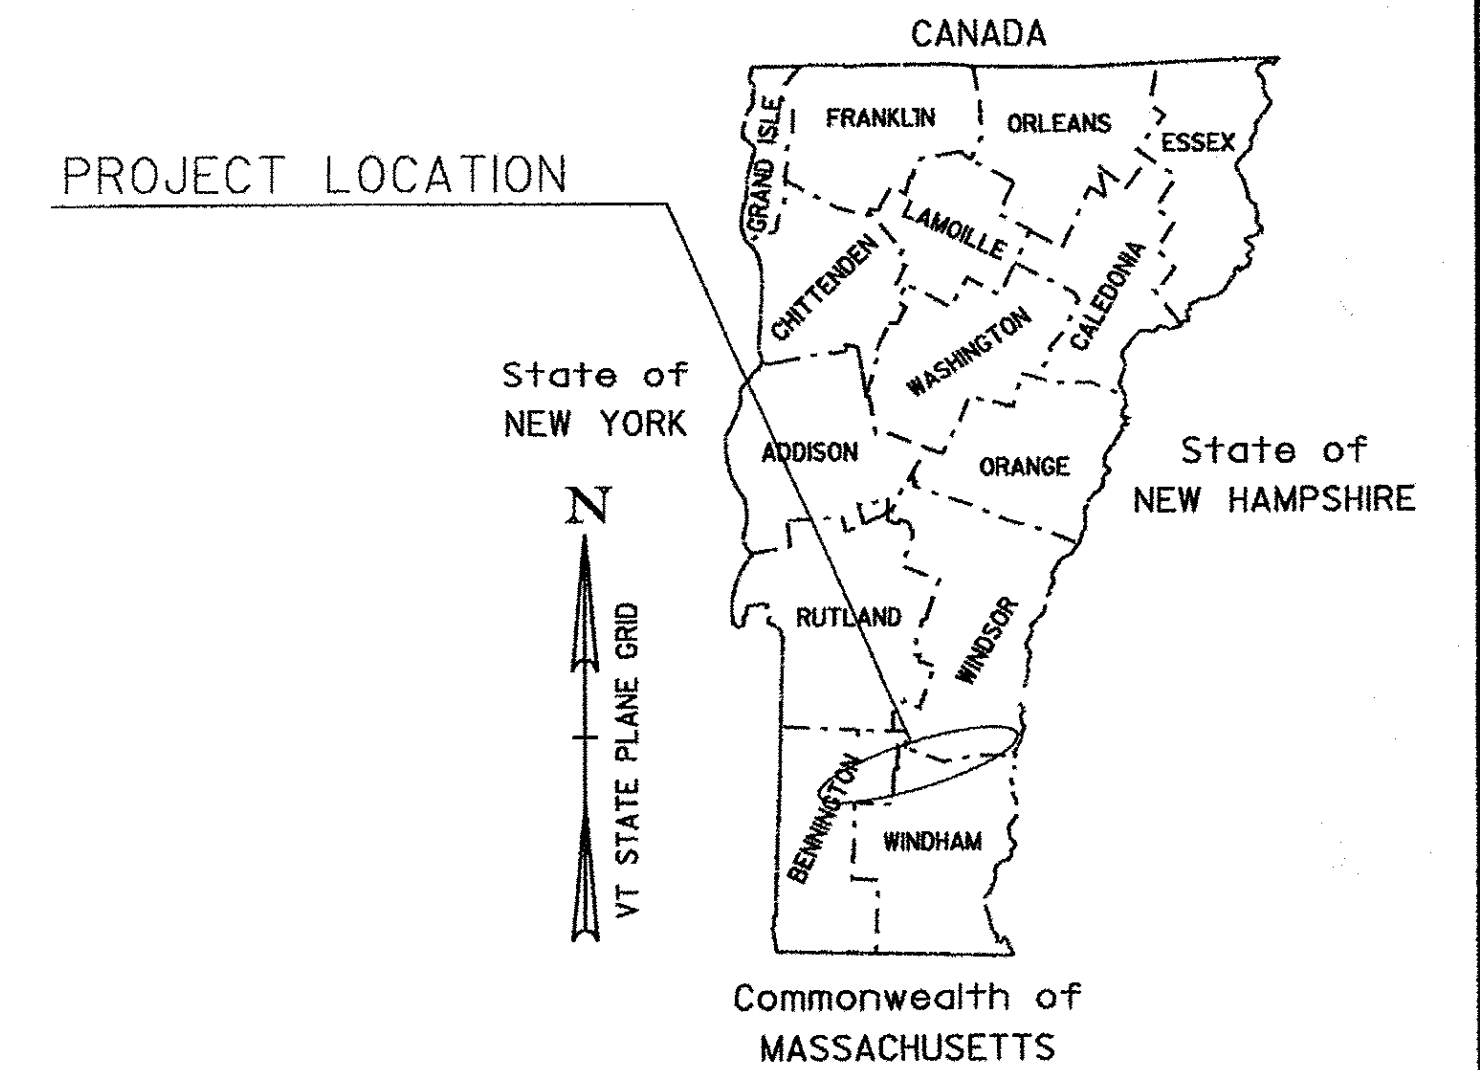

### CONVENTIONAL SYMBOLS

COUNTY LINE	
TOWN LINE	
LIMITS OF ACCESS	
POINT OF ACCESS	
FENCE LINE	
STONE WALL	
TRAVELED WAY	
GUARD RAIL	
RAILROAD	
SURVEY LINE	
CULVERT	
POWER POLE	
TELEPHONE POLE	
TREES	
CONTROL OF ACCESS	
PROPERTY LINE	
R.O.W. TAKING LINE	
SLOPE RIGHTS	
TOP OF CUT	
TOE OF SLOPE	

SURVEYED BY : N/A  
SURVEYED DATE : N/A

DATUM  
VERTICAL N/A  
HORIZONTAL N/A

### RECORD PLANS

CONTRACTOR: F. R. LAFAYETTE, INC. - ESSEX JUNCTION, VT  
RESIDENT ENGINEER: PAUL PERRY  
CONSTRUCTION BEGAN: JULY 7, 2009  
CONSTRUCTION COMPLETE: MAY 27, 2010  
RECORD PLANS BY: PAUL PERRY & AMOS KEMPTON

I HEREBY CERTIFY THAT ALL THE CONSTRUCTION REQUIRED BY THIS SET OF DRAWINGS HAS BEEN ACCOMPLISHED AS INDICATED HEREIN.

BY Paul K. Perry RESIDENT ENGINEER  
DATE 9-22-11

NOTE: Any further information concerning final quantities, amounts or other details relative to this project may be found at Central Files in the electronic archives.

THESE PLANS ARE SUBJECT TO SUCH ENGINEERING CHANGES AS MAY BE REQUIRED BY THE FEDERAL HIGHWAY ADMINISTRATION OR THE DIRECTOR OF PROGRAM DEVELOPMENT.  
CONSTRUCTION IS TO BE CARRIED ON IN ACCORDANCE WITH THESE PLANS AND THE STANDARD SPECIFICATIONS FOR CONSTRUCTION DATED 2006, AS APPROVED BY THE FEDERAL HIGHWAY ADMINISTRATION ON JUNE 15, 2006 FOR USE ON THIS PROJECT, INCLUDING ALL SUBSEQUENT REVISIONS AND SUCH REVISED SPECIFICATIONS AND SPECIAL PROVISIONS AS ARE INCORPORATED IN THESE PLANS.

DIRECTOR OF PROGRAM DEVELOPMENT	
APPROVED: <u>Paul K. Perry</u>	DATE <u>3-23-09</u>
PROJECT MANAGER :	AMY GAMBLE
PROJECT NAME :	MANCHESTER - SPRINGFIELD
PROJECT NUMBER :	STPG SIGN (25)
SHEET 1 OF 115 SHEETS	