

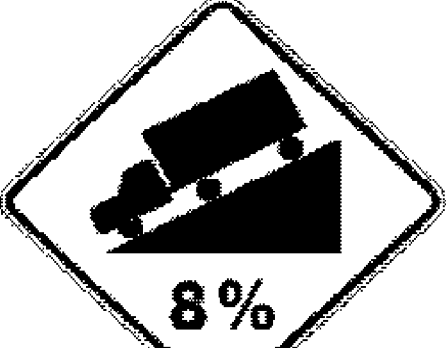
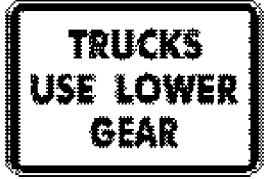

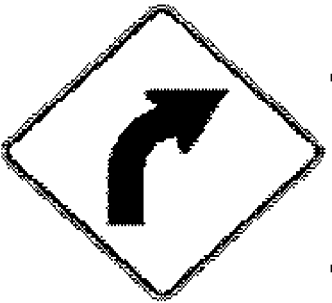


DIR	MILEPOINT	LOCATION CODE (SHEET 2)	MUTCD CODE	WIDTH (IN)	HEIGHT (IN)	SHEETING REMARKS	SIGN LEGEND	NEW SIGNS		EXISTING SIGNS			EXIST POST		NUMBER OF NEW POSTS	SQUARE STEEL (in)			TUBULAR STEEL Ø (IN)				SIGN FRAME REQUIRED	REMARKS	SIGN DETAIL				
								"A"	"B"	RETAIN	SALVAGE FROM	SALVAGE TO	REMOVE	RETAIN		REMOVE	2.00	2.00	2.50	FOUNDATION	3.00	3.50			4.00	5.00	DETAIL IN SHS	DETAIL ON SHEET NUMBER	DETAIL ON STD SHEET NUMBER
																	(LB / FT)				(LB / FT)								
WINHALL VT11							"FY"-FLUORESCENT YELLOW "FYG"-FLUORESCENT YELLOW GREEN															"SHS"-STANDARD HIGHWAY SIGNS							
		G	VR-017	24	30			5.00							1		X							TH-42, DEEPWOODS RD			E-141		
WB	1.238	H	R1-1	30	30						1	1	1			X								MISSING?					
		H	R1-1	30	30			6.25							1		X							TH-42, DEEPWOODS RD	X				
WB	1.160	F	VW-054R	30	30		HIDDEN DRIVE RIGHT						1			X													
WB	1.080	F	W7-1	36	36								1			X													
		F	W7-2B	30	24								1																
		F	W7-1B	36	36		 	9.00							2		X								X				
		F	W7-2B	30	24			5.00																X					
WB	0.990	F	W1-2R	30	30								0 1			X													
		F	W13-1	18	18								0 1																
		F	VW-092	36	36			9.00							2		X									E-150			
WB	0.980	F	VW-092	30	30		UNSAFE TO PASS						1			X													
																													
WB	0.920	F	W1-2R	30	30			6.25							1		X							INSTALL 50 FT +/- EAST OF GRAVEL DRIVE	X				
WB	0.754	F	W2-2MR	36	36		SIDE RD WARNING				1					X													
		F	W16-8A	36	18		TOLLGATE RD				1																		
SIGN SUMMARY SHEET							SHEET TOTALS	40.50	0.00	2	0	0	5	0	0	7		105							PROJECT NAME: Manchester-Springfield VT11				
							SF	SF	EA	EA	EA	EA	EA	EA	EA	EA	EA	FT							PROJECT NUMBER: STPG SIGN(25)				
VERMONT AGENCY OF TRANSPORTATION							TOWN TOTALS	524.2	0.0	15.0	0.0	0.0	118	2.0	2.0	76		1140.0							FILENAME: Winhall VT11.xls PLOT DATE: 4/6/2009				
																									PROJECT MANAGER: N. Avery DRAWN BY: T. Guazzoni				
																									DESIGNED BY: A. Gamble CHECKED BY: S. Menard				
																									WINHALL SHEET 16 SHEET 27 OF 115				