

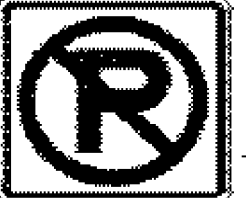





DIR	MILEPOINT	LOCATION CODE (SHEET 2)	MUTCD CODE	WIDTH (IN)	HEIGHT (IN)	SHEETING REMARKS	SIGN LEGEND	NEW SIGNS		EXISTING SIGNS				EXIST POST		NUMBER OF NEW POSTS	SQUARE STEEL (in)			TUBULAR STEEL Ø (IN)				SIGN FRAME REQUIRED	REMARKS	SIGN DETAIL			
								"A"	"B"	RETAIN	SALVAGE FROM	SALVAGE TO	REMOVE	RETAIN	REMOVE		2.00	2.00	2.50	FOUNDATION	3.00	3.50	4.00			5.00	DETAIL IN SHS	DETAIL ON SHEET NUMBER	DETAIL ON STD SHEET NUMBER
																	(LB / FT)				(LB / FT)								
PERU VT 11							"FY"-FLUORESCENT YELLOW "FYG"-FLUORESCENT YELLOW GREEN																"SHS"-STANDARD HIGHWAY SIGNS						
		C	VR-017	24	30			5.00							1	X								TH-24, OLD MANCHESTER RD			E-141		
EB	0.866	D	R1-1	30	30																				MISSING?				
		D	R1-1	30	30				6.25						1	X								TH-24, OLD MANCHESTER RD	X				
EB	0.900	A	R8-3A	24	24		 	4.00							1	X								INSTALL 150 FT +/- EAST OF OLD MANCHESTER RD	X				
		A	M4-6	24	12				2.00																X				
EB	2.070	C	VR-017	24	30																								
		C	VR-017	24	30				5.00						1	X								TH-21, BROMLEY FARM RD			E-141		
EB	2.085	D	R1-1	30	30																								
		D	R1-1	30	30				6.25						1	X								TH-21, BROMLEY FARM RD	X				
EB	2.240	A	VD-062AS	72	16		BUSINESS SIGN			1																			
		A	VD-062BRN	72	16		BUSINESS SIGN			1																			
		A	VD-062AS	72	16		BUSINESS SIGN			1																			
EB	2.300	A	W2-3L	30	30		INTERSECTION WARNING																						
		A	VW-205	36	36		WATCH FOR TURNING VEHICLES																						
		A	W13-1	24	24		SPEED ADVISORY																						
SIGN SUMMARY SHEET							SHEET TOTALS		28.50	0.00	3	0	0	6	0	0	5	75							PROJECT NAME: Manchester-Springfield				
							SF	SF	EA	EA	EA	EA	EA	EA	EA	EA	EA	EA	EA	EA	EA	EA	EA	EA	EA	EA	EA	PROJECT NUMBER: STPG SIGN(25)	
VERMONT AGENCY OF TRANSPORTATION							TOWN TOTALS		381.1	0.0	16.0	0.0	0.0	73	2.0	0.0	60	900.0							FILE NAME: Peru VT11.xls	PLOT DATE: 4/8/2009			
																									DESIGNED BY: A. Gamble			DRAWN BY: T. Guazzoni	
																					CHECKED BY: S. Menard			SHEET 31 OF 115					