

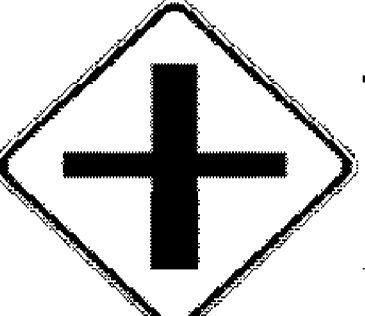





DIR	MILEPOINT	LOCATION CODE (SHEET 2)	MUTCD CODE	WIDTH (IN)	HEIGHT (IN)	SHEETING REMARKS	SIGN LEGEND FOR POST LENGTHS AND INSTALLATION DATES SEE ORIGINAL RECORD PLANS	NEW SIGNS		EXISTING SIGNS				EXIST POST		NUMBER OF NEW POSTS	SQUARE STEEL (in) (LB / FT)			TUBULAR STEEL Ø (IN) (LB / FT)				SIGN FRAME REQUIRED	REMARKS	SIGN DETAIL					
								"A"	"B"	RETAIN	SALVAGE FROM	SALVAGE TO	REMOVE	RETAIN	REMOVE		2.00	2.00	2.50	FOUNDATION	3.00	3.50	4.00			5.00	DETAIL IN SHS	DETAIL ON SHEET NUMBER	DETAIL ON STD SHEET NUMBER		
																														2.16	2.42
PERU VT 11							"FY"-FLUORESCENT YELLOW "FYG"-FLUORESCENT YELLOW GREEN																"SHS"-STANDARD HIGHWAY SIGNS								
		H	R1-1	30	30		 	6.25																			TH-2, MAIN ST	X			
WB	3.000	F	M3-4	24	12																										
		F	M1-5A	30	24																										
		F	M3-4	24	12			2.00																				GREEN ON WHITE SHEETING	X		
		F	M1-5A	24	24			4.00																						E-136B	
WB	2.920	F	VD-062B	72	16					1																					
WB	2.875	F	W13-1	18	18		INTERSECTION WARNING																								
		F	W2-1	30	30		40 MPH ADVISORY PLAQUE																								
WB	2.825	F	W2-1Mb	30	30		 	6.25																			MOVE 250 FT +/- WEST OF EXISTING LOCATION			6	
		F	W16-8	24	8			1.33																				South Rd IN UPPER AND LOWER CASE	X		
WB	2.742	G	VR-017	24	30																										
		G	VR-017	24	30			5.00																				TH-3, SOUTH RD			E-141
WB	2.732	H	R1-1	30	30																										
		H	R1-1	30	30			6.25																				TH-3, SOUTH RD	X		
WB	2.570	F	W2-2L	30	30		SIDE ROAD WARNING																								
SIGN SUMMARY SHEET							SHEET TOTALS		31.08	0.00	1	0	0	5	1	0	5	75									PROJECT NAME: Manchester-Springfield				
							SF	SF	EA	EA	EA	EA	EA	EA	EA	EA	EA	EA	EA	EA	EA	EA	EA	EA	EA	EA	EA	EA	PROJECT NUMBER: STPG SIGN(25)		
							TOWN TOTALS		381.1	0.0	16.0	0.0	0.0	73	2.0	0.0	60	900.0												FILE NAME: Peru VT11.xls	PLOT DATE: 4/8/2009
VERMONT AGENCY OF TRANSPORTATION																						DESIGNED BY: A. Gamble			DRAWN BY: T. Guazzoni						
																						PERU SHEET 8			CHECKED BY: S. Menard						
																									SHEET 36 OF 115						