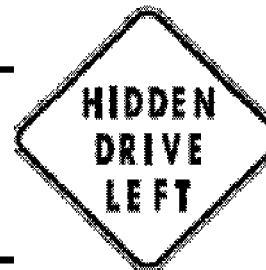
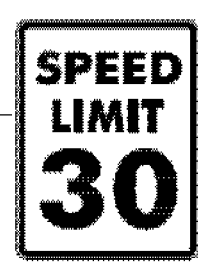

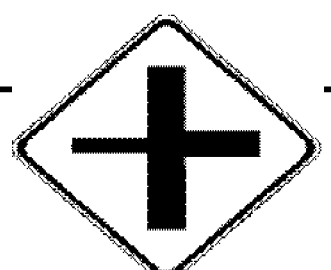
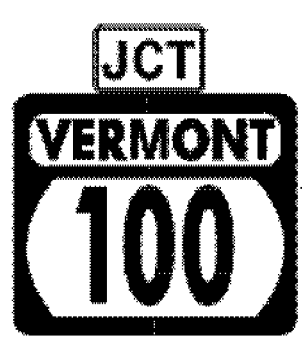


| DIR | MILEPOINT | LOCATION CODE (SHEET 2) | MUTCD CODE | WIDTH (IN) | HEIGHT (IN) | SHEETING REMARKS | SIGN LEGEND FOR POST LENGTHS AND INSTALLATION DATES SEE ORIGINAL RECORD PLANS | NEW SIGNS | | EXISTING SIGNS | | | EXIST POST | | NUMBER OF NEW POSTS | SQUARE STEEL (in) (LB / FT) | | | TUBULAR STEEL Ø (IN) (LB / FT) | | | | SIGN FRAME REQUIRED | REMARKS | SIGN DETAIL | | | | |
|----------------------------------|-----------|-------------------------|------------|------------|-------------|------------------|--|-----------|------|----------------|--------------|------------|------------|--------|---------------------|-----------------------------------|------|--------|--------------------------------------|------------|------|------------------------------|--|-----------------------------------|--|------|---------------|------------------------|----------------------------|
| | | | | | | | | "A" | "B" | RETAIN | SALVAGE FROM | SALVAGE TO | REMOVE | RETAIN | | REMOVE | 2.00 | 2.00 | 2.50 | FOUNDATION | 3.00 | 3.50 | | | 4.00 | 5.00 | DETAIL IN SHS | DETAIL ON SHEET NUMBER | DETAIL ON STD SHEET NUMBER |
| | | | | | | | | | | | | | | | | | | | | | | | | | | | | | |
| LONDONDERRY VT11 | | | | | | | "FY"-FLUORESCENT YELLOW "FYG"-FLUORESCENT YELLOW GREEN | | | | | | | | | | | | | | | "SHS"-STANDARD HIGHWAY SIGNS | | | | | | | |
| | | A | VW-054L | 30 | 30 | | HIDDEN DRIVE LEFT | | | | | | | | | | | | | | | | | | | | | | |
| EB | 1.569 | | VW-054L | 30 | 30 | |  | 6.25 | | | | | | | 1 | | X | | | | | | | | INSTALL 100 FT ± EAST OF PREVIOUS LOCATION | | | E154 | |
| EB | 1.630 | A | R2-1 | 24 | 30 | |  | | | | | | | | | | | | | | | | | | | | | | |
| | | A | R2-1 | 30 | 36 | | | 7.50 | | | | | | | 1 | | X | | | | | | | | | | 6 | | |
| EB | 1.670 | A | VD-018 | 30 | 18 | |  | 3.75 | | | | | | | 1 | | X | | | | | | | | INSTALL 200 FT ± EAST OF SPEED LIMIT 30 SIGN | | | E-128A | |
| EB | 1.750 | A | W2-1M | 30 | 30 | | 4-WAY INTERSECTION SYMBOL | | | | | | | | | | | | | | | | | | | | | | |
| | | A | W16-2 | 24 | 18 | | 1000 FEET (PLAQUE) | | | | | | | | | | | | | | | | | | | | | | |
| EB | 1.770 | A | W2-1Ma | 36 | 36 | |  | 9.00 | | | | | | | 2 | | X | | | | | | | | INSTALL 100 FT ± EAST OF PREVIOUS LOCATION | | | 6 | |
| EB | 1.810 | A | M2-1 | 21 | 15 | | JCT | | | | | | | | | | | | | | | | | | | | | | |
| | | A | M1-5 | 30 | 24 | | VERMONT 100 | | | | | | | | | | | | | | | | | | | | | | |
| | | A | VD-700 | 6 | 8 | | MILE MARKER | | | | | | | | | | | | | | | | | | | | | | |
| | | A | M2-1 | 21 | 15 | |  | 2.19 | | | | | | | 1 | | X | | | | | | | | GREEN ON WHITE SHEETING | X | | | |
| | | A | M1-5 | 30 | 24 | | | 5.00 | | | | | | | | | | | | | | | | | | | E-136B | | |
| | | A | VD-700 | 6 | 8 | | MILE MARKER | | | | | | | | | | | | | | | | | | | | | | |
| EB | 1.850 | A | D1-1A | 72 | 10 | | | | | | | | | | | | | | | | | | | | | | | | |
| SIGN SUMMARY SHEET | | | | | | | SHEET TOTALS | 33.69 | 0.00 | 0 | 1 | 1 | 7 | 0 | 0 | 6 | | 90 | | | | | PROJECT NAME: Manchester-Springfield VT11 | | | | | | |
| | | | | | | | SF | SF | EA | EA | EA | EA | EA | EA | EA | EA | FT | | | | | | PROJECT NUMBER: STPG SIGN(25) | | | | | | |
| | | | | | | | TOWN TOTALS | 932.0 | 0.0 | 0.0 | 3.0 | 3.0 | 198 | 0.0 | 1.0 | 132 | | 1980.0 | | | | | | FILE NAME: Londonderrv.xls | | | | | |
| VERMONT AGENCY OF TRANSPORTATION | | | | | | | | | | | | | | | | | | | | | | | PLOT DATE: 4/6/2009 | | | | | | |
| | | | | | | | | | | | | | | | | | | | | | | | DRAWN BY: T. Guazzoni | | | | | | |
| | | | | | | | | | | | | | | | | | | | | | | | DESIGNED BY: D. Crossley | | | | | | |
| | | | | | | | | | | | | | | | | | | | | | | | CHECKED BY: S. Menard | | | | | | |
| | | | | | | | | | | | | | | | | | | | | | | | LONDONDERRY SHEET 3 | | | | | | |
| | | | | | | | | | | | | | | | | | | | | | | | SHEET 44 OF 115 | | | | | | |