

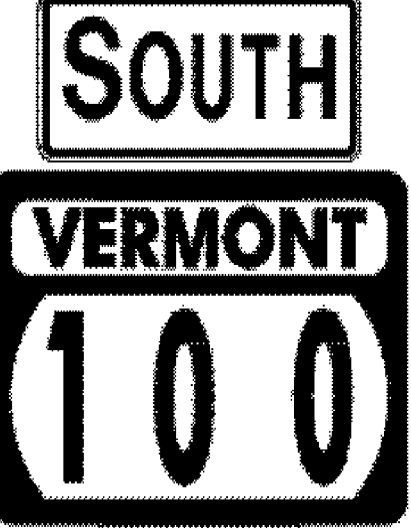



DIR	MILEPOINT	LOCATION CODE (SHEET 2)	MUTCD CODE	WIDTH (IN)	HEIGHT (IN)	SHEETING REMARKS	SIGN LEGEND FOR POST LENGTHS AND INSTALLATION DATES SEE ORIGINAL RECORD PLANS	NEW SIGNS		EXISTING SIGNS			EXIST POST		NUMBER OF NEW POSTS	SQUARE STEEL (in) (LB / FT)			TUBULAR STEEL Ø (IN) (LB / FT)				SIGN FRAME REQUIRED	REMARKS	SIGN DETAIL										
								"A"	"B"	RETAIN	SALVAGE FROM	SALVAGE TO	REMOVE	RETAIN		REMOVE	2.00	2.00	2.50	FOUNDATION	3.00	3.50			4.00	5.00	DETAIL IN SHS	DETAIL ON SHEET NUMBER	DETAIL ON STD SHEET NUMBER						
																														2.16	2.42	3.35	7.60	9.00	10.80
LONDONDERRY VT11							"FY"-FLUORESCENT YELLOW "FYG"-FLUORESCENT YELLOW GREEN															"SHS"-STANDARD HIGHWAY SIGNS													
			A	M6-1S	21	15	RIGHT ARROW																												
			A	M3-2	24	12		2.00														#3	INSTALL ON EXISTING POSTS; REPLACE SIGN FRAME. "EAST" IS GREEN ON WHITE.	X		7									
			A	M1-5	24	24		4.00																									E-136B		
			A	M6-3	21	15		2.19															GREEN ON WHITE	X											
			A	M3-1	24	12		2.00															GREEN ON WHITE	X											
			A	M1-5	30	24		5.00																									E-136B		
			A	M6-3	21	15		2.19															GREEN ON WHITE	X											
			A	M3-3	24	12		2.00															GREEN ON WHITE	X											
			A	M1-5	30	24		5.00																									E-136B		
			A	M6-1	21	15		2.19															GREEN ON WHITE	X											
EB	1.950		A	M3-2	24	12	EAST																												
			A	M1-5	24	24	VERMONT 11																												
			A	M3-2	24	12		2.00															GREEN ON WHITE	X											
			A	M1-5	24	24		4.00																									E-136B		
EB	1.985		A	R2-1	24	30																													
SIGN SUMMARY SHEET							SHEET TOTALS	32.57	0.00	0	0	0	5 4	0	0	1	15							PROJECT NAME: Manchester-Springfield VT11											
								SF	SF	EA	EA	EA	EA	EA	EA	EA	FT							PROJECT NUMBER: STPG SIGN(25)											
VERMONT AGENCY OF TRANSPORTATION							TOWN TOTALS	932.0	0.0	0.0	3.0	3.0	198	0.0	1.0	132	1980.0						FILE NAME: Londonderrv.xls	PLOT DATE: 4/6/2009											
																							PROJECT MANAGER: N. Avery	DRAWN BY: T. Guazzoni											
																							DESIGNED BY: D. Crossley	CHECKED BY: S. Menard											
																							LONDONDERRY SHEET 5	SHEET 46	OF 115										