



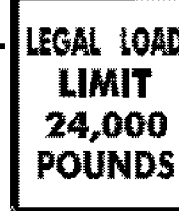


DIR	MILEPOINT	LOCATION CODE (SHEET 2)	MUTCD CODE	WIDTH (IN)	HEIGHT (IN)	SHEETING REMARKS	SIGN LEGEND	NEW SIGNS		EXISTING SIGNS			EXIST POST		NUMBER OF NEW POSTS	SQUARE STEEL (in)			TUBULAR STEEL Ø (IN)				SIGN FRAME REQUIRED	REMARKS	SIGN DETAIL				
								"A"	"B"	RETAIN	SALVAGE FROM	SALVAGE TO	REMOVE	RETAIN		REMOVE	2.00	2.00	2.50	FOUNDATION	3.00	3.50			4.00	5.00	DETAIL IN SHS	DETAIL ON SHEET NUMBER	DETAIL ON STD SHEET NUMBER
																	(LB / FT)				(LB / FT)								
LONDONDERRY VT11							"FY"-FLUORESCENT YELLOW "FYG"-FLUORESCENT YELLOW GREEN																"SHS"-STANDARD HIGHWAY SIGNS						
WB	4.270	F	VW-054	30	30																								
		F	VW-054	30	30			6.25																			E-154		
WB	3.845	F	VW-133A	30	30																								
WB	3.820	F	VW-133A	30	30			6.25																			E-154		
WB	3.265	F	VW-730	30	30		TRUCKS ENTERING																						
WB	3.210	F	VW-205	30	30		WATCH FOR TURNS AHEAD																						
		F	S3-1	30	30		SCHOOL BUS STOP AHEAD																						
WB	3.175	F	N/A	18	18		ROTARY SIGNS																						
																													
WB	3.072	G	VR-017	24	30			5.00																			E-141		
	3.080	H	R1-1	24	24		STOP (INSTALLED BACK-TO-BACK WITH LEGAL LOAD SIGN)																						
	3.080	G	VR-017	24	24		LEGAL LOAD LIMIT 24000 POUNDS																						
	3.080	H	R1-1	30	30			6.25			1	1			1												E-141		
WB	2.710	F	R2-5A	24	30		REDUCED SPEED AHEAD																						
																													
WB	2.700	G	VR-017	24	30			5.00																			E-141		
WB	2.690	H	R1-1	24	24		STOP (INSTALLED BACK-TO-BACK WITH LEGAL LOAD SIGN)																						
SIGN SUMMARY SHEET							SHEET TOTALS		28.75	0.00	0	0	0	12	0	0	5	60							PROJECT NAME: Manchester-Springfield VT11				
							SF	SF			EA	EA	EA	EA	EA	EA		FT							PROJECT NUMBER: STPG SIGN(25)				
							TOWN TOTALS		932.0	0.0	0.0	3.0	3.0	198	0.0	1.0	132	1980.0							FILE NAME: Londonderrv.xls				
VERMONT AGENCY OF TRANSPORTATION																									PLOT DATE: 4/6/2009				
																									DRAWN BY: T. Guazzoni				
																									CHECKED BY: S. Menard				
																									SHEET 61 OF 115				