
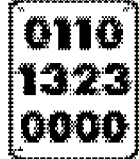




DIR	MILEPOINT	LOCATION CODE (SHEET 2)	MUTCD CODE	WIDTH (IN)	HEIGHT (IN)	SHEETING REMARKS	SIGN LEGEND	NEW SIGNS		EXISTING SIGNS			EXIST POST		NUMBER OF NEW POSTS	SQUARE STEEL (in)			TUBULAR STEEL Ø (IN)				SIGN FRAME REQUIRED	REMARKS	SIGN DETAIL				
								"A"	"B"	RETAIN	SALVAGE FROM	SALVAGE TO	REMOVE	RETAIN		REMOVE	2.00	2.00	2.50	FOUNDATION	3.00	3.50			4.00	5.00	DETAIL IN SHS	DETAIL ON SHEET NUMBER	DETAIL ON STD SHEET NUMBER
																	(LB / FT)				(LB / FT)								
WINDHAM VT11							"FY"-FLUORESCENT YELLOW "FYG"-FLUORESCENT YELLOW GREEN															"SHS"-STANDARD HIGHWAY SIGNS							
EB	0.000	C	VD-024	60	7.5																								
		C	VD-024	72	10			5.00										X							4				
		C	VD-700	86	10			0.56 0.42																		E-138			
		C	VD-700	86	10			0.56 0.42																		E-138			
EB	0.023	A	VD-062AS	72	16		BUSINESS SIGN			1								X											
EB	0.093	C	VR-017	24	30																								
		C	VR-017	24	30			5.00										X								HORSENAIL HILL RD (TH-6)	E-141		
EB	0.097	D	R1-1	30	30						1																		
		D	R1-1	30	30			6.25				1						X						X		HORSENAIL HILL RD (TH-6)			
SIGN SUMMARY SHEET							SHEET TOTALS	17.37 17.09	0.00	1	0	0	3	0	0	4	60							PROJECT NAME: Manchester-Springfield VT11					
VERMONT AGENCY OF TRANSPORTATION								SF	SF	EA	EA	EA	EA	EA	EA	EA	FT							PROJECT NUMBER: STPG SIGN(25)					
							TOWN TOTALS	17.1	0.0	1.0	0.0	0.0	3	0.0	0.0	4	60.0							FILE NAME: Windham VT11.xls	PLOT DATE: 4/6/2009				
																							PROJECT MANAGER: N. Avery	DRAWN BY: T. Guazzoni					
																							DESIGNED BY: D. Crosslev	CHECKED BY: S. Menard					
																							WINDHAM SHEET 1	SHEET 71	OF 115				