




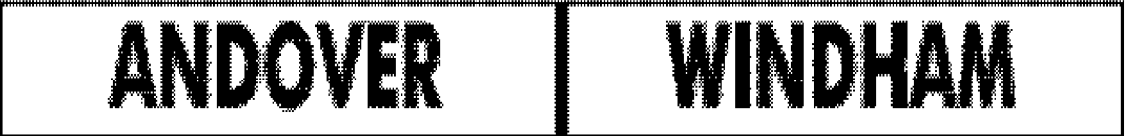


DIR	MILEPOINT	LOCATION CODE (SHEET 2)	MUTCD CODE	WIDTH (IN)	HEIGHT (IN)	SHEETING REMARKS	SIGN LEGEND FOR POST LENGTHS AND INSTALLATION DATES SEE ORIGINAL RECORD PLANS	NEW SIGNS		EXISTING SIGNS			EXIST POST		NUMBER OF NEW POSTS	SQUARE STEEL (in)			TUBULAR STEEL Ø (IN)				SIGN FRAME REQUIRED	REMARKS	SIGN DETAIL				
								"A"	"B"	RETAIN	SALVAGE FROM	SALVAGE TO	REMOVE	RETAIN		REMOVE	2.00	2.00	2.50	FOUNDATION	3.00	3.50			4.00	5.00	DETAIL IN SHS	DETAIL ON SHEET NUMBER	DETAIL ON STD SHEET NUMBER
																	(LB / FT)				(LB / FT)								
ANDOVER VT11							"FY"-FLUORESCENT YELLOW "FYG"-FLUORESCENT YELLOW GREEN															"SHS"-STANDARD HIGHWAY SIGNS							
EB	0.000	C	VD-025	60	7.5		ANDOVER - WINDHAM																						
		C	VD-024	60	7.5		WINDSOR CO - WINDHAM CO																						
		C	VD-700	6	8		0110-1401-000																						
		C	VD-700	6	8		0110-1323-0036																						
		C	VD-025	72	10			5.00							2			X										4	
		C	VD-024	72	10			5.00																				4	
		C	VD-700	86	10		 	0.56 0.42																				E-138	
		C	VD-700	86	10			0.56 0.42																				E-138	
EB	0.340	A	S3-1	30	30		SCHOOL BUS STOP AHEAD																						
EB	0.820	A	W2-3MaR	30	30			6.25																					
		A	W16-8	18	8			1.00																		X			
EB	1.465	A	W1-2R	30	30		CURVE RIGHT				1																		
		A	W13-1	24	24		40 MPH PLAQUE				1																		
EB	1.520	A	W2-2MR	30	30		HIDDEN MINOR SIDE ROAD RIGHT (SYMBOL)																						
		A	W16-8A	30	18		CASTALDO ROAD PLAQUE																						
SIGN SUMMARY SHEET							SHEET TOTALS	18.37 18:09	0.00	2	2	0	5	0	0	3	45							PROJECT NAME: Manchester-Springfield VT11					
VERMONT AGENCY OF TRANSPORTATION							TOWN TOTALS	69.1	0.0	12.0	8.0	8.0	17	0.0	0.0	15	225.0							PROJECT NUMBER: STPG SIGN(25)					
								SF	SF	EA	EA	EA	EA	EA	EA	EA	FT							FILENAME: Andover VT11.xls	PLOT DATE: 4/6/2009				
																								PROJECT MANAGER: N. Avery	DRAWN BY: T. Guazzoni				
																							DESIGNED BY: M. Miller	CHECKED BY: S. Menard					
																							ANDOVER SHEET 1	SHEET 72	OF 115				