
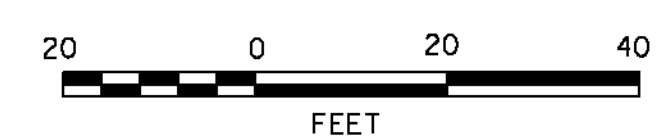
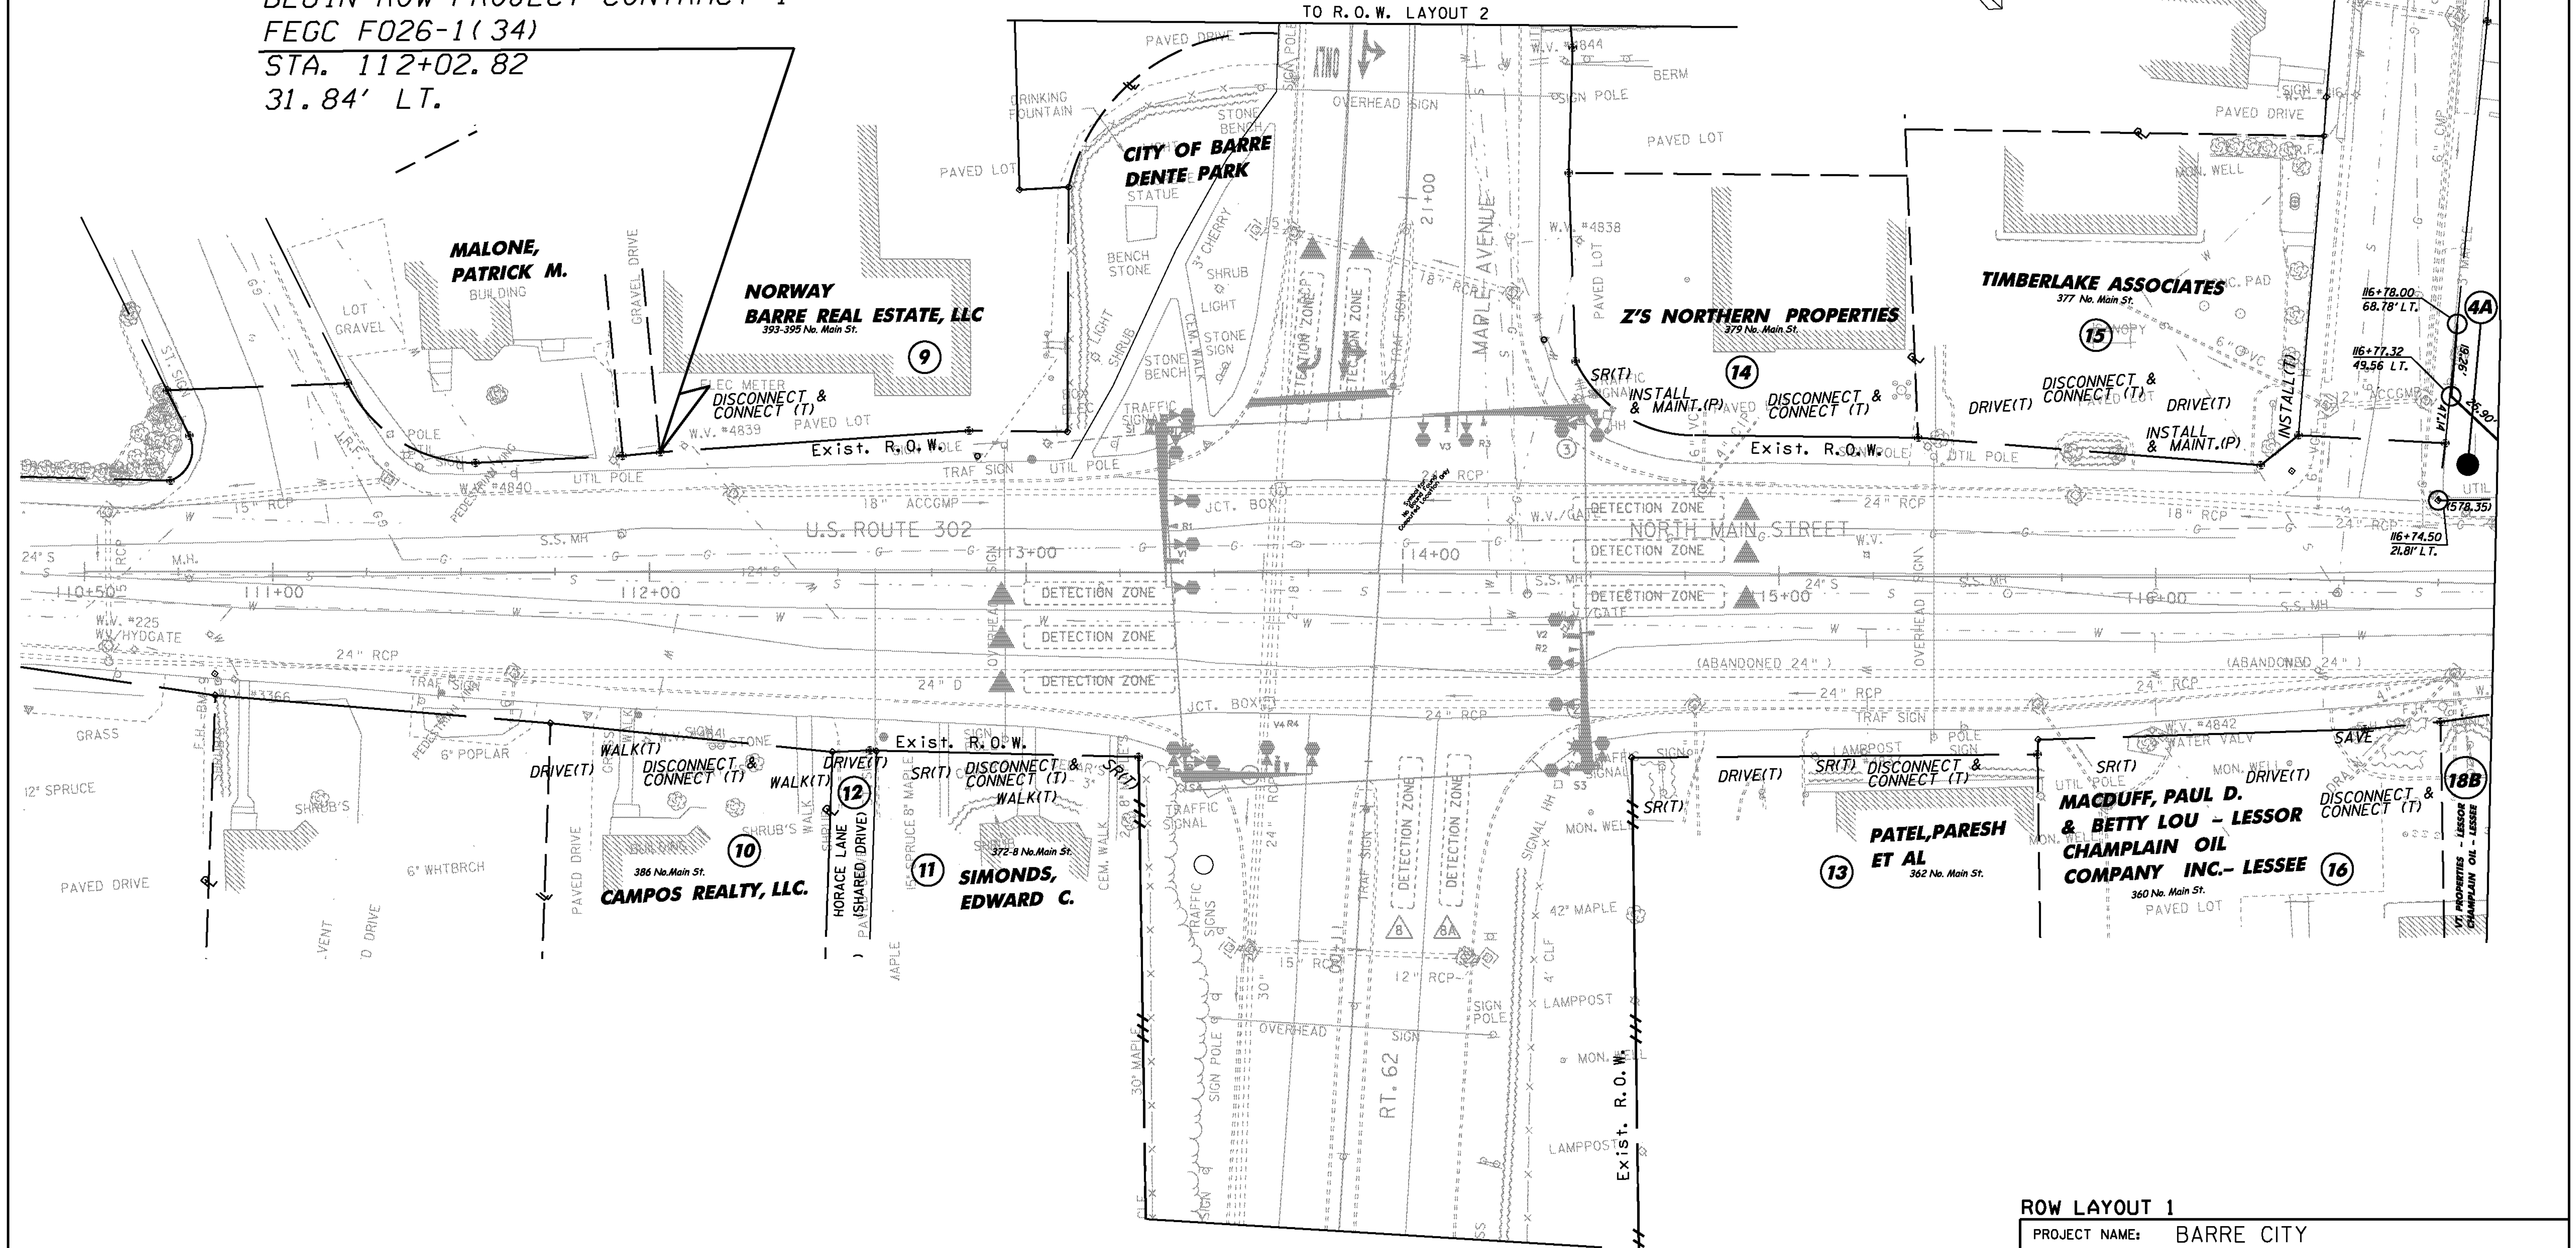


BEGIN ROW PROJECT CONTRACT I  
 FECC F026-1(34)  
 STA. 112+02.82  
 31.84' LT.

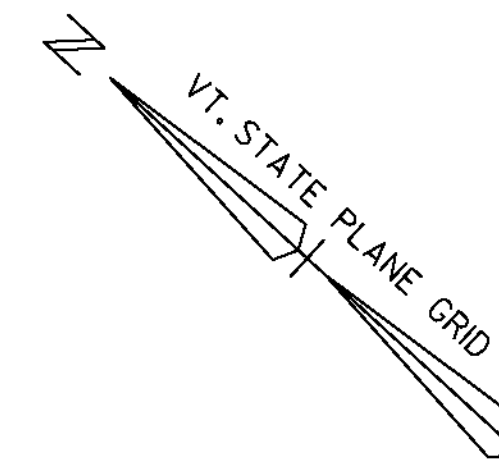

ROW LAYOUT 1	
PROJECT NAME:	BARRE CITY
PROJECT NUMBER:	FECC F 026-1(34) C/1
FILE NAME:	09B240BDR CP
PROJECT LEADER:	G. BAKOS
DESIGNED BY:	DMP / MDS
GENERAL PLAN	
PLOT DATE:	13-APR-2010
DRAWN BY:	DMP / JAR
CHECKED BY:	
SHEET	13 OF 95