

WILSON, COPPING
CROWTHER

81-85
NORTH ST. LLC
81-85 No. Main St.
DISCONNECT &
CONNECT (T)

ORMSBY
FAMILY
TRUST UA
71-77 No. Main St.
DISCONNECT &
CONNECT (T)

IB PROPERTY
HOLDINGS, LLC
47-59 No. Main St.
DISCONNECT &
CONNECT (T)

ALDRICH PUBLIC LIBRARY
6 Washington St.

UNIVERSALIST CHURCH,
THE FIRST CHURCH
IN BARRE

GRANITE CITY
HOLDING CO. INC.
84-88 No. Main St.
DISCONNECT &
CONNECT (T)

LACROSS, EDWARD H.
& YVONNE M.

MCCARTHY, MARK N. &
MCCARTHY, TODD G.
46-54 No. Main St.

TD BANK
26-40 No. Main St.


ABG CORP.
14-22 No. Main St.

SOUTH MAIN ST.

US POST
OFFICE
3 So. Main St.

ROW LAYOUT 6

PROJECT NAME: BARRE CITY
PROJECT NUMBER: FECC F 026-1(34) C/1

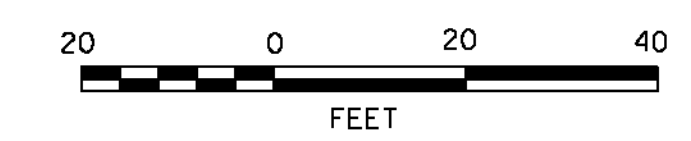

VHB Vanasse Hangen Brustlin, Inc.

FILE NAME: 09B240BDR CP
PROJECT LEADER: G. BAKOS
DESIGNED BY: DMP / MDS
GENERAL PLAN

PLOT DATE: 13-APR-2010
DRAWN BY: DMP / JAR
CHECKED BY:
SHEET 19 OF 95