
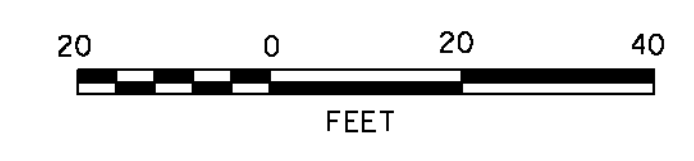


TO R. O. W. SHEET 29 OF 33

605+95

TO R. O. W. LAYOUT 6

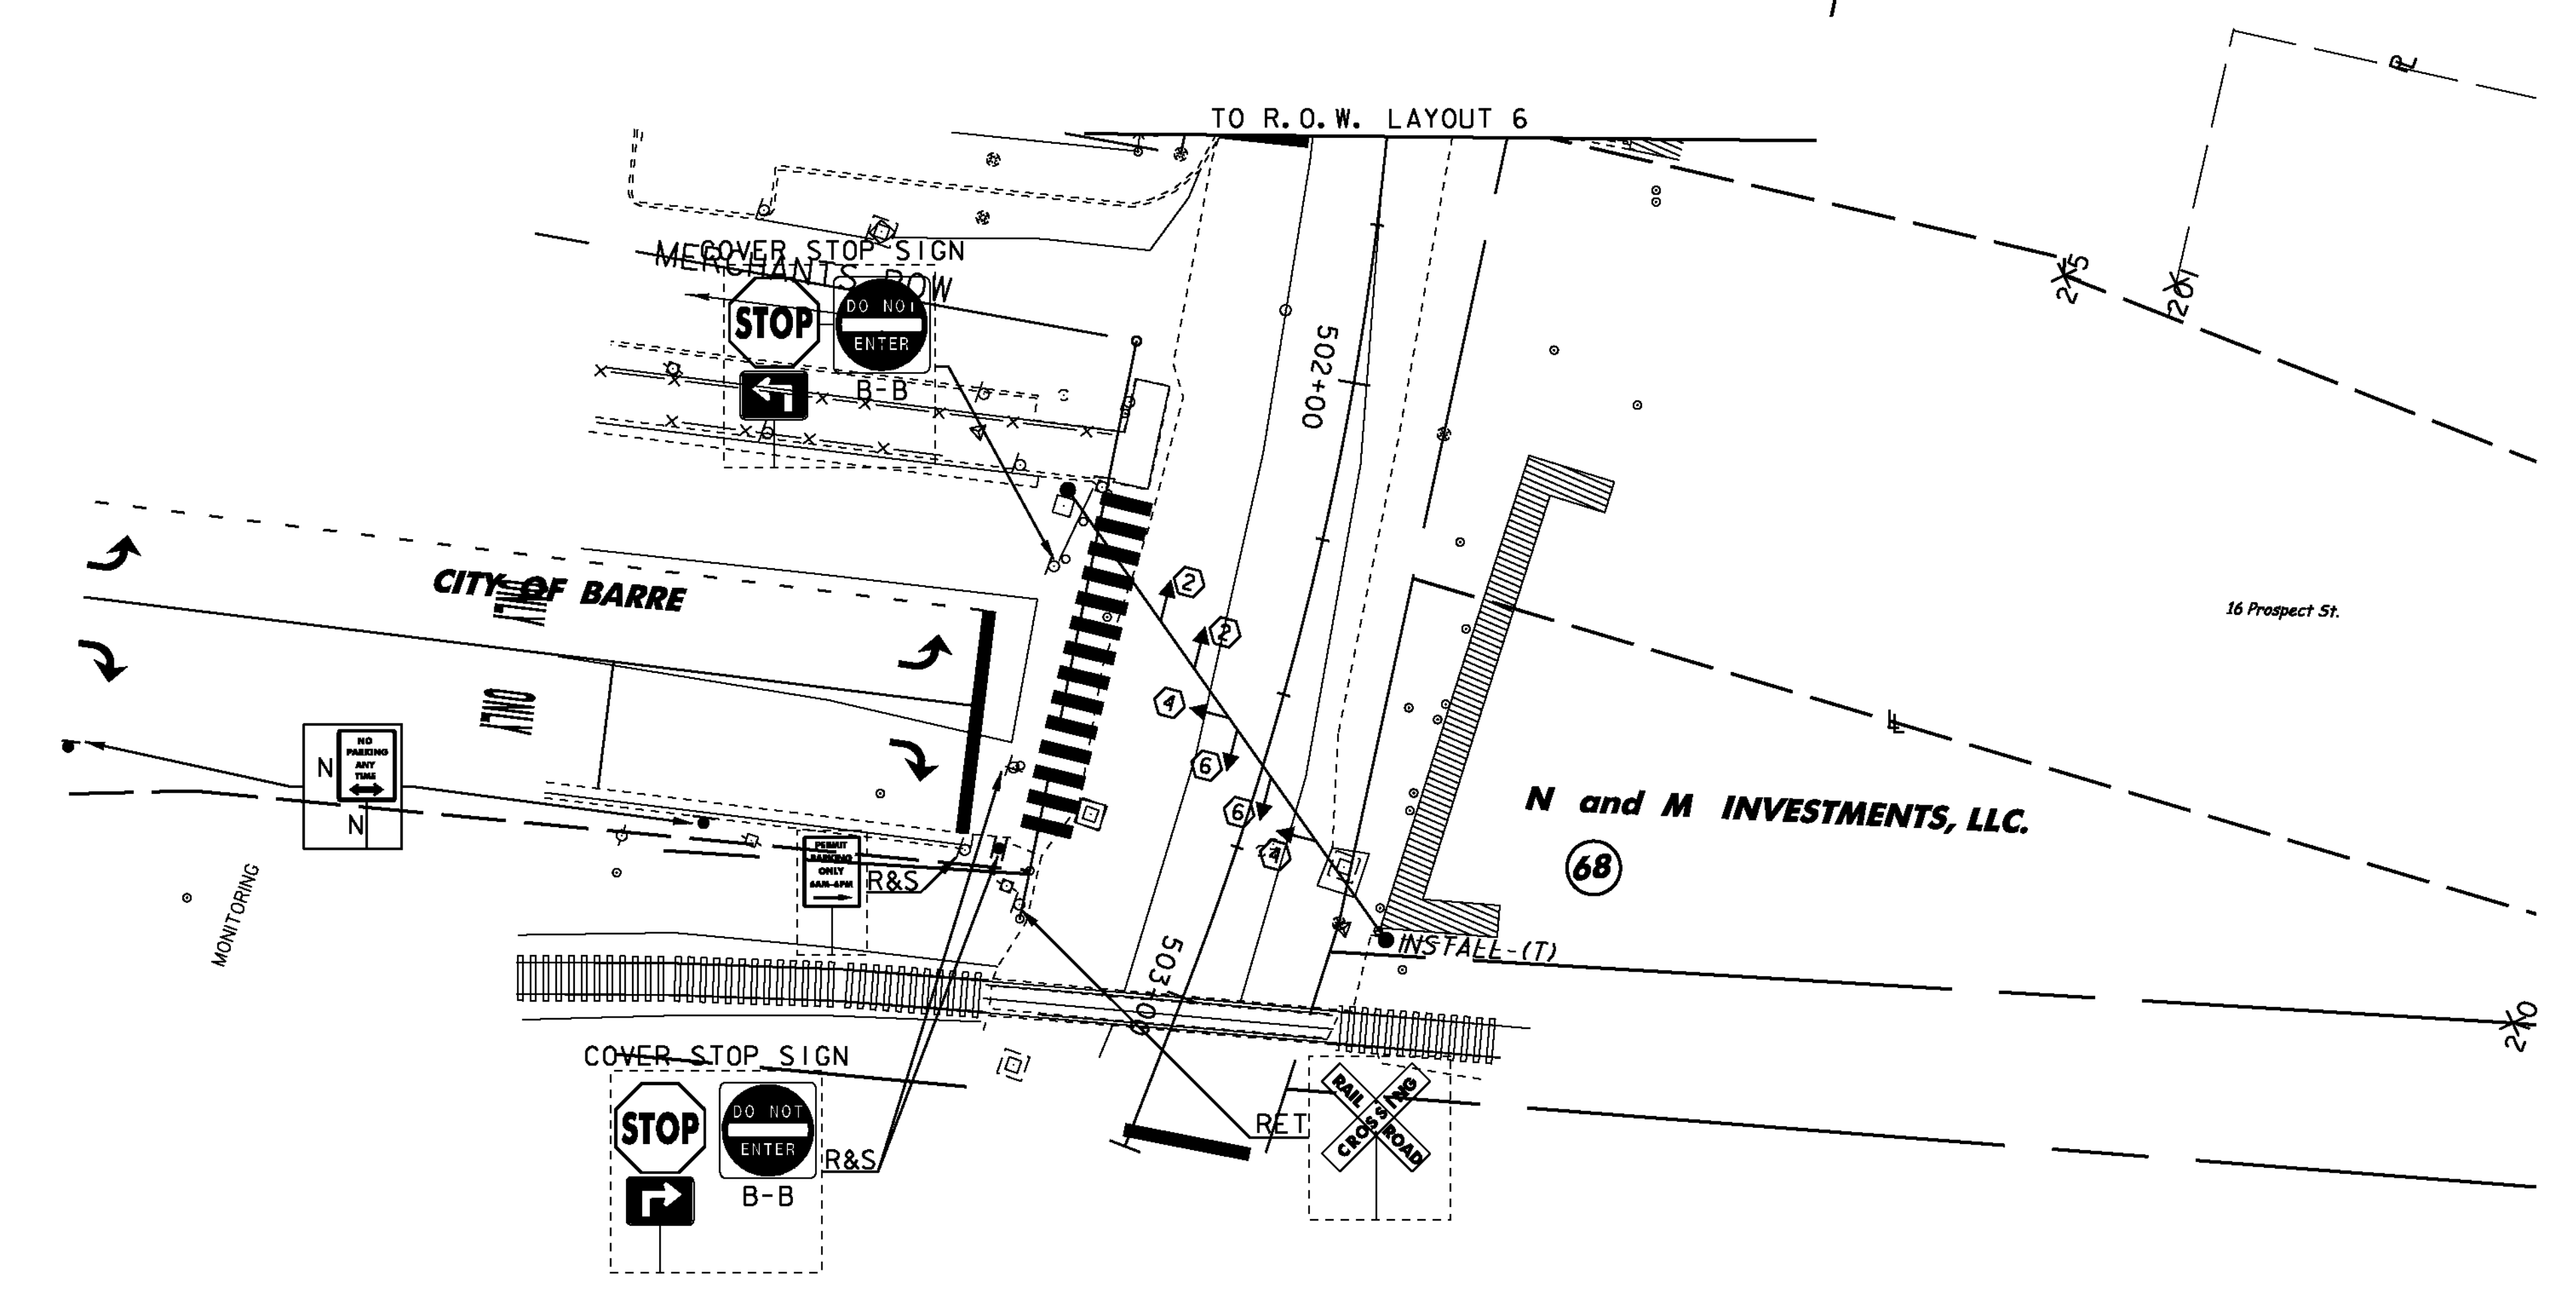

ROW LAYOUT 7	
PROJECT NAME: BARRE CITY	PLOT DATE: 13-APR-2010
PROJECT NUMBER: FECC F 026-1(34) C/1	DRAWN BY: DMP / JAR
FILE NAME: 09B240BDR CP	DESIGNED BY: DMP / MDS
PROJECT LEADER: G. BAKOS	CHECKED BY:
GENERAL PLAN	SHEET 20 OF 95

VHB Vanasse Hangen Brustlin, Inc.