


ROW LAYOUT 8

PROJECT NAME: BARRE CITY
PROJECT NUMBER: FECC F 026-1(34) C/1

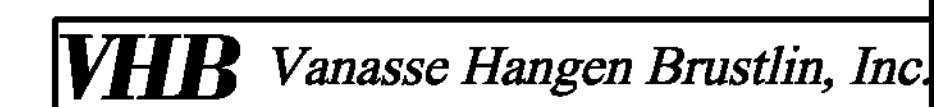

FILE NAME: 09B240BDR CP
PROJECT LEADER: G. BAKOS
DESIGNED BY: DMP / MDS
GENERAL PLAN

PLOT DATE: 13-APR-2010
DRAWN BY: DMP / JAR
CHECKED BY:
SHEET 21 OF 95