


ROW LAYOUT 9	
PROJECT NAME: BARRE CITY	PLOT DATE: 13-APR-2010
PROJECT NUMBER: FECC F 026-1(34) C/1	DRAWN BY: DMP / JAR
FILE NAME: 09B240BDR CP	DESIGNED BY: DMP / MDS
PROJECT LEADER: G. BAKOS	CHECKED BY:
GENERAL PLAN	SHEET 22 OF 95

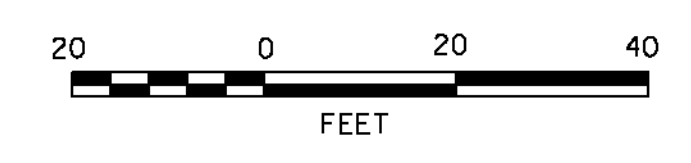

VHB Vanasse Hangen Brustlin, Inc.