


DATUM  
 VERTICAL NAVD 1929  
 HORIZONTAL NAD 27

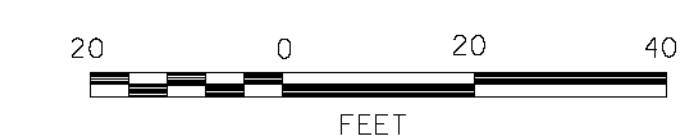

**VHB** Vanasse Hangen Brustlin, Inc.

AREA I

|                                |                                      |
|--------------------------------|--------------------------------------|
| PROJECT NAME: BARRE CITY       | PROJECT NUMBER: FECC F 026-1(34) C/1 |
| FILE NAME: z85b010bdr nu       | PLOT DATE: 4/5/2010                  |
| PROJECT LEADER: G. BAKOS       | DRAWN BY: D. PECK                    |
| DESIGNED BY: D. PECK           | CHECKED BY:                          |
| ALIGNMENT AND CURB LAYOUT PLAN | SHEET 25 OF 95                       |