


139+00

~~RIM ELEV. = 605.88~~  
~~18" INV IN (15) = 597.60~~  
~~18" INV OUT (2) = 597.50~~

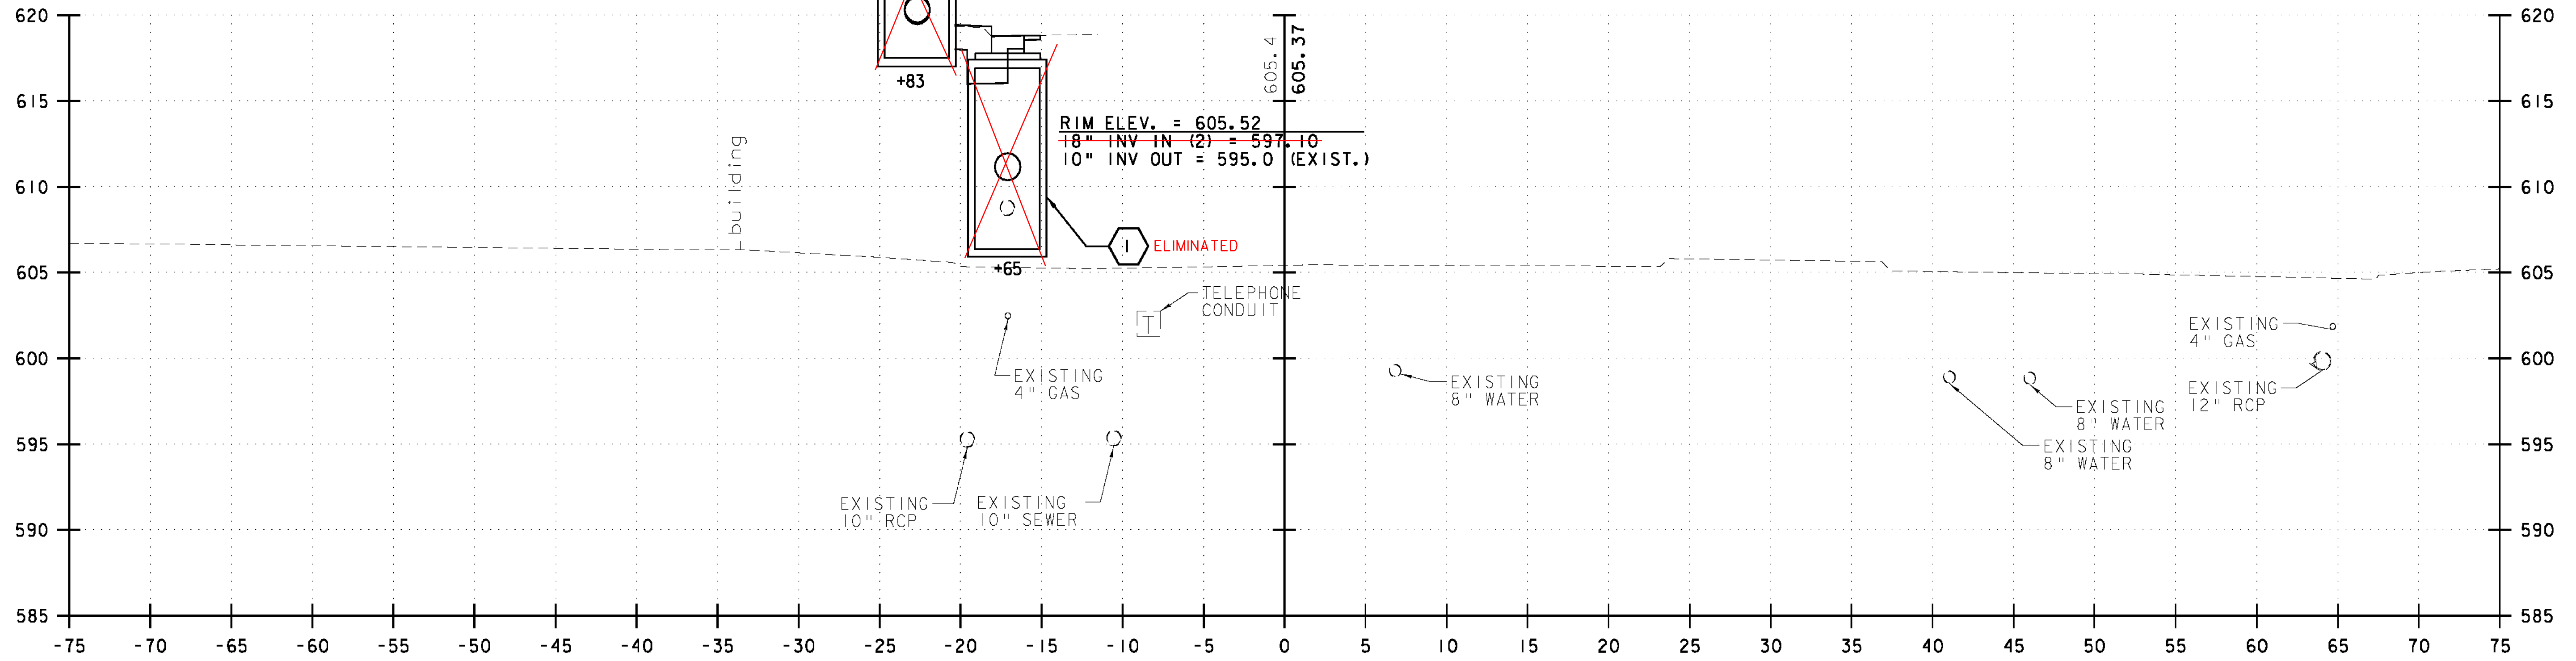

138+50

RIM ELEV. = 605.52  
~~18" INV IN (2) = 597.10~~  
~~10" INV OUT = 595.0 (EXIST.)~~



**VHB** Vanasse Hangen Brustlin, Inc.

NORTH MAIN STREET (US 302)	
PROJECT NAME:	BARRE CITY
PROJECT NUMBER:	FEGC F 026-1(34) C/1
FILE NAME:	z09B240_xsl_Cut.dgn
PROJECT LEADER:	G. BAKOS
DESIGNED BY:	DMP / MDS
CROSS SECTIONS	
PLOT DATE:	4/5/2010
DRAWN BY:	DMP / JAR
CHECKED BY:	
SHEET	74 OF 95