


707+50



707+00

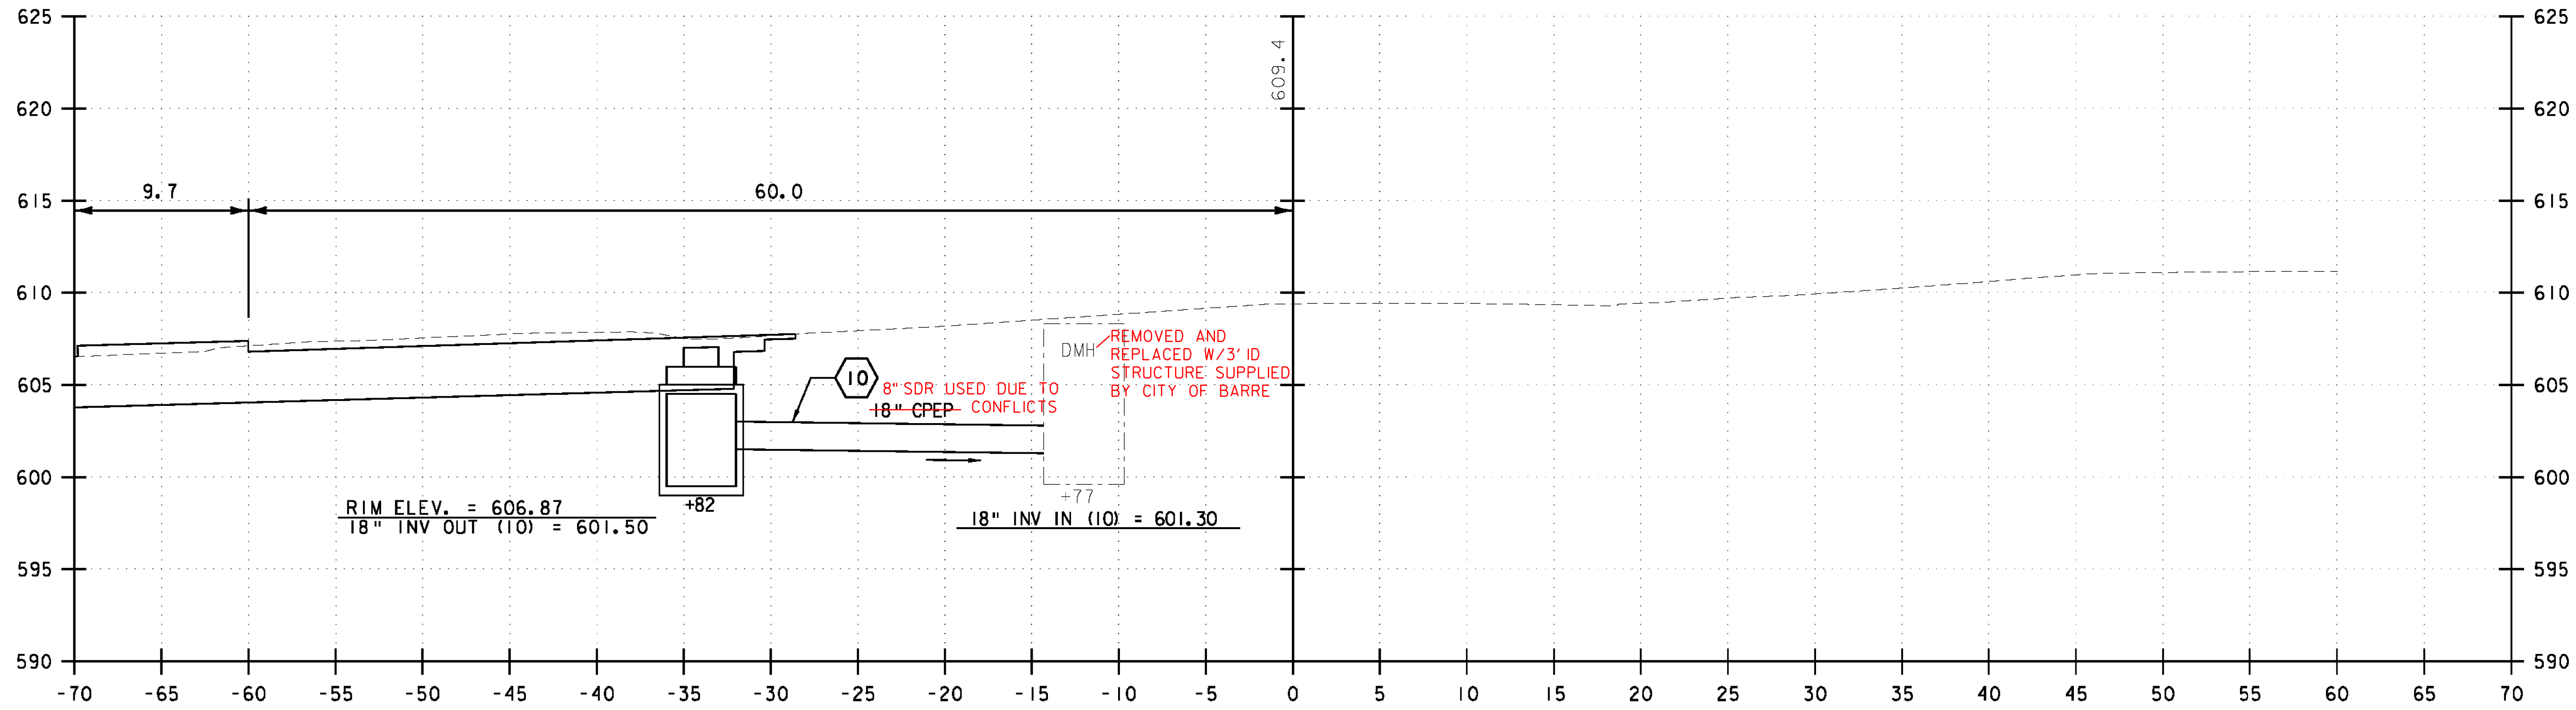

VHB Vanasse Hangen Brustlin, Inc.

ELM STREET	
PROJECT NAME:	BARRE CITY
PROJECT NUMBER:	FEGC F 026-1(34) C/1
FILE NAME:	z09B240_xsl_Cut.dgn
PROJECT LEADER:	G. BAKOS
DESIGNED BY:	DMP / MDS
CROSS SECTIONS	
PLOT DATE:	4/5/2010
DRAWN BY:	DMP / JAR
CHECKED BY:	
SHEET	89 OF 95