

STATE OF VERMONT AGENCY OF TRANSPORTATION




PROPOSED IMPROVEMENT TOWNS OF HARTFORD - EAST MONTPELIER COUNTIES OF WINDSOR, ORANGE, AND WASHINGTON VERMONT ROUTE 14

BEGINNING NORTH OF THE INTERSECTION OF US ROUTE 4, US ROUTE 5, AND VT ROUTE 14 IN THE TOWN OF HARTFORD
AT MILE MARKER 1.477 AND EXTENDING NORTHERLY ALONG VT ROUTE 14 FOR A DISTANCE OF 56.53 MILES
TO THE EAST MONTPELIER - CALAIS TOWN LINE AT MILE MARKER 5.821.
EXCLUDING CLASS 1 SECTIONS WITHIN THE PROJECT CORRIDOR.


LENGTH OF ROADWAY = 56.530 MILES
LENGTH OF PROJECT = 53.576 MILES

WORK TO BE PERFORMED UNDER THIS PROJECT INCLUDES THE REMOVAL OF EXISTING SIGNS AND POSTS
AND THE INSTALLATION OF NEW SIGNS AND SIGN POSTS AND INCIDENTAL ITEMS.

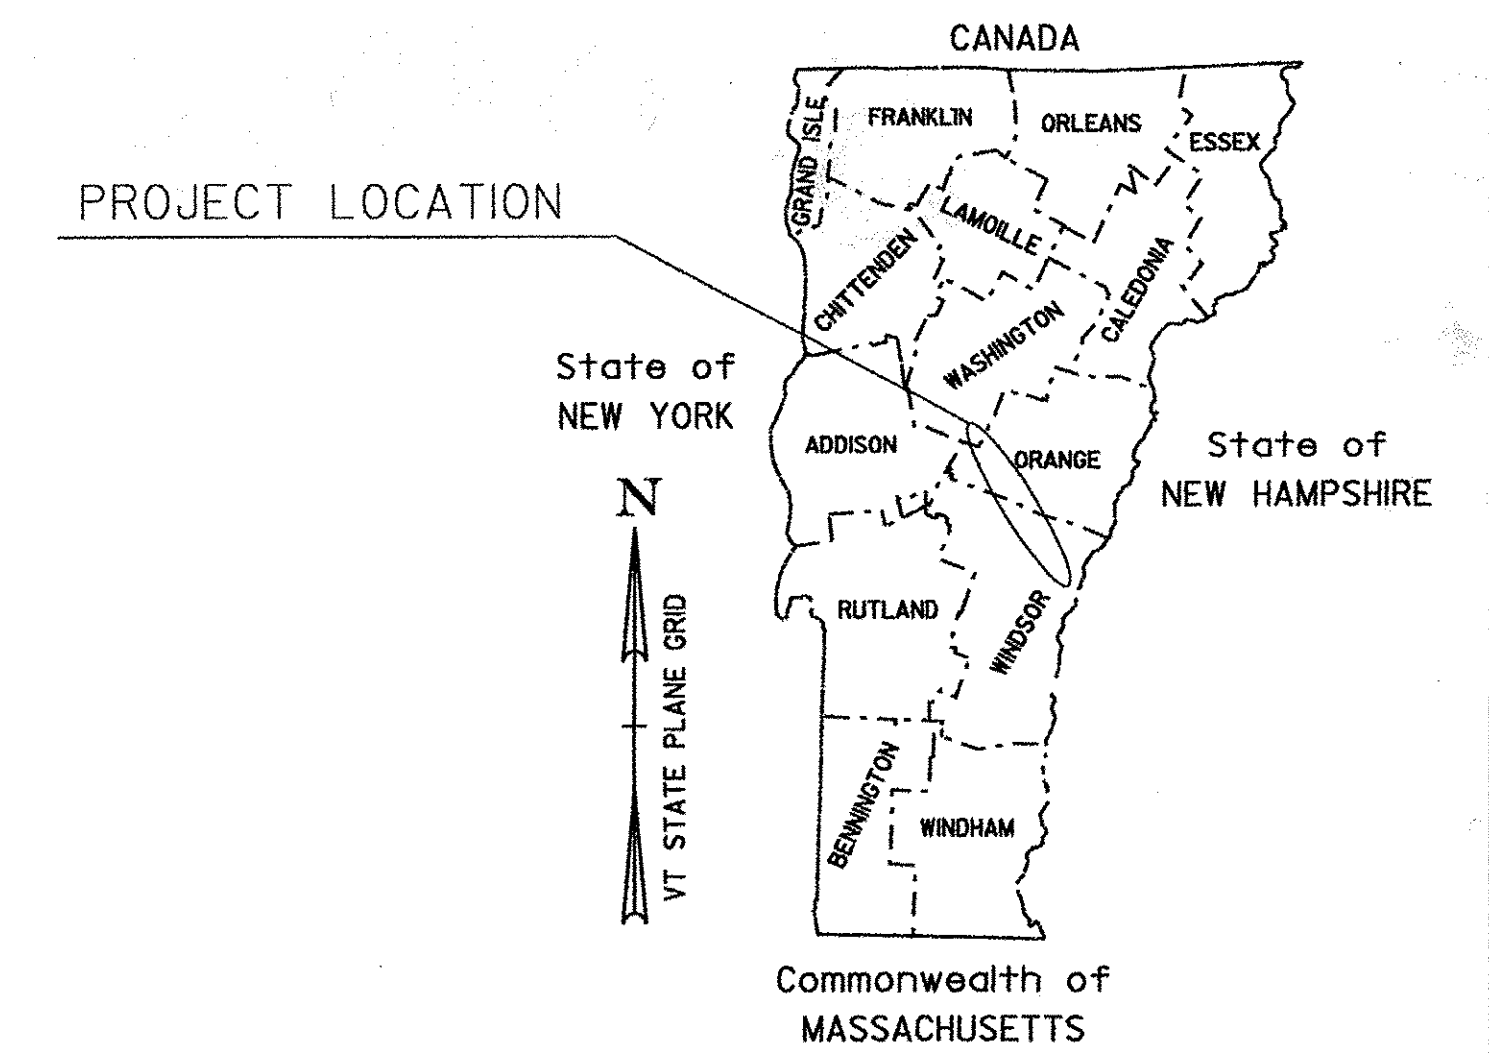

INDEX OF SHEETS
SEE SHEET 2

RECORD PLANS	
CONTRACTOR:	F. R. LAFAYETTE, INC. - ESSEX JUNCTION, VT
RESIDENT ENGINEER:	PAUL PERRY
CONSTRUCTION BEGAN:	SEPTEMBER 28, 2009
CONSTRUCTION COMPLETE:	JUNE 16, 2011
RECORD PLANS BY:	PAUL PERRY & AMOS KEMPTON
I HEREBY CERTIFY THAT ALL THE CONSTRUCTION REQUIRED BY THIS SET OF DRAWINGS HAS BEEN ACCOMPLISHED AS INDICATED HEREIN.	
BY	<i>Paul K. Perry</i> RESIDENT ENGINEER
DATE	9/12/11
NOTE: Any further information concerning final quantities, amounts or other details relative to this project may be found at Central Files in the electronic archives.	

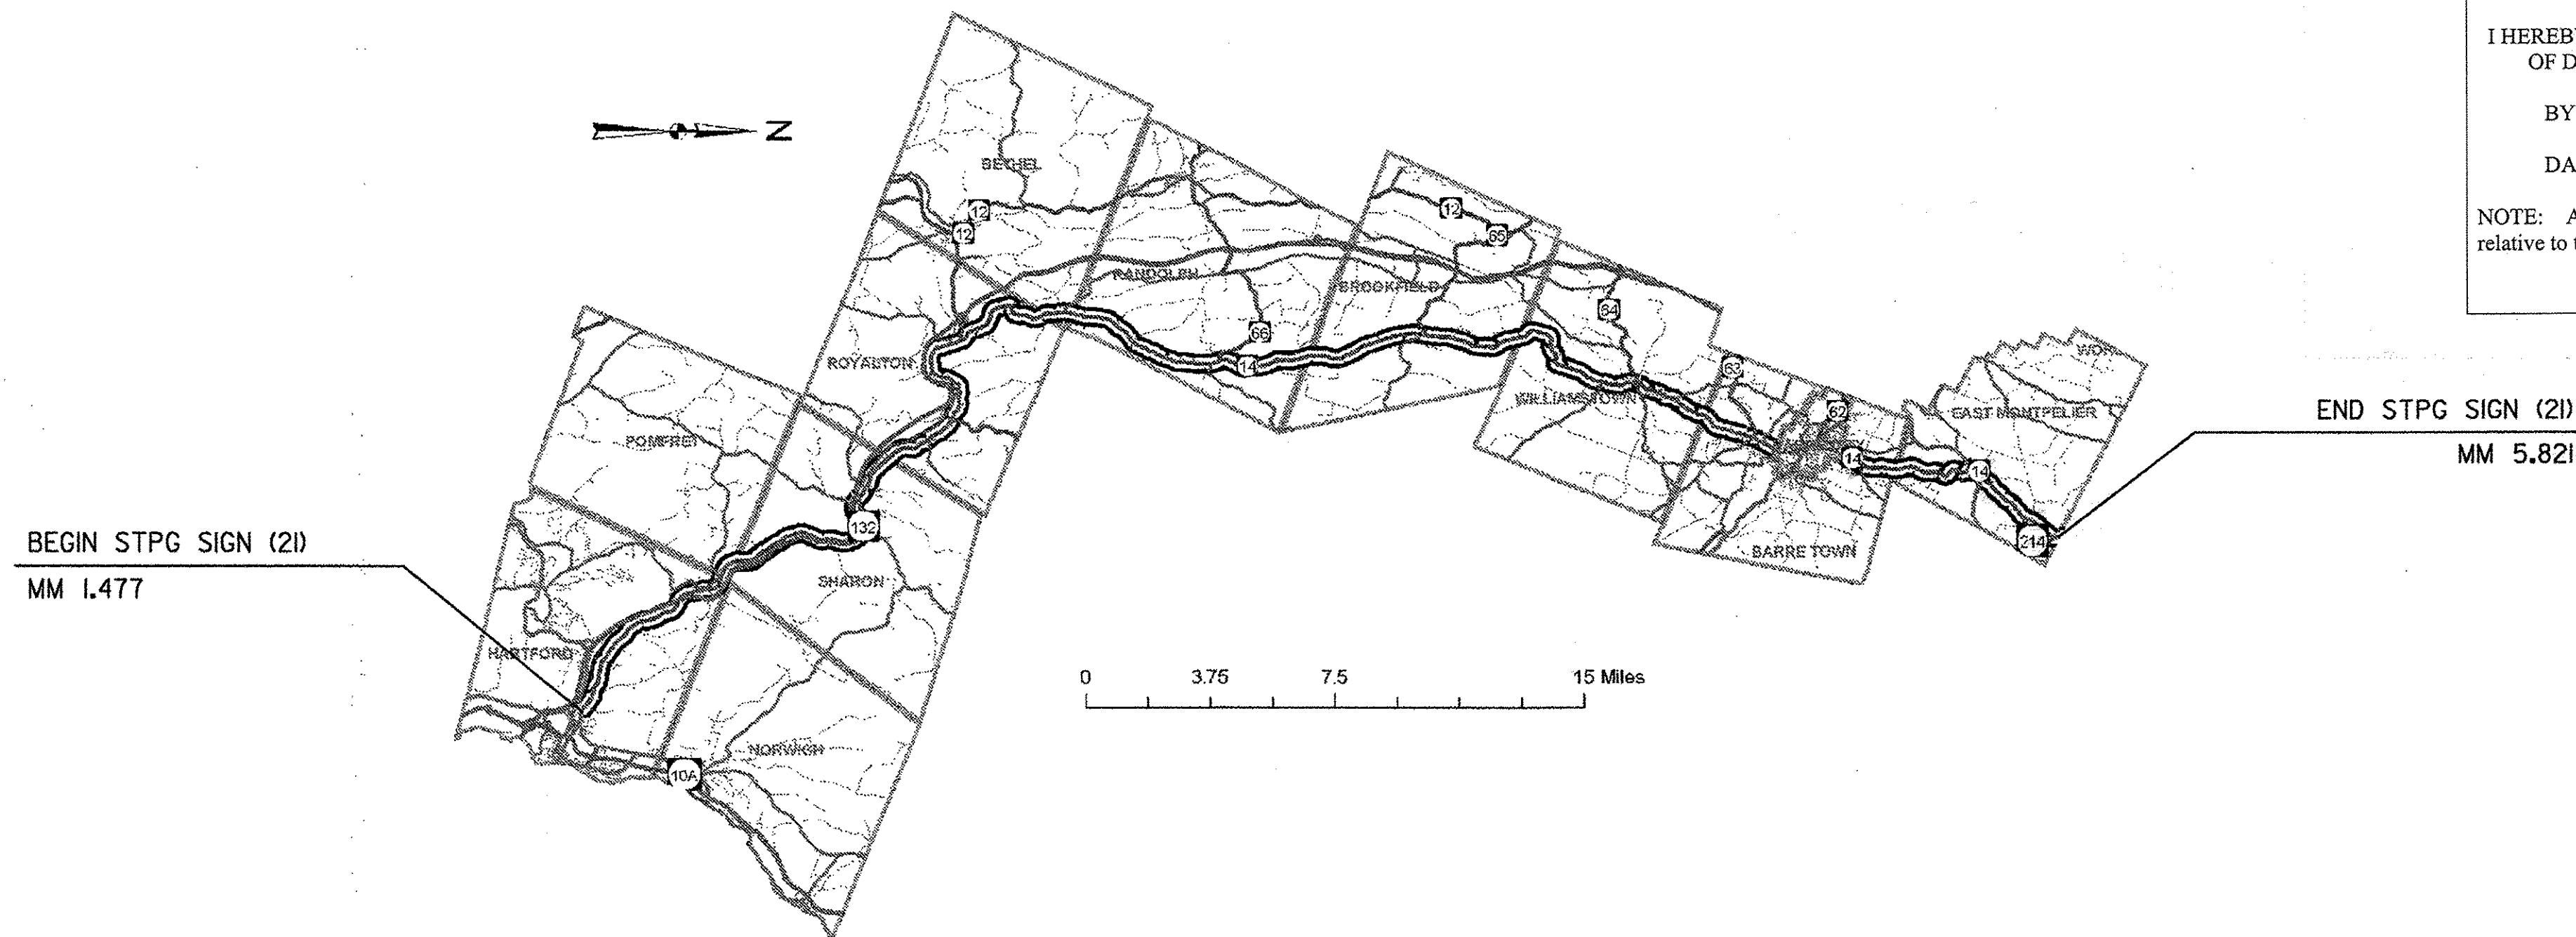

CONVENTIONAL SYMBOLS	
COUNTY LINE	
TOWN LINE	
LIMITS OF ACCESS	
POINT OF ACCESS	
FENCE LINE	
STONE WALL	
TRAVELED WAY	
GUARD RAIL	
RAILROAD	
SURVEY LINE	
CULVERT	
POWER POLE	
TELEPHONE POLE	
TREES	
CONTROL OF ACCESS	
PROPERTY LINE	
R.O.W. TAKING LINE	
SLOPE RIGHTS	
TOP OF CUT	
TOE OF SLOPE	

SURVEYED BY : N/A
SURVEYED DATE : N/A

DATUM
VERTICAL N/A
HORIZONTAL N/A

THESE PLANS ARE SUBJECT TO SUCH ENGINEERING CHANGES AS MAY BE REQUIRED BY THE FEDERAL HIGHWAY ADMINISTRATION OR THE DIRECTOR OF PROGRAM DEVELOPMENT.
CONSTRUCTION IS TO BE CARRIED ON IN ACCORDANCE WITH THESE PLANS AND THE STANDARD SPECIFICATIONS FOR CONSTRUCTION DATED 2006, AS APPROVED BY THE FEDERAL HIGHWAY ADMINISTRATION ON JUNE 15, 2006 FOR USE ON THIS PROJECT, INCLUDING ALL SUBSEQUENT REVISIONS AND SUCH REVISED SPECIFICATIONS AND SPECIAL PROVISIONS AS ARE INCORPORATED IN THESE PLANS.

DIRECTOR OF PROGRAM DEVELOPMENT	
APPROVED <i>Paul K. Perry</i>	DATE 6-15-09
PROJECT MANAGER :	AMY GAMBLE
PROJECT NAME :	HARTFORD - EAST MONTPELIER
PROJECT NUMBER :	STPG SIGN (21)
SHEET 1 OF 162 SHEETS	