






D1-1

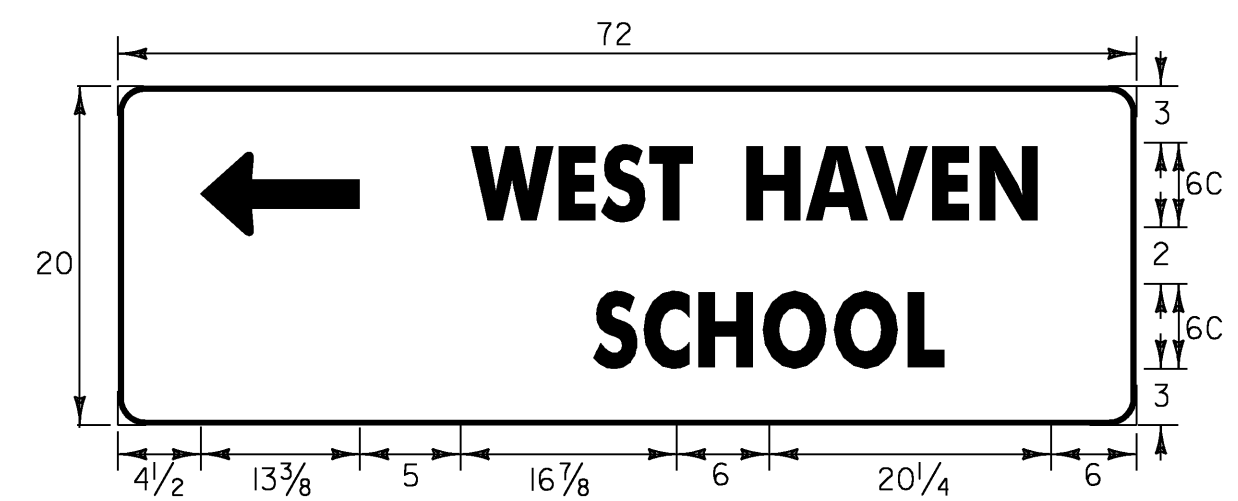


D1-2 (L)

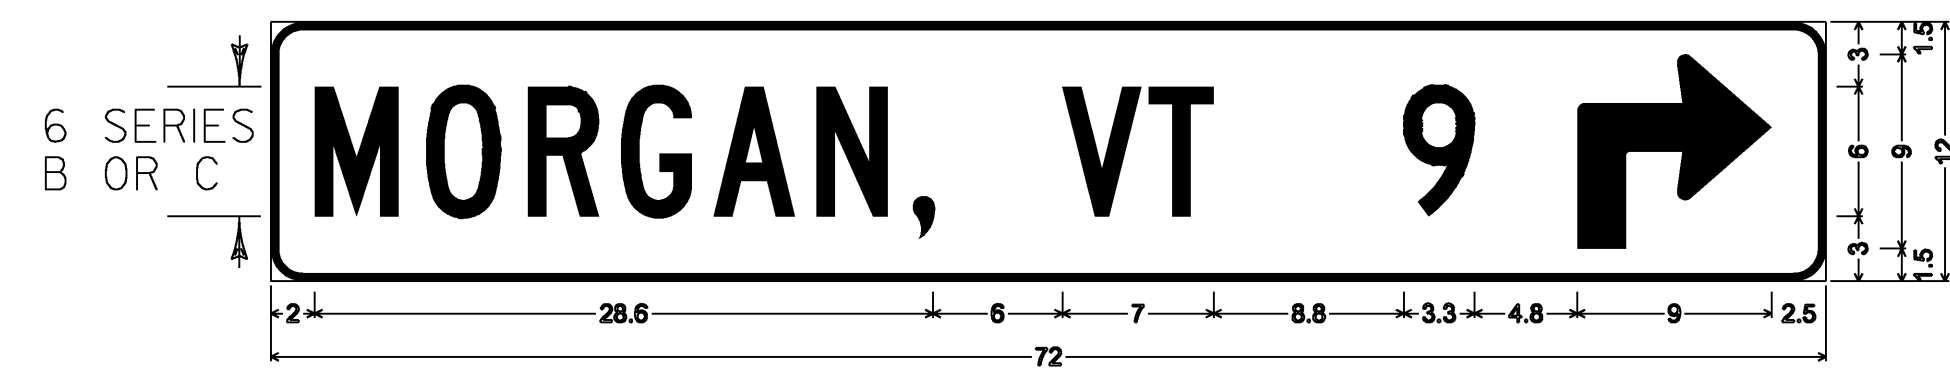


D1-1A

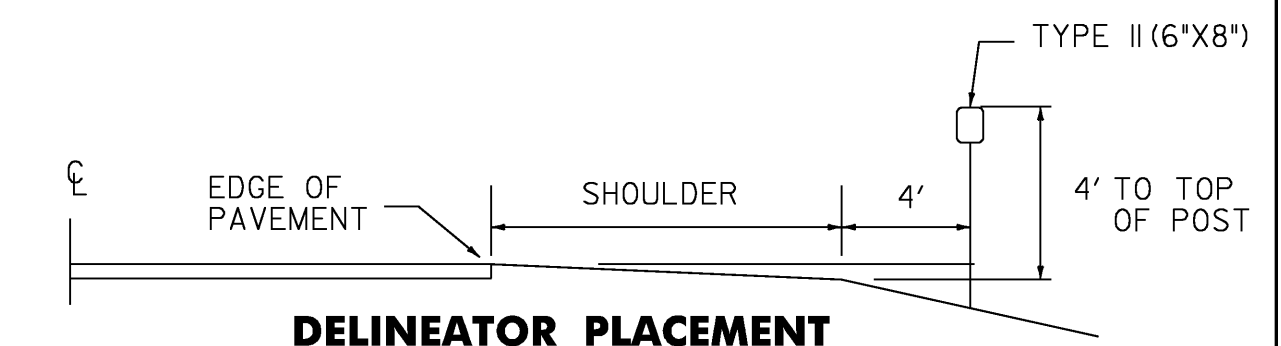


DELINEATOR PLACEMENT

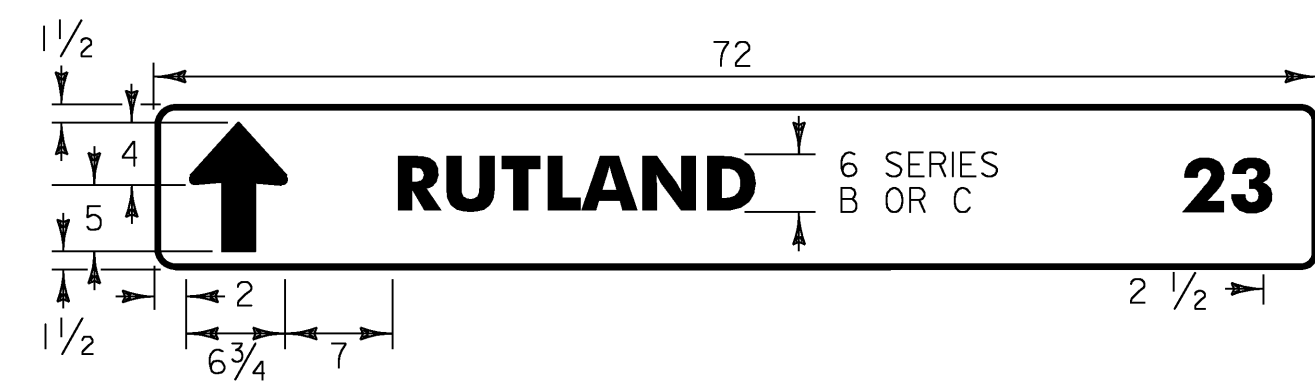


D1-1A

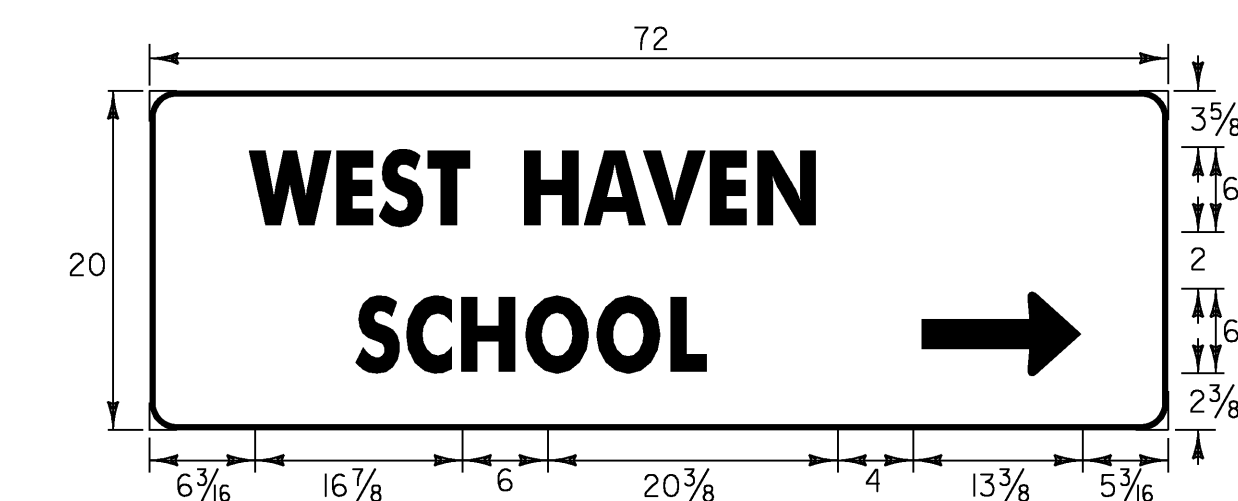

D1-2 (R)

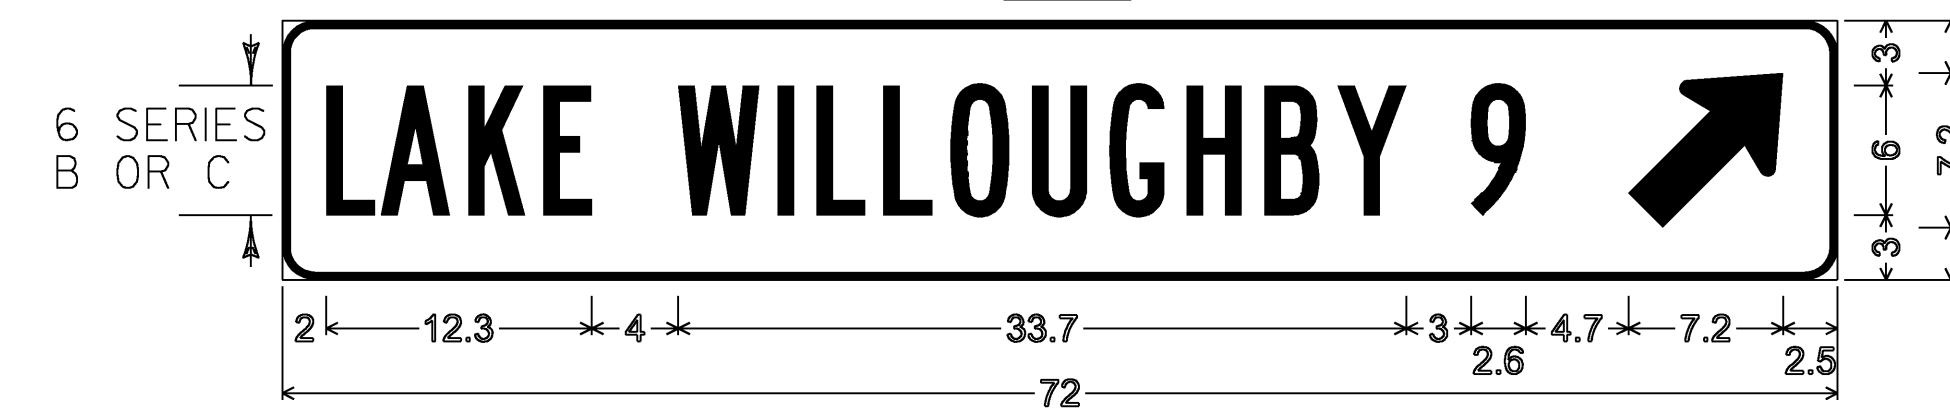

D1-1A

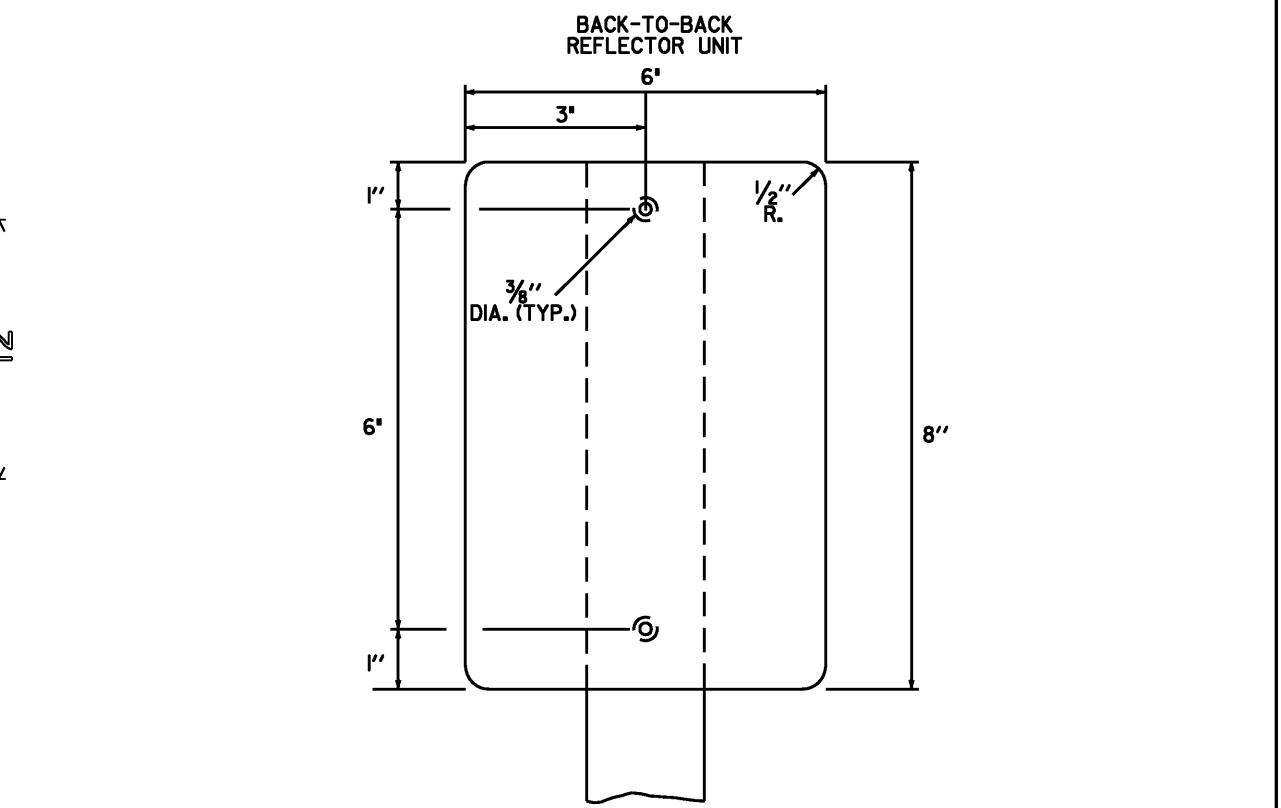


TYPE II (6'x8')

DELINEATORS WITH REFLECTIVE SHEETING

MATERIAL FOR RETROREFLECTIVE SHEETING FOR DELINEATORS SHALL BE A 0.063" ALUMINUM BACKING WITH A WHITE ASTM TYPE III OR TYPE IV.




D1-1A

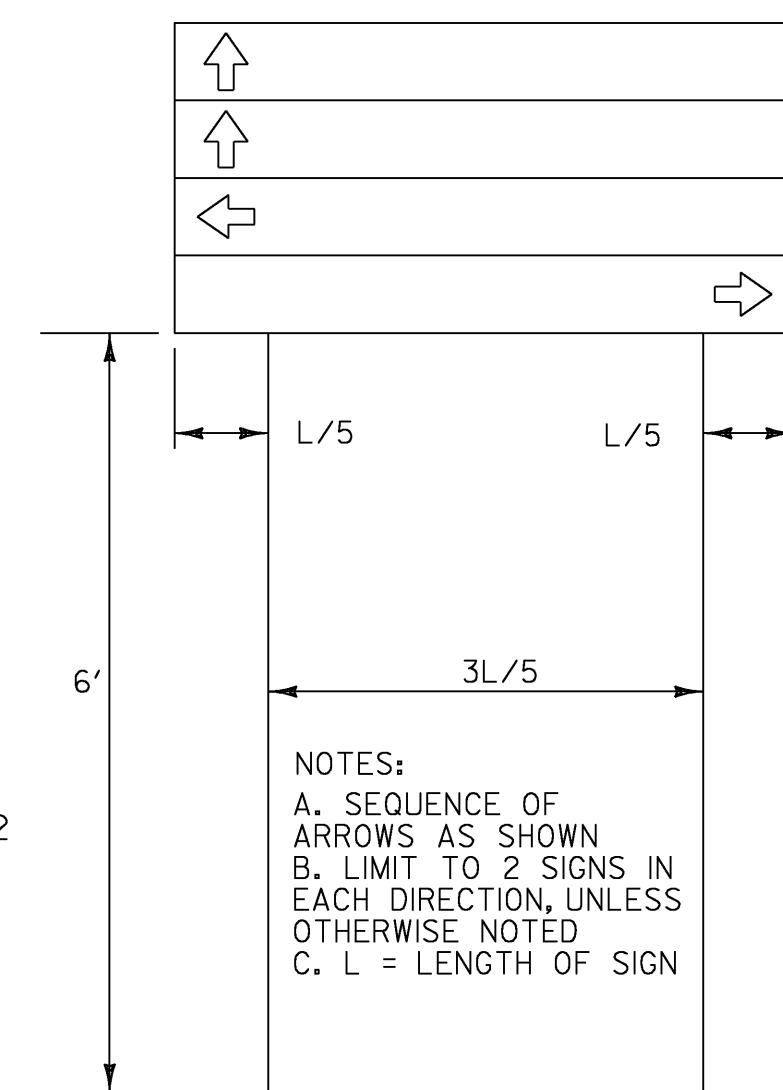


DESTINATION ASSEMBLY


NOTES:
A. SEQUENCE OF ARROWS AS SHOWN
B. LIMIT TO 2 SIGNS IN EACH DIRECTION, UNLESS OTHERWISE NOTED
C. L = LENGTH OF SIGN

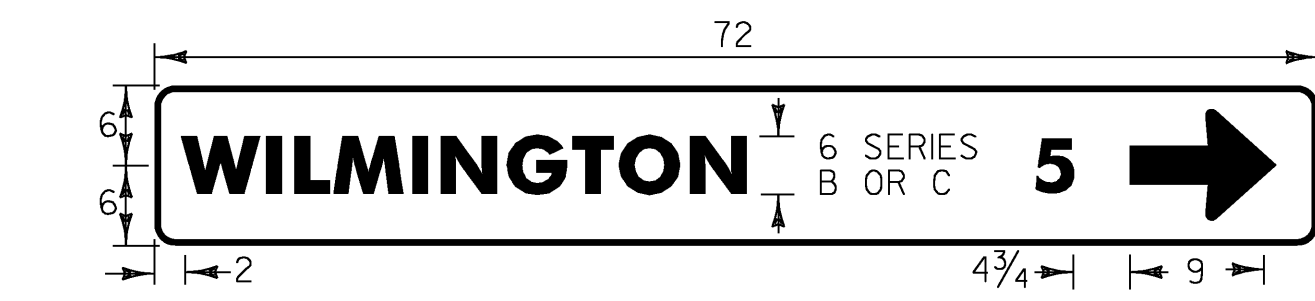


D1-1A

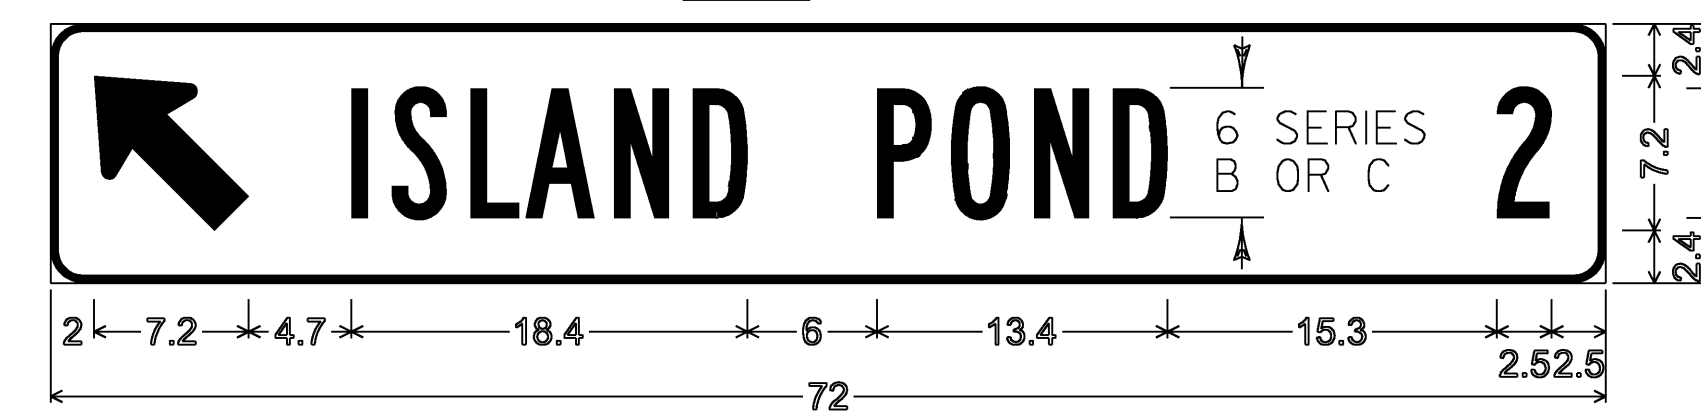


D1-1A

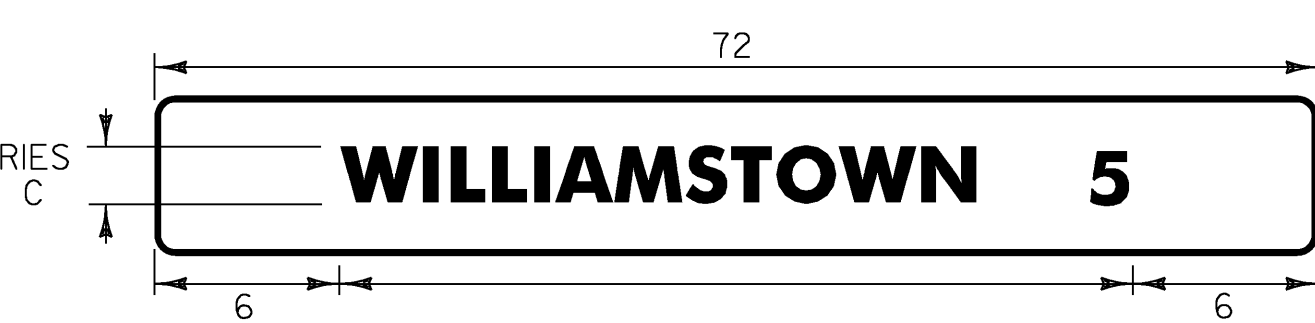

D2-1

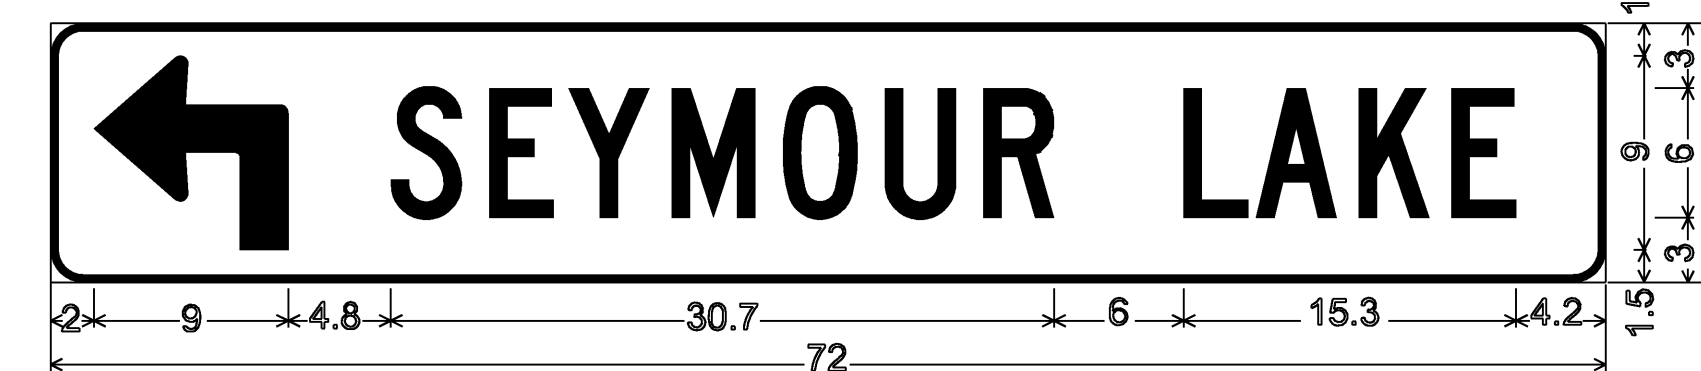

D1-1

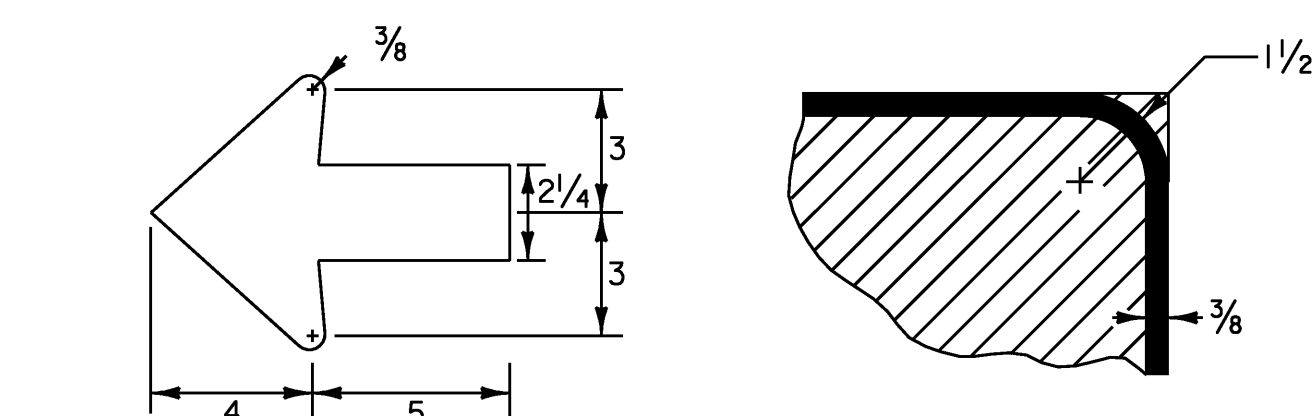


STANDARD ARROW

BORDER DETAIL


**STANDARD DESTINATION SIGN NOTES
D1-1, D1-1A, D1-2, D2-1**

- ALL SIGNS SHALL BE IN ACCORDANCE WITH THE MUTCD AND THE "STANDARD HIGHWAY SIGNS" BOOK (SHS) PUBLISHED BY THE FEDERAL HIGHWAY ADMINISTRATION (FHWA).
- THE SIGN BASE MATERIAL FOR STANDARD DESTINATION SIGNS SHALL BE HIGH DENSITY OVERLAYED PLYWOOD 5/8 INCH THICK OR FLAT SHEET ALUMINUM 1/8 INCH THICK.
- THE DESTINATION SIGNS SHOWN ON THIS SHEET SHALL HAVE WHITE RETROREFLECTIVE ASTM TYPE III TEXT, ARROWS AND BORDERS ON A GREEN RETROREFLECTIVE ASTM TYPE III BACKGROUND. THE COLORS SHALL CONFORM WITH THE COLORS ADOPTED BY AASHTO AND APPROVED BY THE FHWA.
- MULTIPLE ASSEMBLIES SHALL USE THE SAME SIZE THROUGHOUT. DO NOT MIX AND MATCH OLDER SIGN SIZES WITH NEW SIGN HEIGHTS AND WIDTHS.
- ALL DIMENSIONS SHOWN IN INCHES EXCEPT WHERE NOTED.

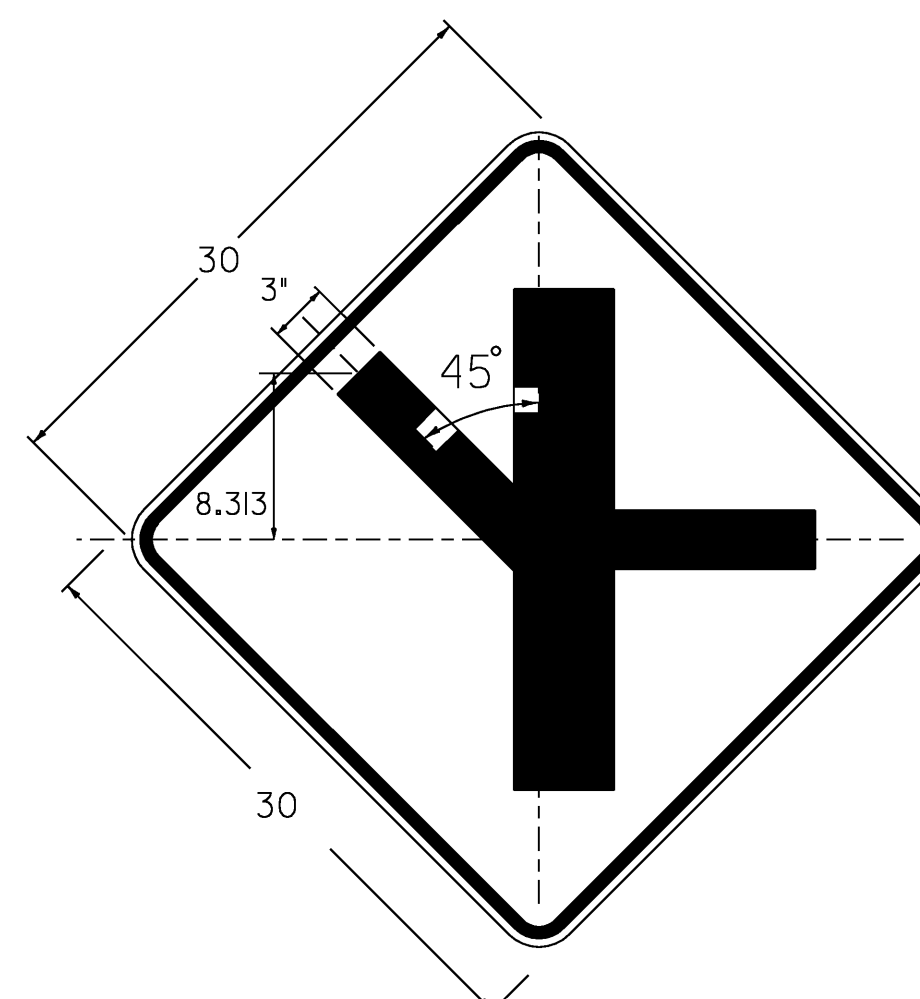

W2-1MJ L(R)

DIMENSIONS NOT SHOWN FOR THIS DETAIL SHALL CONFORM TO THE LATEST EDITION OF THE 2003 MUTCD FOR SIGN DETAIL W1-1. UNLESS OTHERWISE NOTED FOR THIS DETAIL

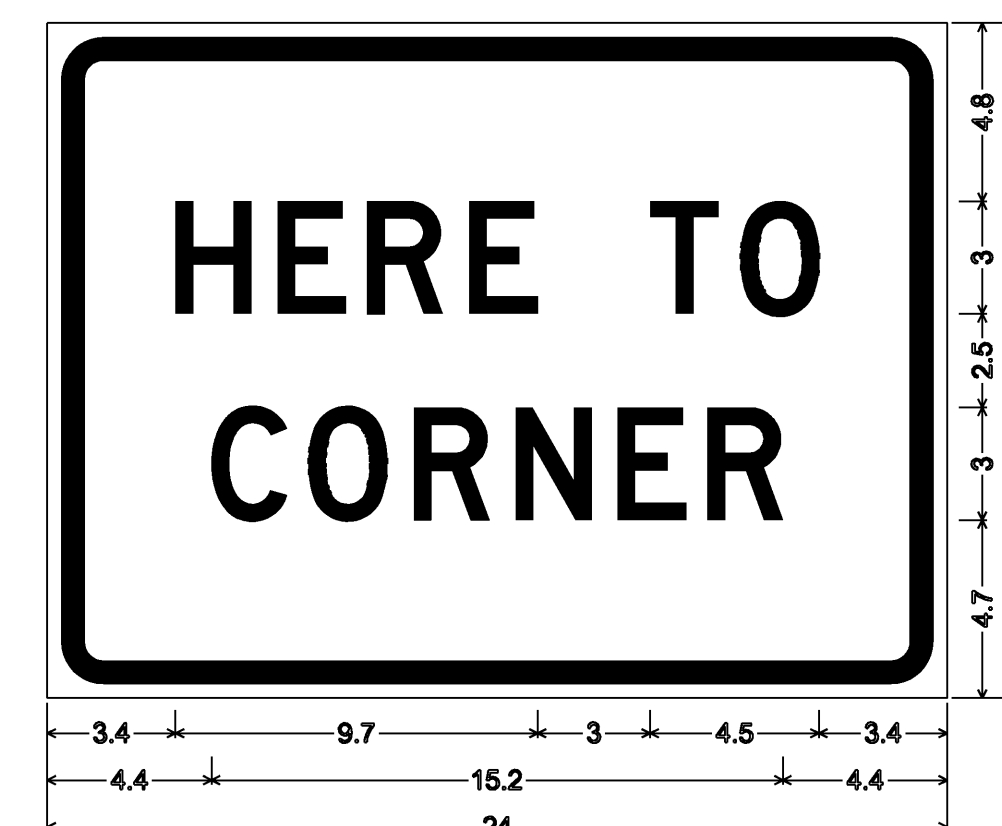

VR-345p

1.5" RADIUS, 0.625" BORDER, 0.375" INDENT
COLORS: LEGEND - RED
BACKGROUND - WHITE
TEXT STYLE: "HERE TO"; "CORNER" D

PROJECT NAME: HARTFORD - EAST MONTPELIER	PLOT DATE: 11-JUN-2009
PROJECT NUMBER: STPG SIGN (21)	DRAWN BY: N. AVERY
FILE NAME: 09c024_TS.DGN	CHECKED BY: A. GAMBLE
PROJECT LEADER: N. AVERY	SHEET 5 OF 162
DESIGNED BY: N. AVERY	
SIGN DETAILS 1	