
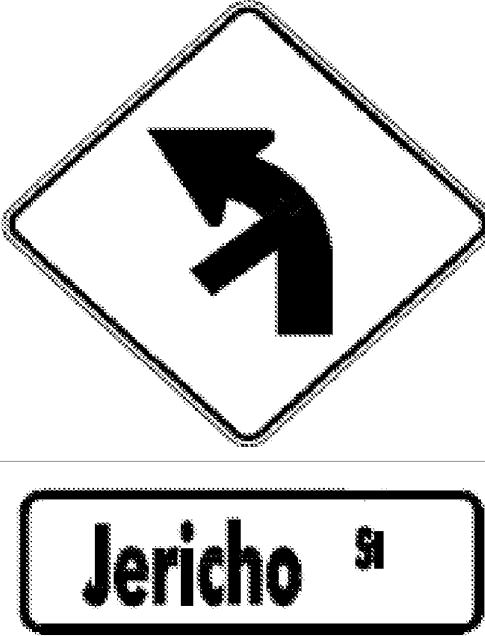


DIRECTION	MILEPOINT	LOCATION CODE (SHEET 2)	SIGN CODE	WIDTH (IN)	HEIGHT (IN)	SHEETING REMARKS	SIGN LEGEND FOR ALL POST LENGTHS AND INSTALLATION DATES SEE ORIGINAL RECORD PLANS	NEW SIGNS		EXISTING SIGNS				EXIST POST		NUMBER OF NEW POSTS	SQUARE STEEL (IN) (LB / FT)			TUBULAR STEEL Ø (IN) (LB / FT)				SIGN FRAME REQUIRED	REMARKS	SIGN DETAIL			
								"A"	"B"	RETAIN	SALVAGE FROM	SALVAGE TO	REMOVE	RETAIN	REMOVE		1.75	2.00	2.50	FOUNDATION	3.00	3.50	4.00			5.00	DETAIL IN SHS	DETAIL ON SHEET NUMBER	DETAIL ON STD SHEET NUMBER
HARTFORD VT 14							FY-FLUORESCENT YELLOW FYG-FLUORESCENT YELLOW GREEN															"SHS"-STANDARD HIGHWAY SIGNS							
SB	6.378	F	S3-1	30	30																								
		F	S3-1	30	30			6.25																X					
SB	5.970	F	W1-2R	30	30		RIGHT CURVE			1																			
SB	5.940	F	W1-2R	30	30		RIGHT CURVE	6.25			1	1																	
SB	4.940	F	W1-10L	30	30		MODIFIED LEFT CURVE					0																	
		F	W16-8A	30	10							0																	
		F	W1-2MbL	30	30			6.25																	6				
		F	W16-8A	24	8			1.33																	7				
SB	4.610	F	W1-2L	30	30		LEFT CURVE	6.25		1		1																	
		F	W13-1	24	24		40 MPH PLAQUE			1																			
SB	4.471	F	W1-6	48	24		<=== LEFT LARGE ARROW	8.00			1	1	1																
		E	W1-6	48	24		RIGHT ===> LARGE ARROW				1	1																	
SB	4.436	F	W1-6	48	24		<=== LEFT LARGE ARROW	8.00			1	1	1																
SB	3.992	F	W2-2L	30	30		LEFT SIDE ROAD	6.25		1																			
		F	W16-8A	30	10							1																	
SIGN SUMMARY SHEET							SHEET TOTALS	48.58 43.33	0.00	3	4	4	5 4	0	0	7	105					PROJECT NAME: Hartford-East Montpelier VT14							
VERMONT AGENCY OF TRANSPORTATION							TOWN TOTALS	130.2	0.0	41.0	13.0	9.0	26	0.0	0.0	26	390.0					PROJECT NUMBER: STPG SIGN(21)							
								SF	SF	EA	EA	EA	EA	EA	EA	EA	FT					FILE NAME: Hartford.xls	PLOT DATE: 6/10/2009						
																						PROJECT MANAGER: N. Avery	DRAWN BY: I. Shea						
																						DESIGNED BY: D. Crosslev	CHECKED BY: S. Menard						
																						HARTFORD SHEET 7	SHEET 14	OF 162					